


THIS DRAWING IS THE PROPERTY OF
Messrs. J. S. DOIG (CRIM) & CO. LTD.
AND IS A CONFIDENTIAL DOCUMENT.
IT MUST NOT BE TRACED, COPIED OR
EXHIBITED TO ANY THIRD PARTY
WITHOUT PERMISSION IN WRITING.

A circular ink stamp from the J.S. DOIG GRIMSEY & CO. LTD. SHIPYARD DRAINING BRIDGE. The stamp is dated 22 JULY 1944. At the bottom, it reads GRIMSEY DOUGLAS ENGINEERS & SHIPBUILDERS. The stamp is slightly faded and has a textured background.

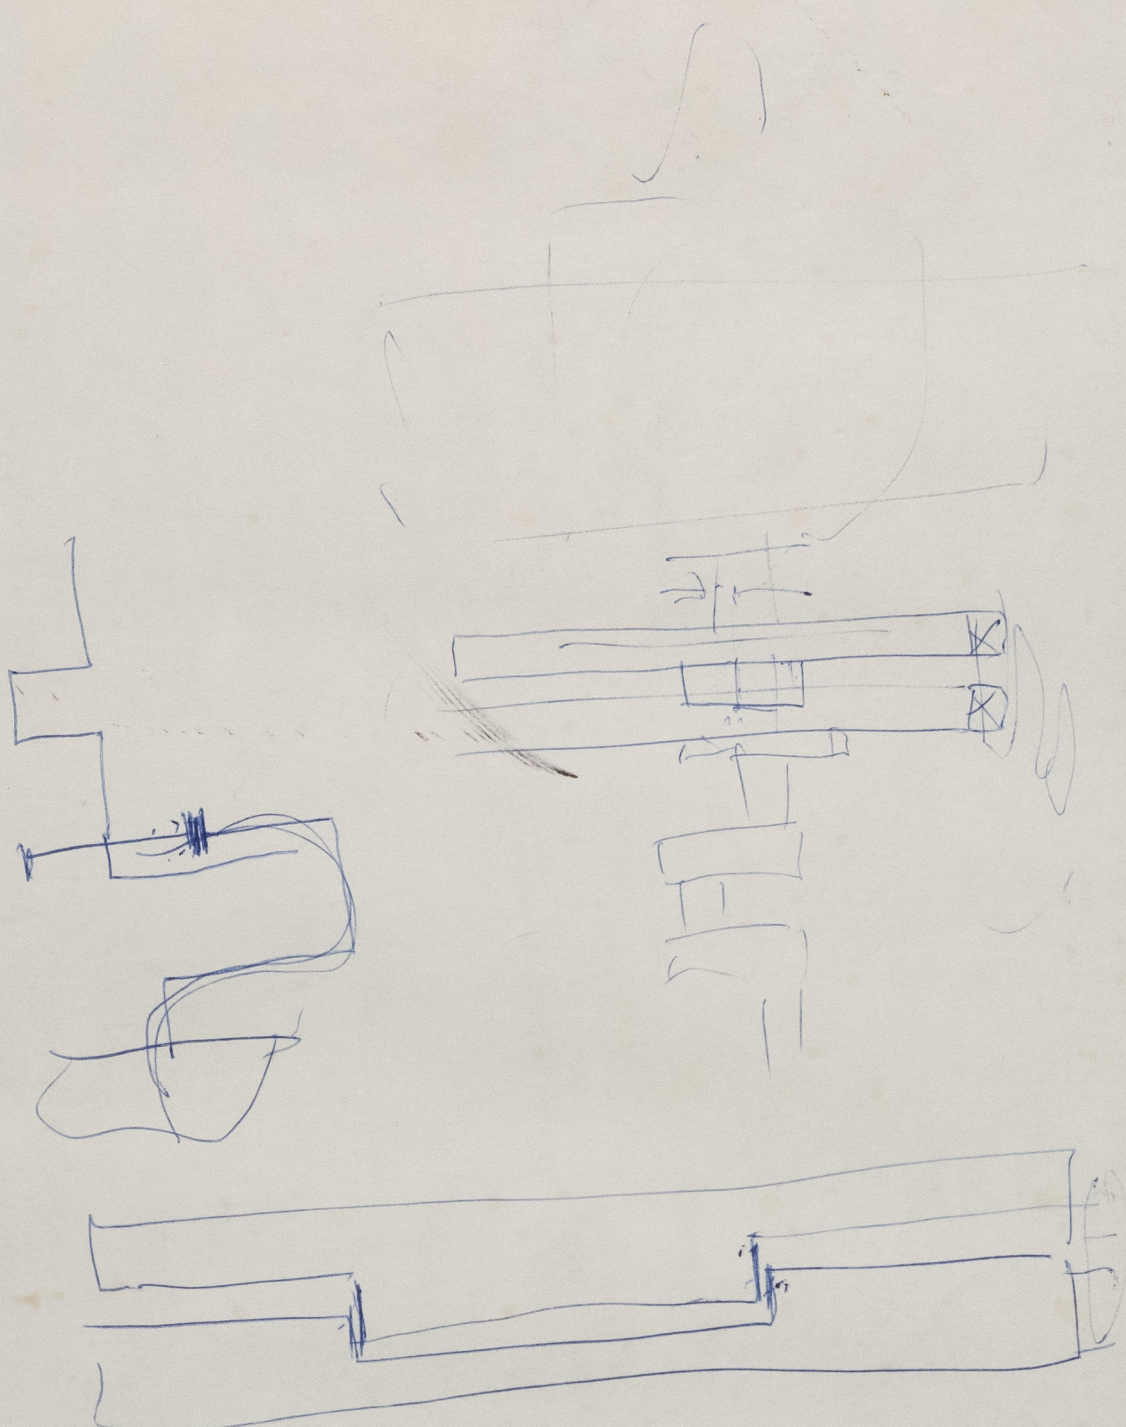

"ATLANTIC DOLPHIN" ★

①

PROFILE & DECKS

"As Built"

RECORDS DEPT.,
LONDON.

④

J. S. Doig Yrd No. 69

GRIMSBY F. E. Rpt No 29785



© 2021
Lloyd's Register
Foundation
013497-013507-0105