



UNITED ONE  
350 TONS SEAGOING CARGO BARGE  
SCALE  $\frac{1}{8}" - \frac{1}{4}" = 1'$  (WELD REVECT CONSTR)  
GENERAL ARRANGEMENT  
AS BUILT

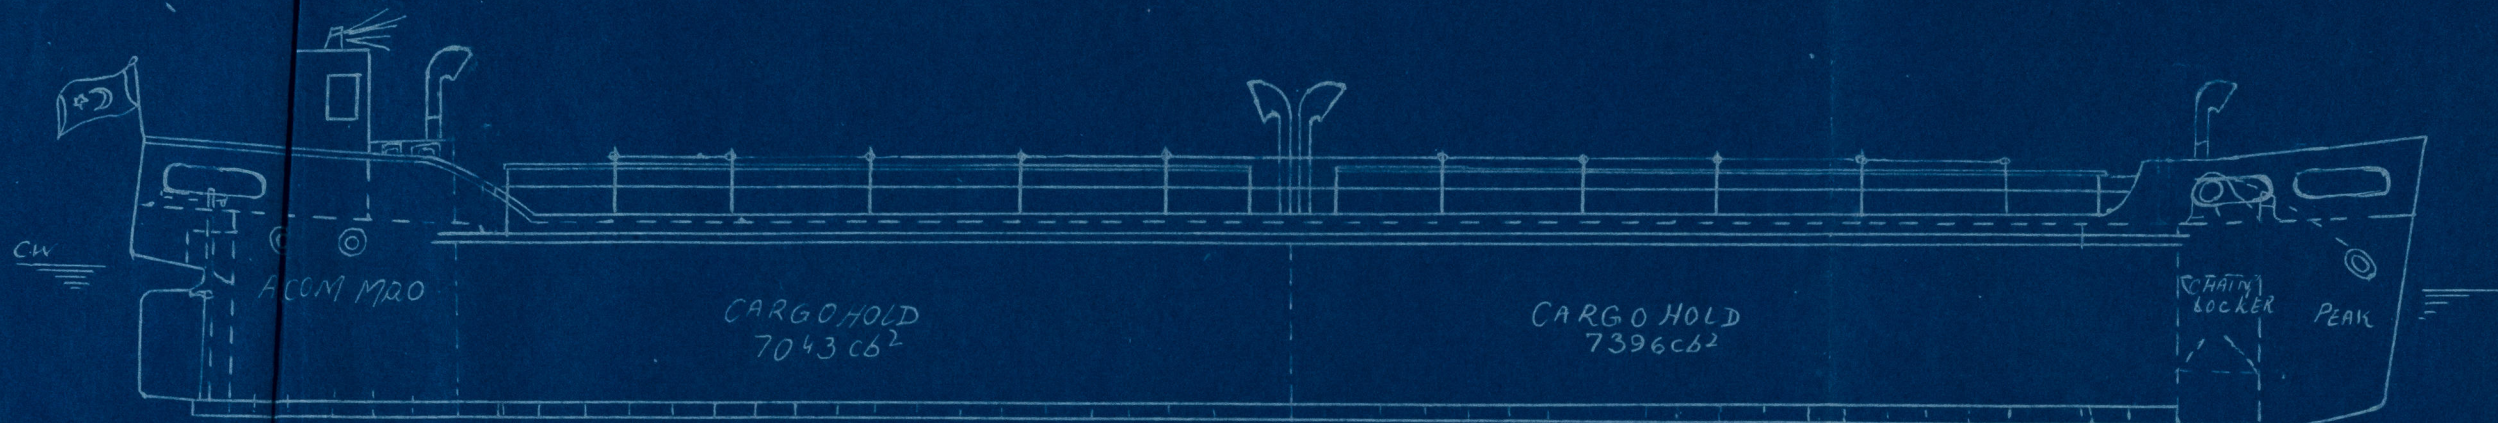

MAIN DIMENSIONS

LENGTH (PP 104'-0") OVER ALL -- 170' 0"  
BREADTH MOULDED ----- 24' 8"  
DEPTH - KEEL TO UPPERDECK - 9' 0"  
DRAUGHT WITH 350 ton CARGO --- 6' 11 1/2"  
DRAUGHT EMPTY  
DISPLACEMENT 460 TONS. (PER 1000 KG.)  
CARGO CAPACITY GRAIN 375 TONS IN CARGO HOLD  
BALE 250

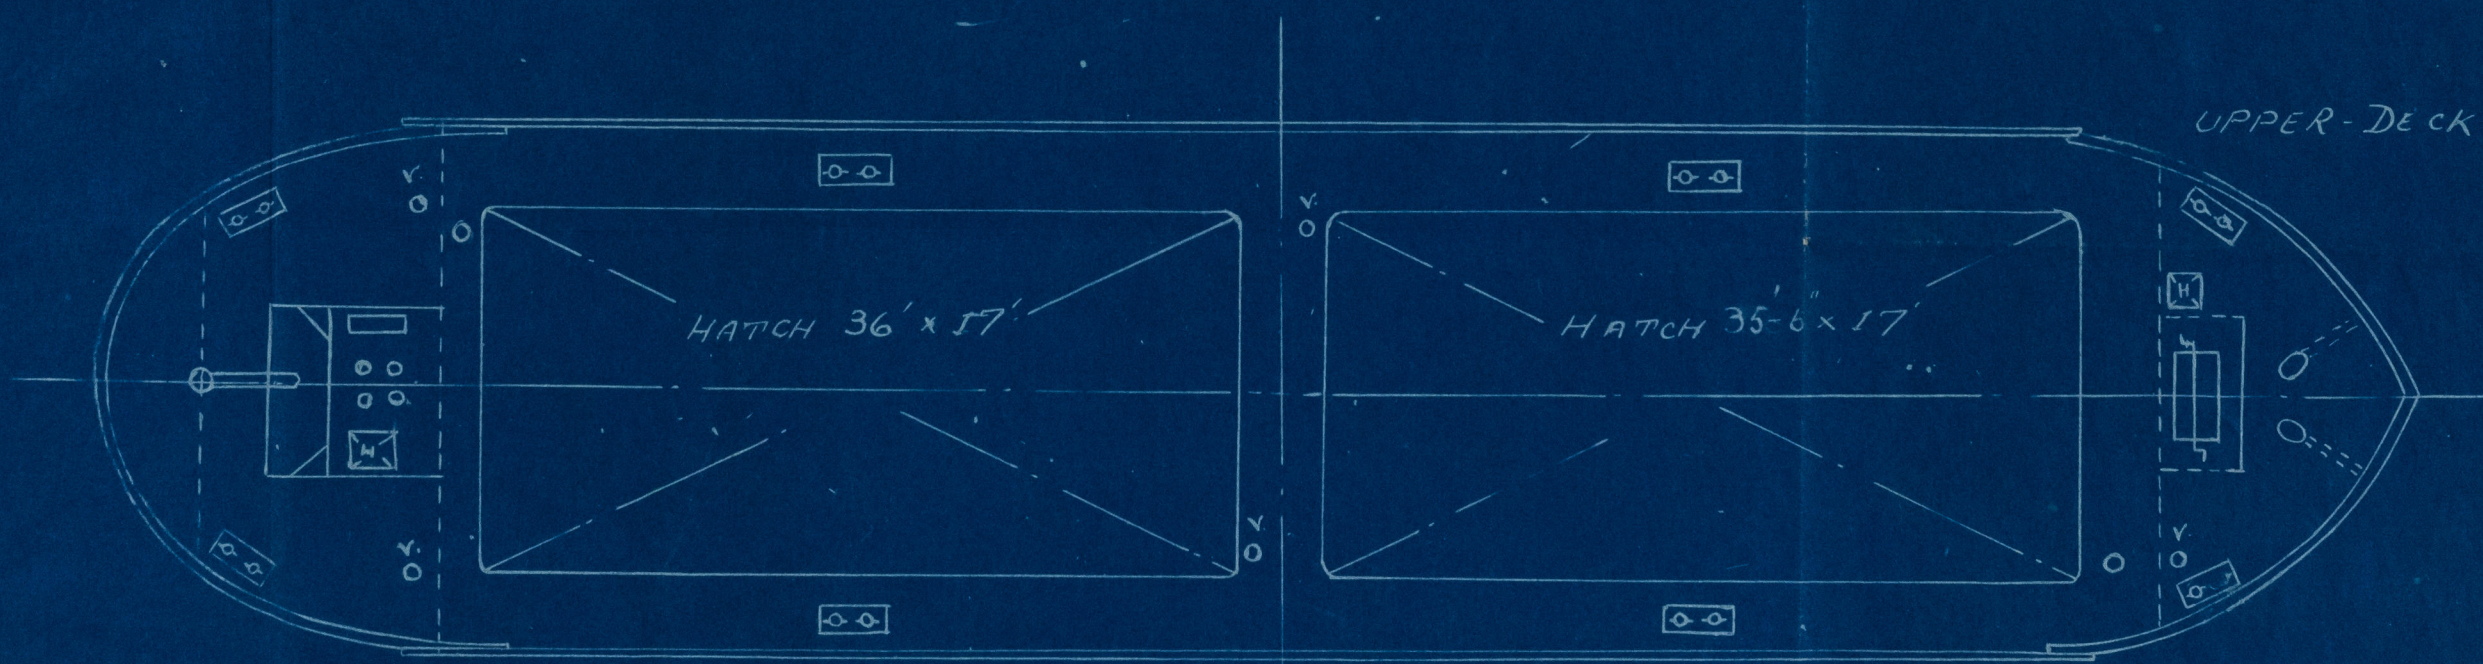

BUILDERS C & C LTD KARACHI.  
DATE OF BUILT  
YARD No. C & C LTD

A. Ghani  
13.4.64

013703-013718-0255