

BUILDERS N^o 158

DRAWING N^o 853

- MIDSHIP SECTION -

- STEEL SCREW STEAM COASTER -

135'-0" BP x 25'-0" MLD x 12'-0" MLD.

SCALE 1/2" = 1 FOOT.

TO CLASS LLOYDS 100 A1.

EQUIPMENT N^o 5455

BOWER ANCHORS: 9 CWT. 2 IN N^o STOCKLESS.

STREAM ANCHOR: 3 CWT. EX. STOCK

KEEL: 1 1/2" x 3/4" x 3/4" not supplied

STUD CHAIN CABLE: 1" 165 FATHOMS

STREAM 2 3/4" WIRE 4.5 "

TON LINE: 2 1/2" STEEL WIRE 7.5 " { 20 fathoms 11" GWS
55 " 2 1/2" S.W.R. } supplied

HAWSER: 5 1/2" COIR ROPE 90 " 3245 " 2" S.W.R. } supplied

NUMERALS

1ST N^o 37

2ND N^o 4995


DTH TO LENGTH: 11.25 TO UPPER DTH

" " " 9.0 TO R^{SD} QTH DTH

BRTH " 5.4

d: 10.65 TO UPPER DTH

d: 13.66 - R^{SD} QTH DTH

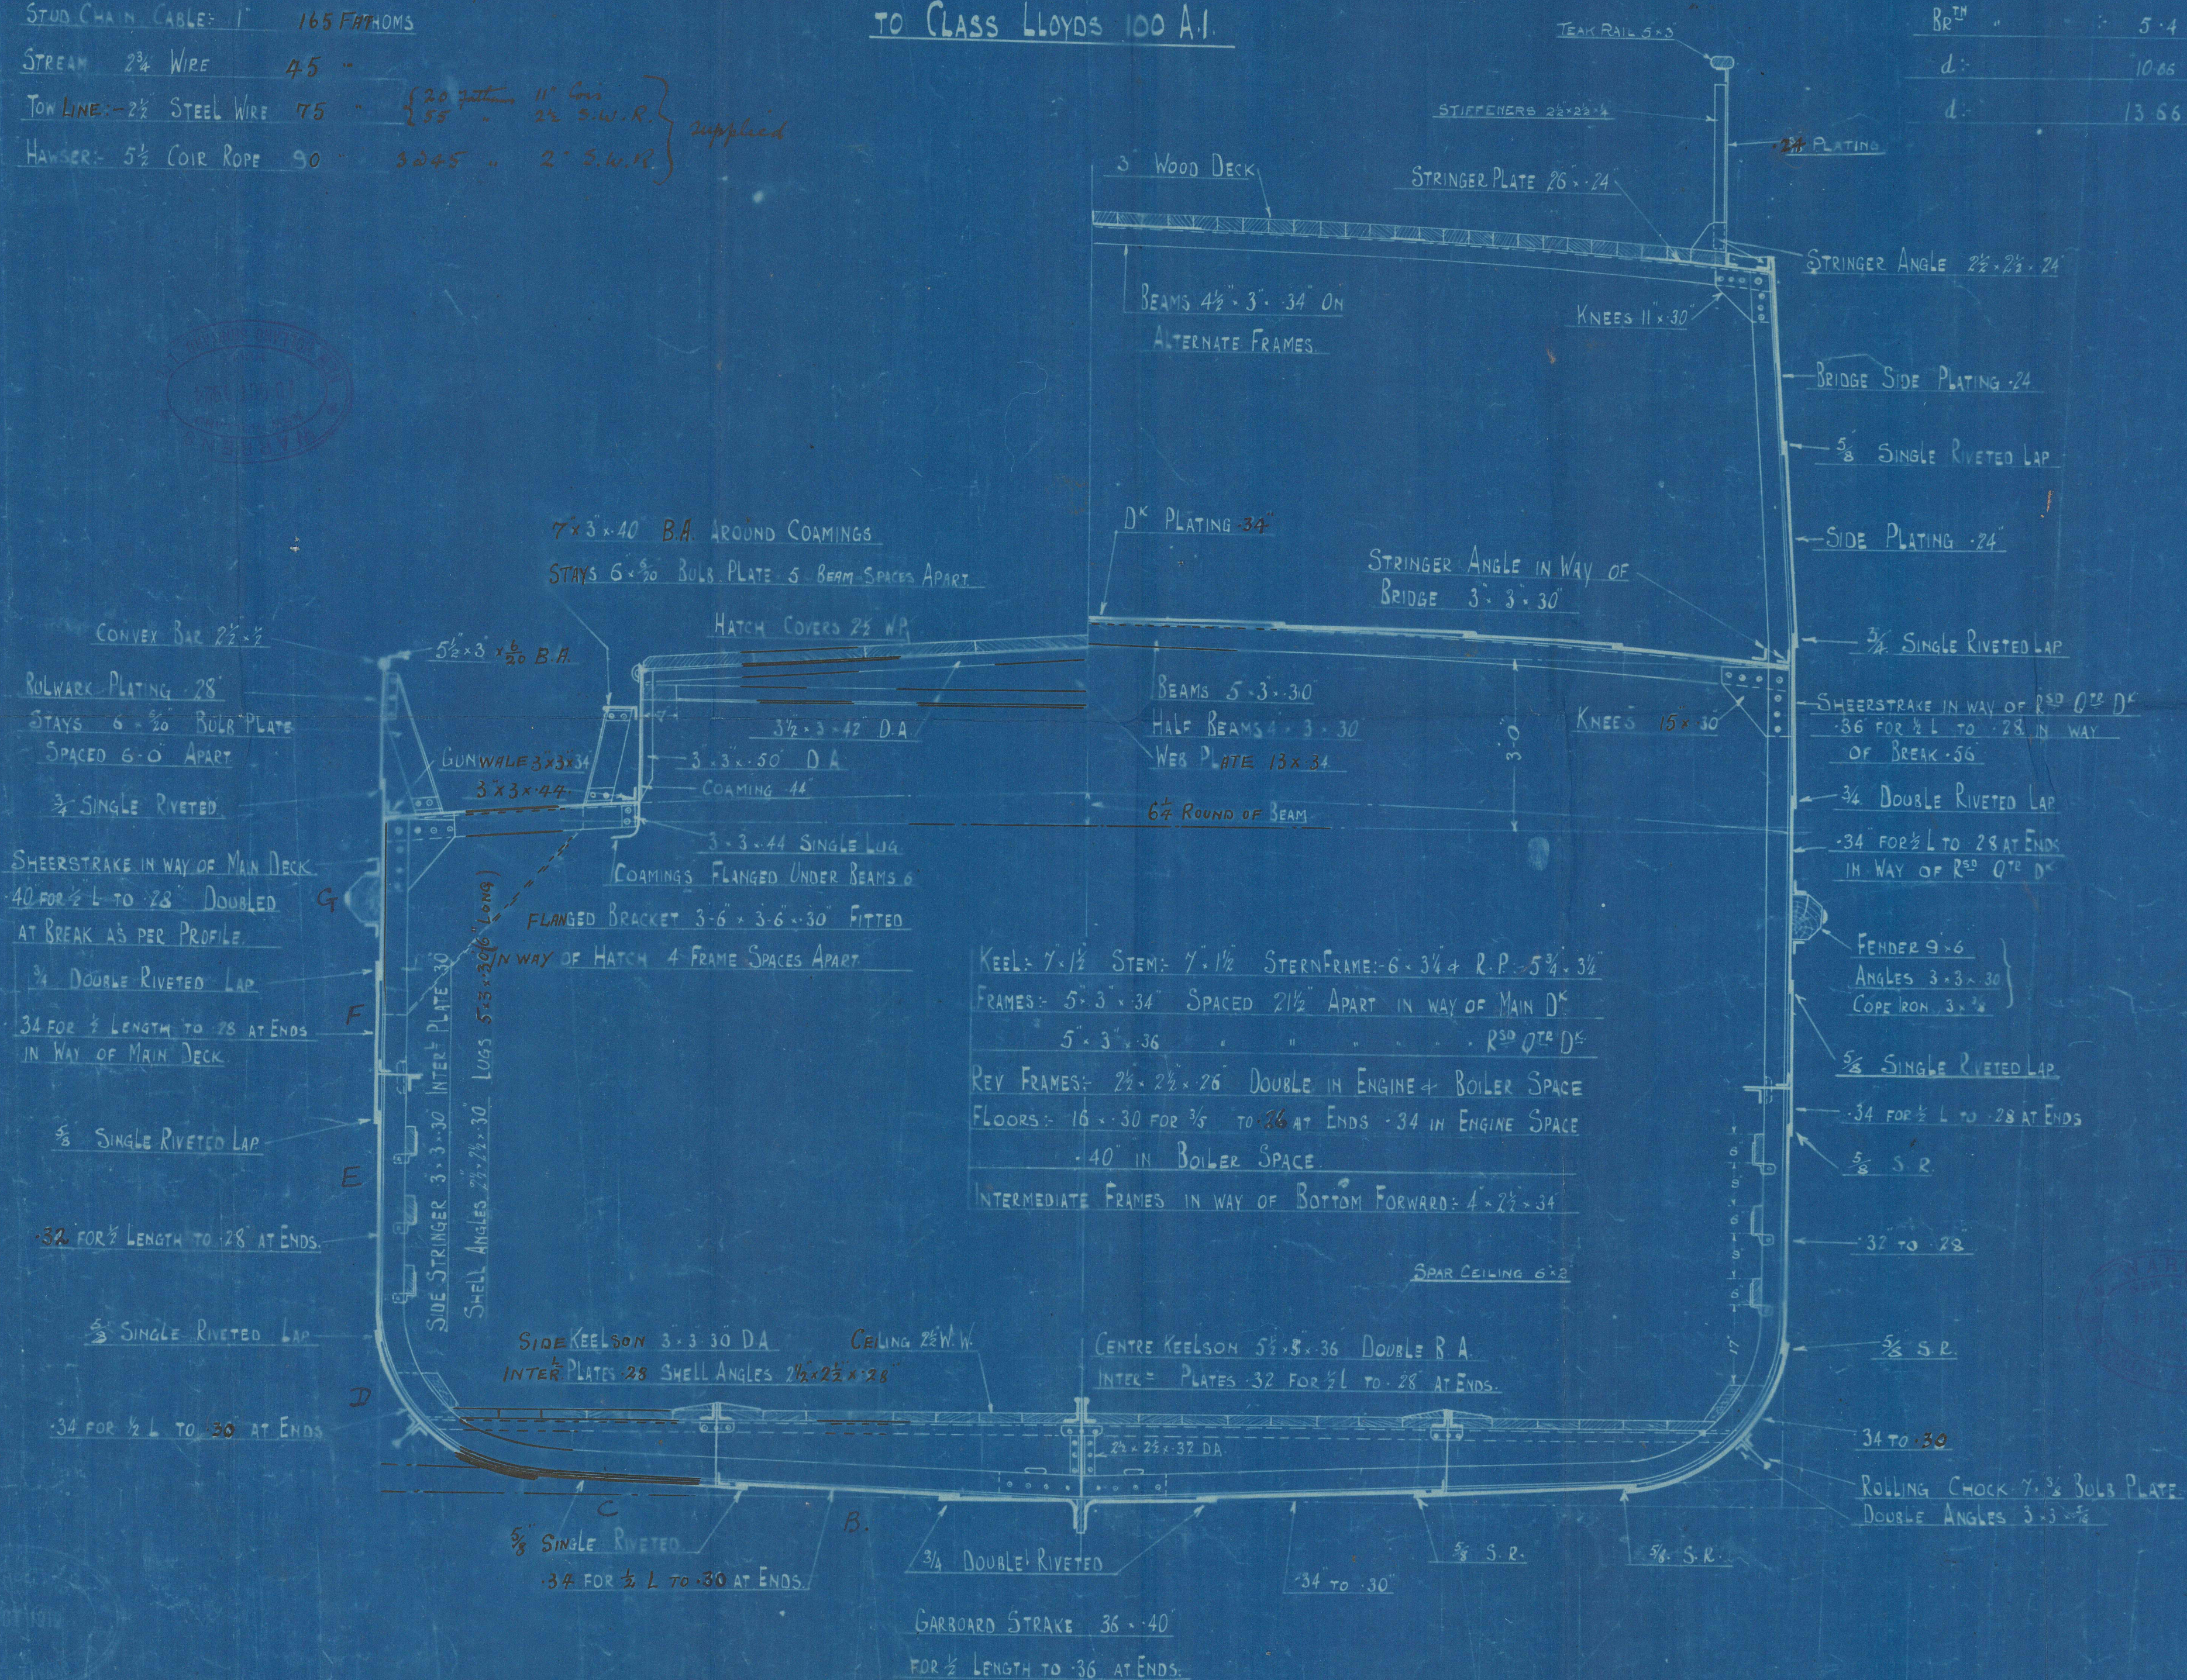

Warrens Ltd

New Holland

No 158

Midship Section

as built

5 Margaret Birch.
Hull Report No. 35574.

Totara



© 2021

Lloyd's Register
Foundation

014513-014530-0309