

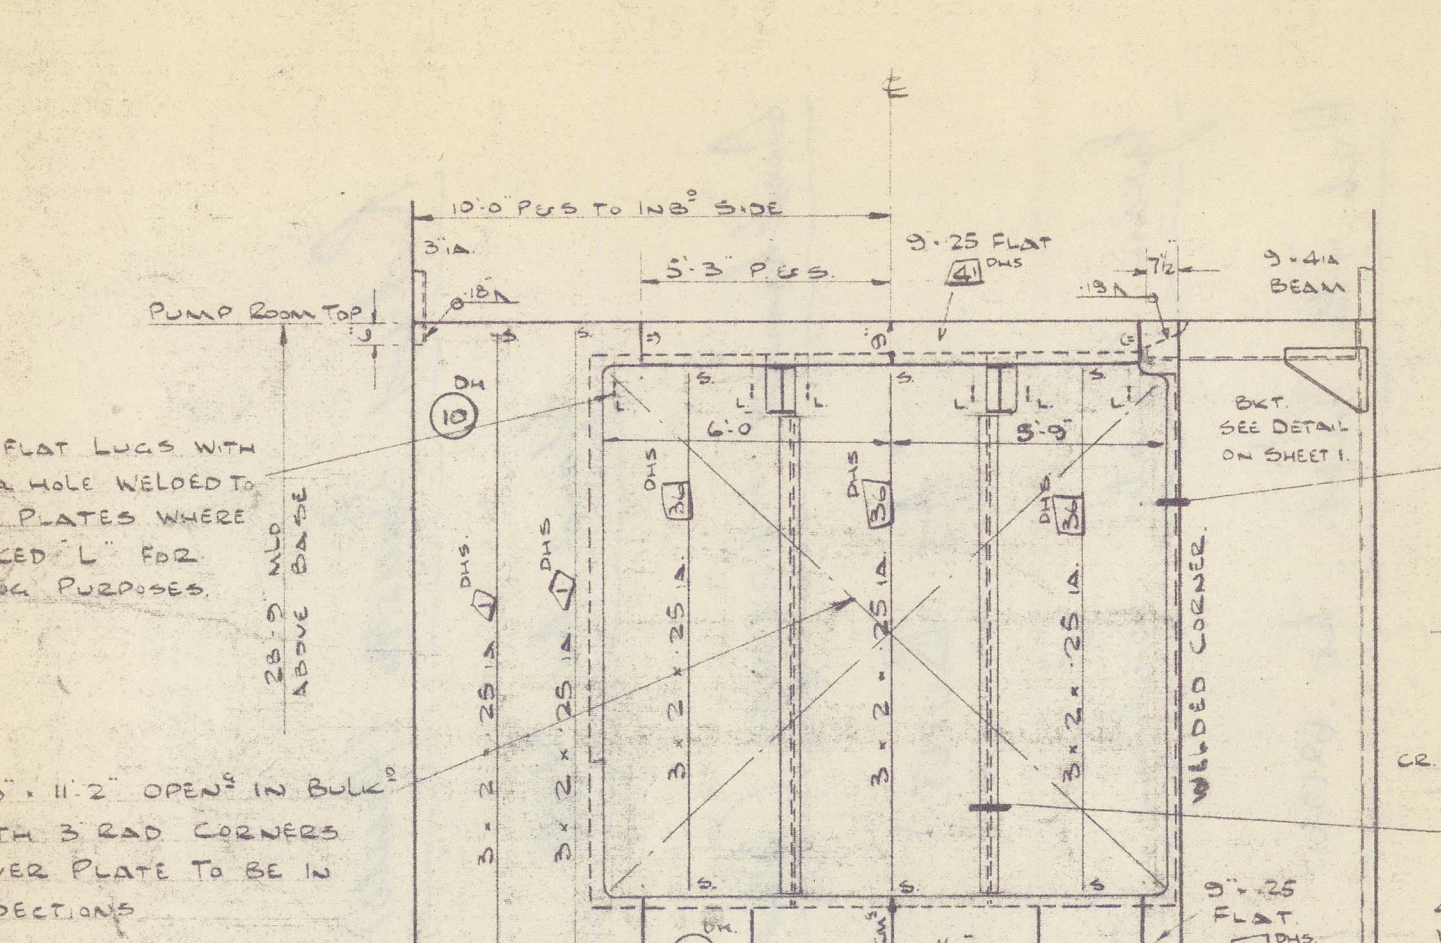
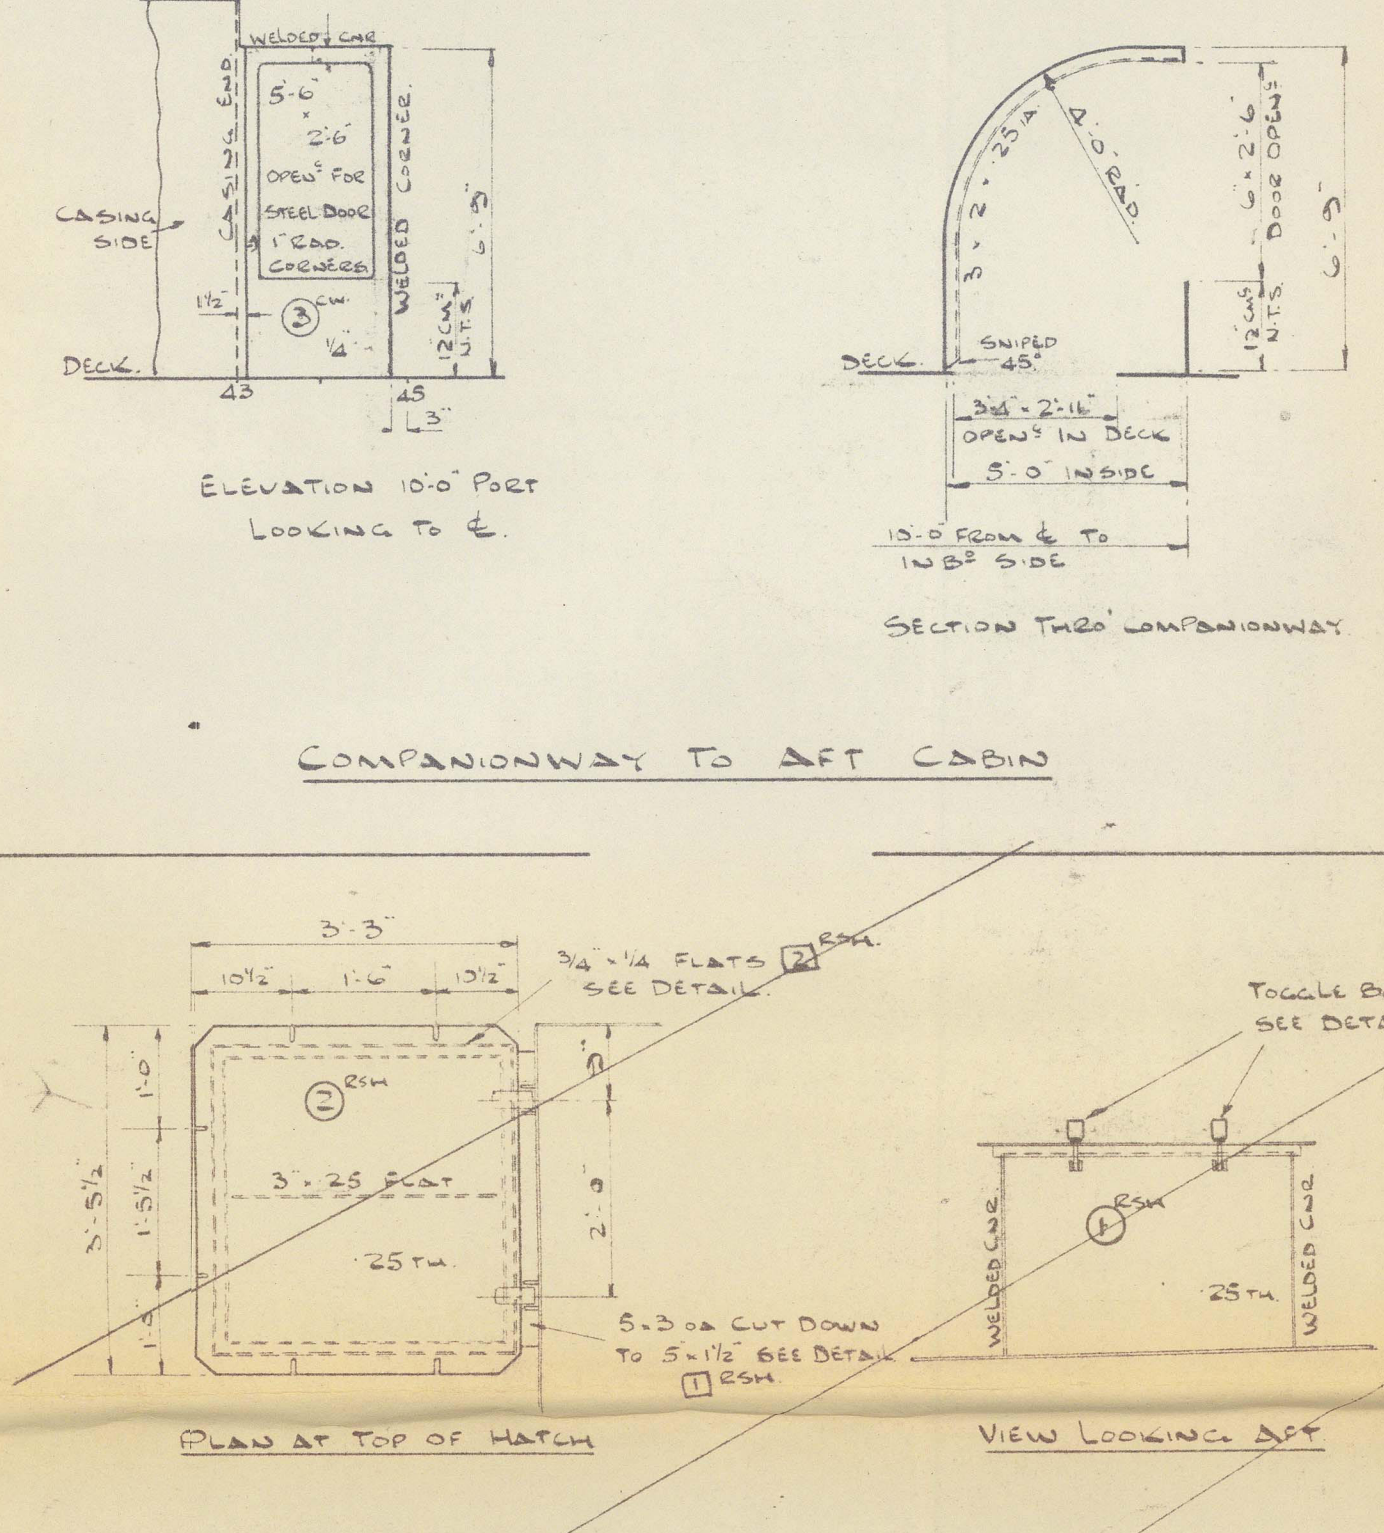
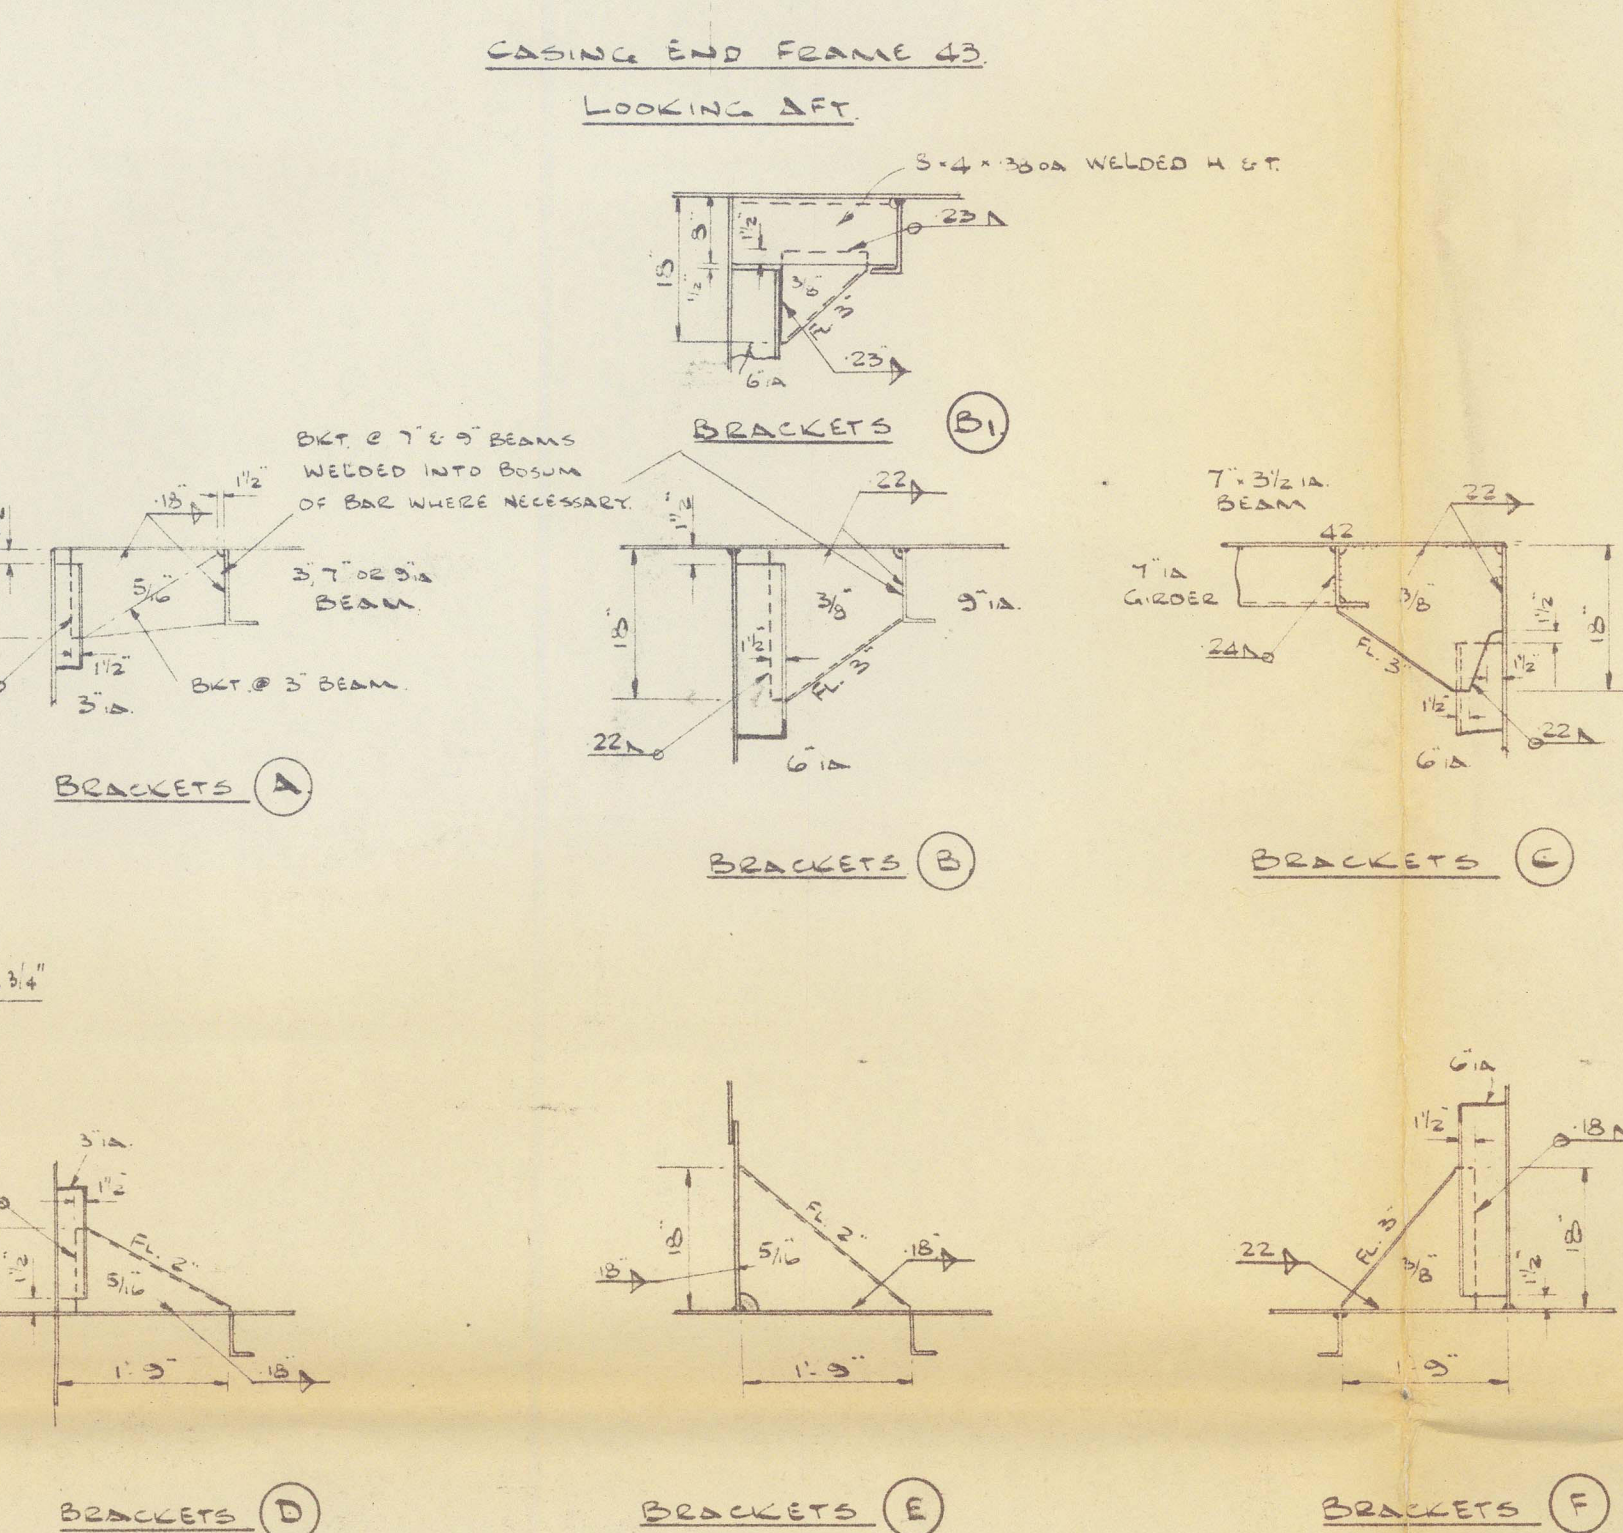
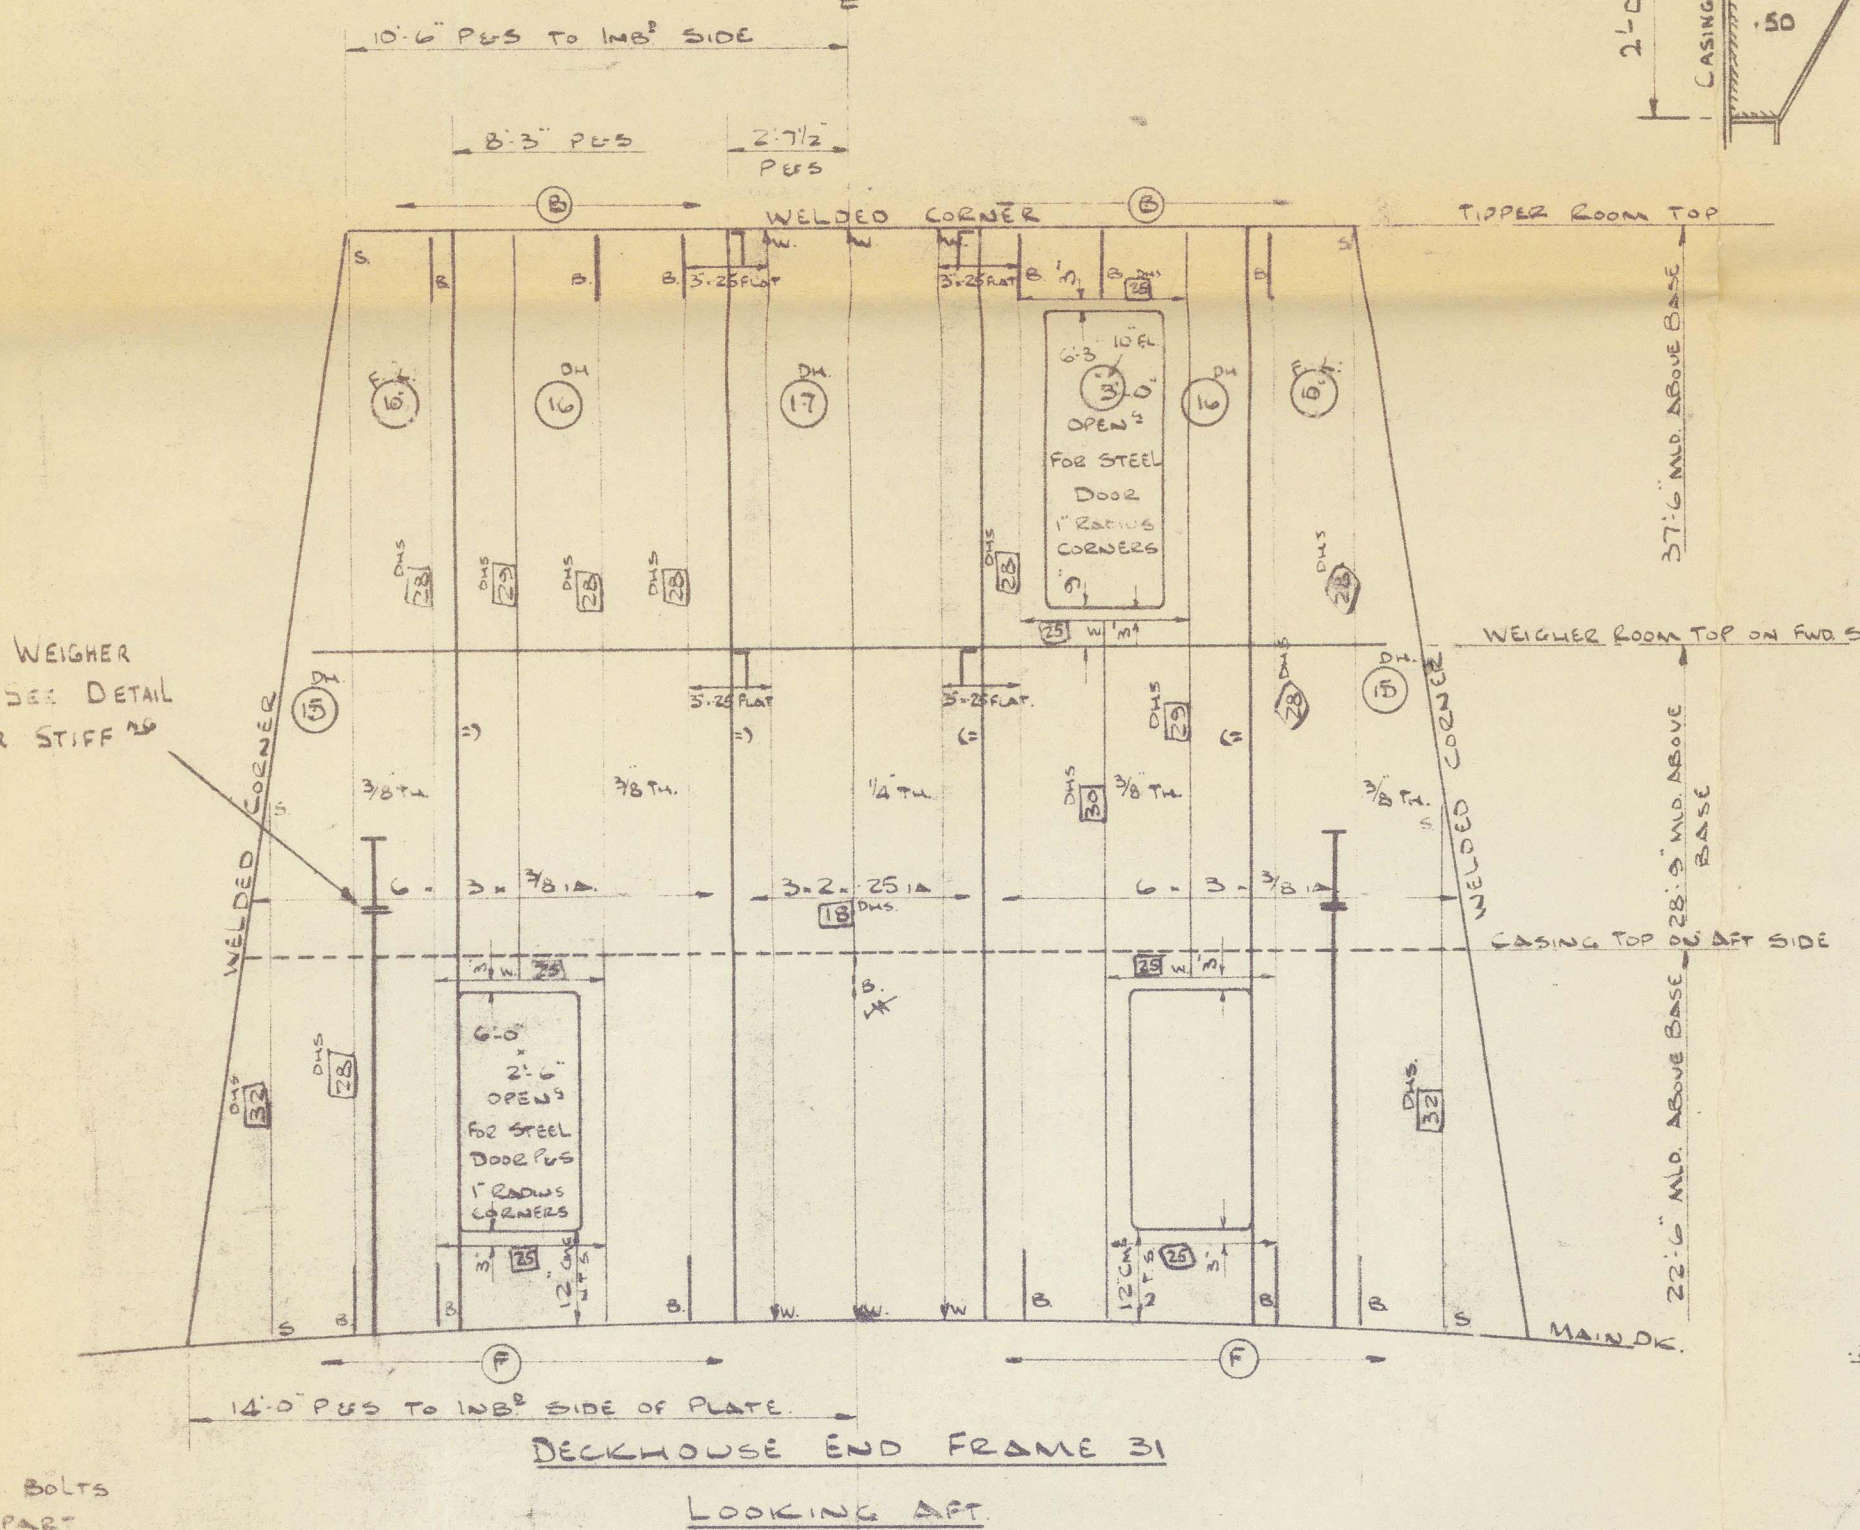
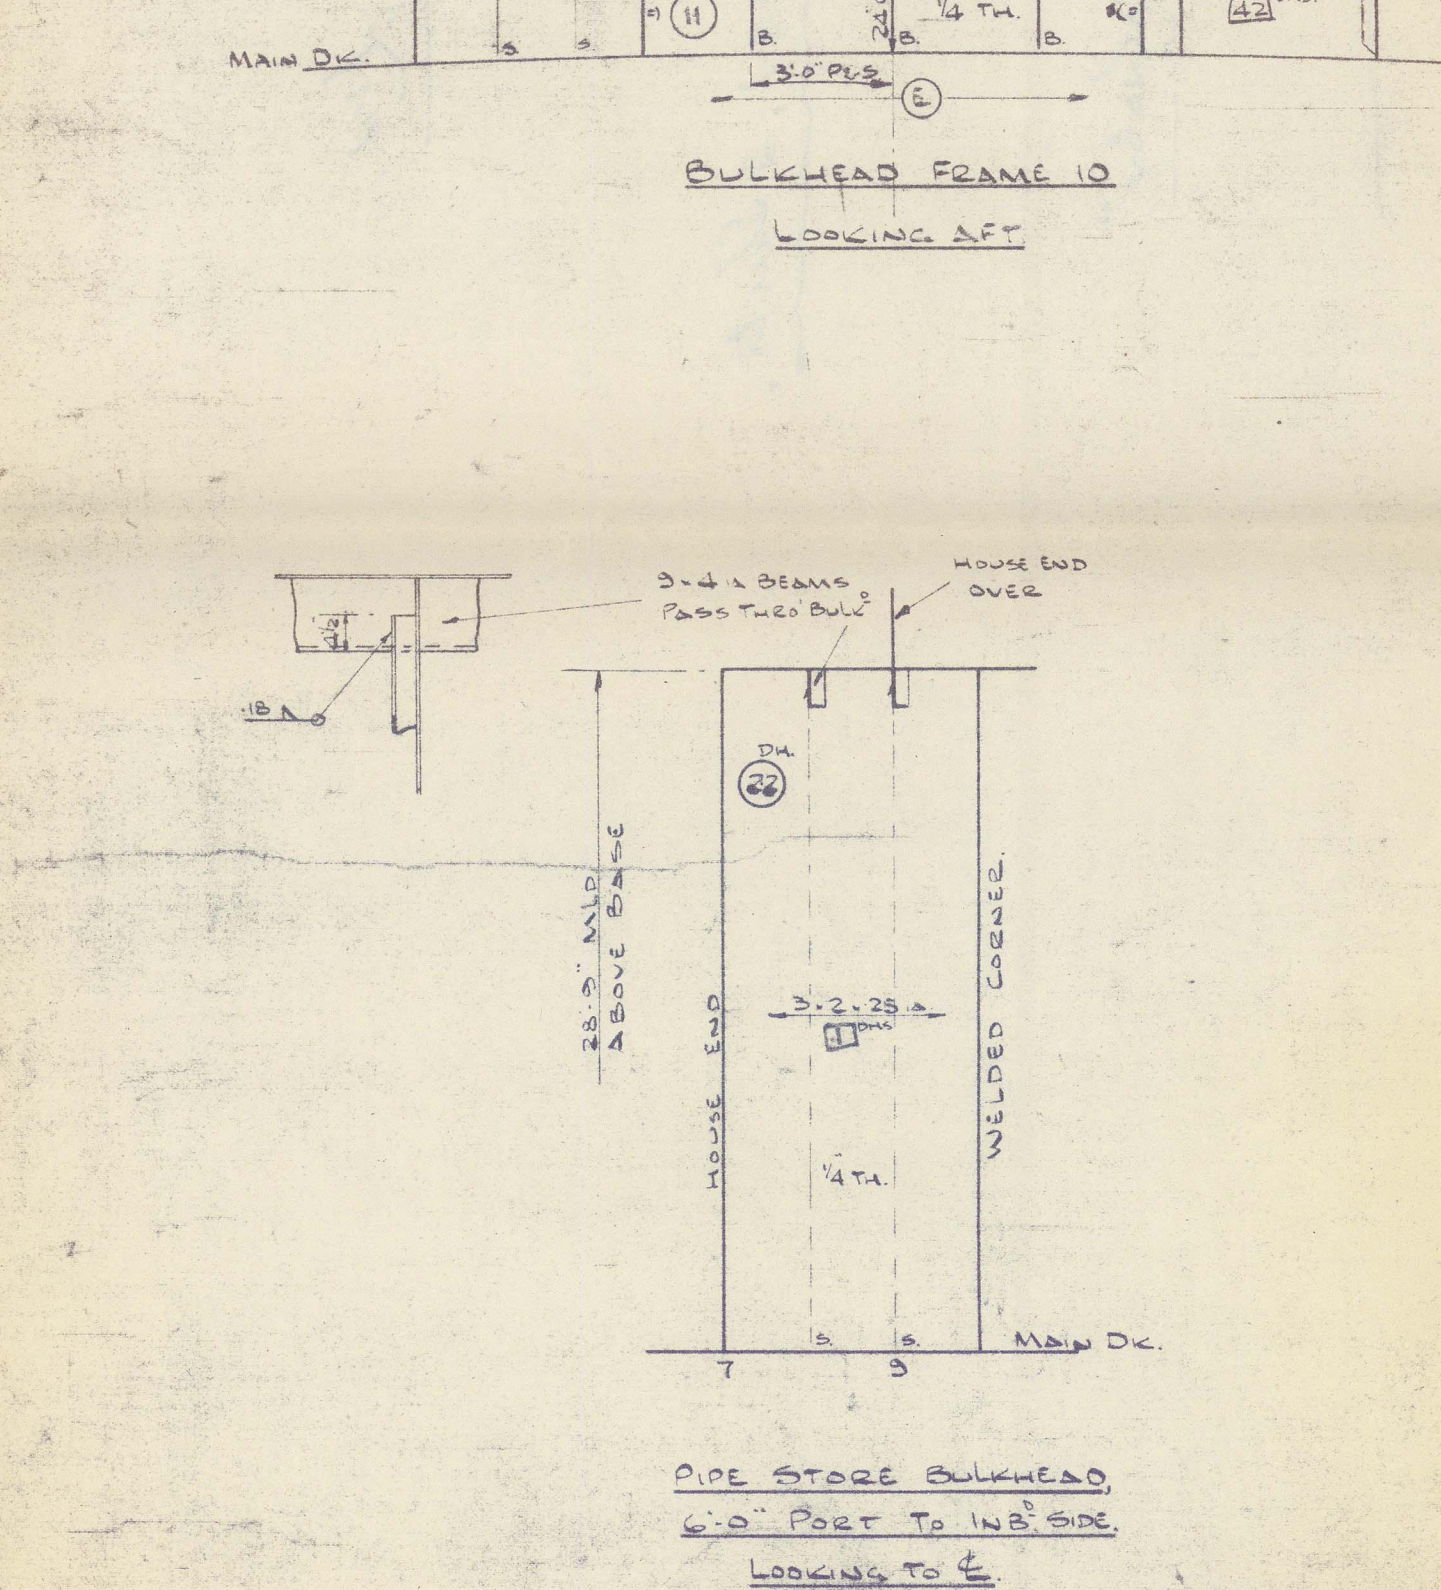
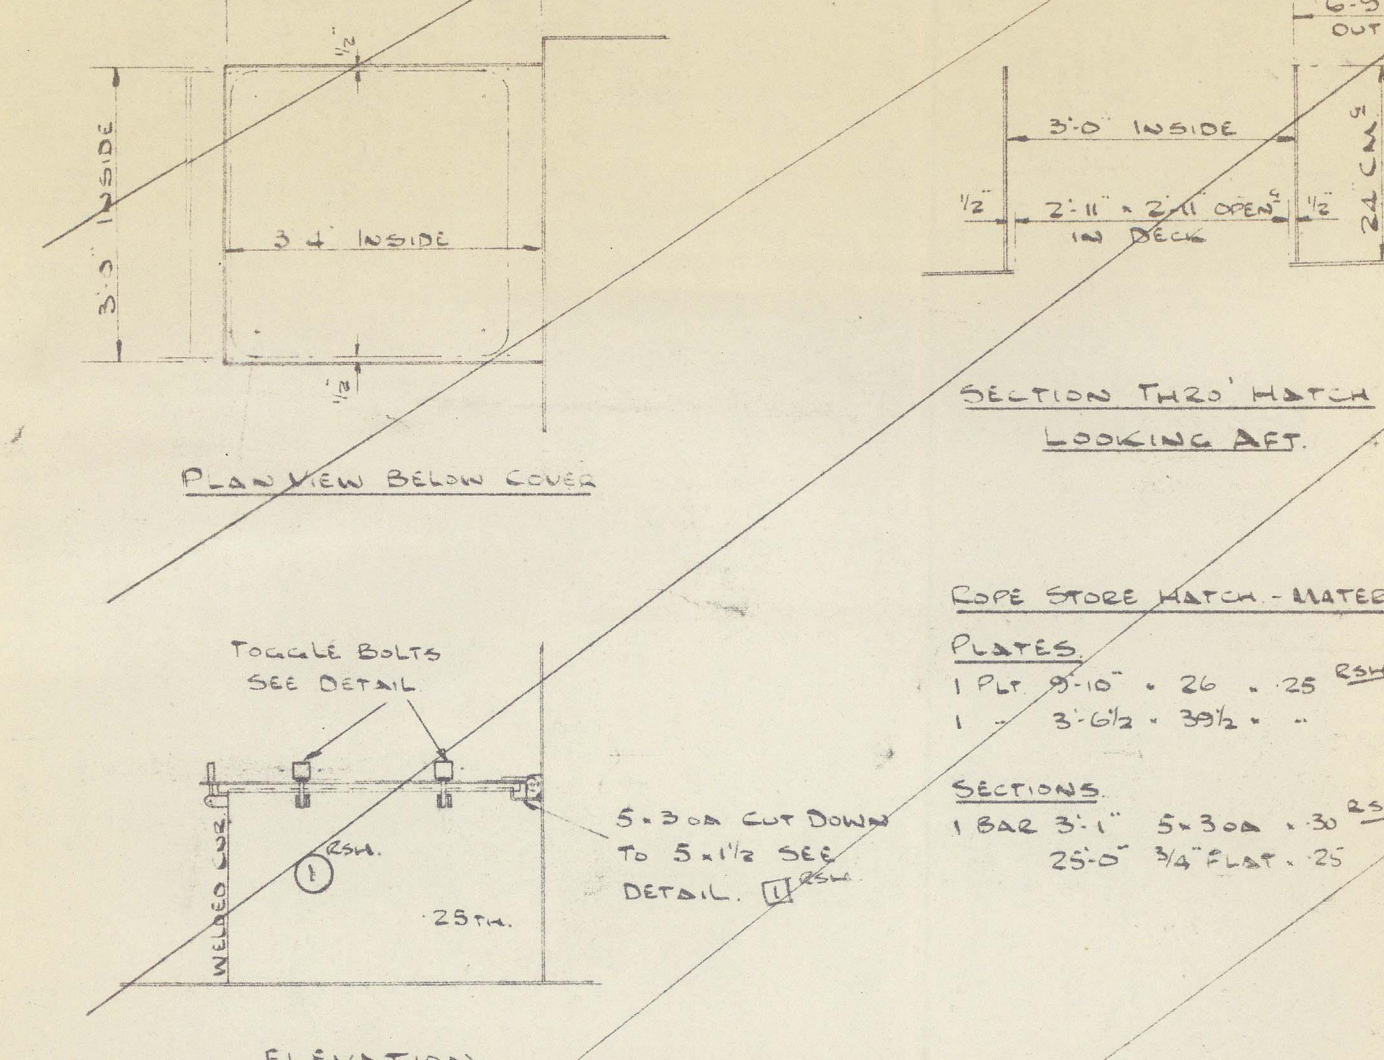





SEE SEPARATE PLAN FOR DETAILS OF LIFTING BEAMS & WEIGHER SUPPORTS

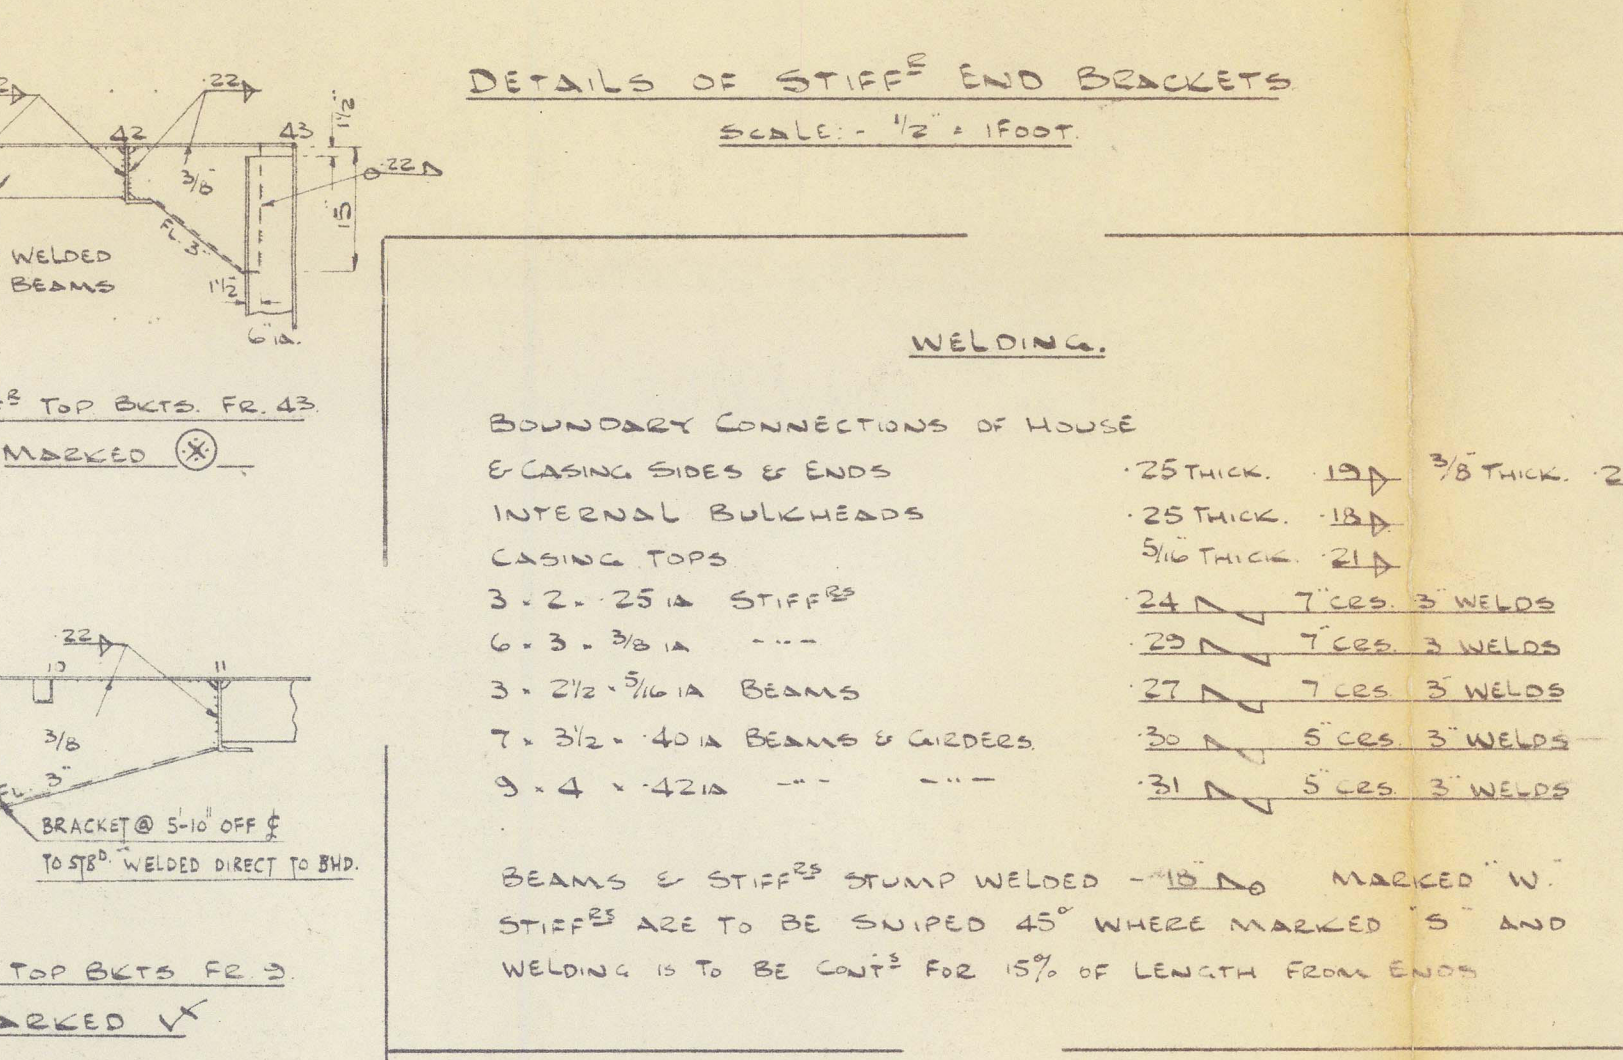

18x6 JOIST WEIGHER SUPPORTS SEE DETAIL BELOW FOR STIFF

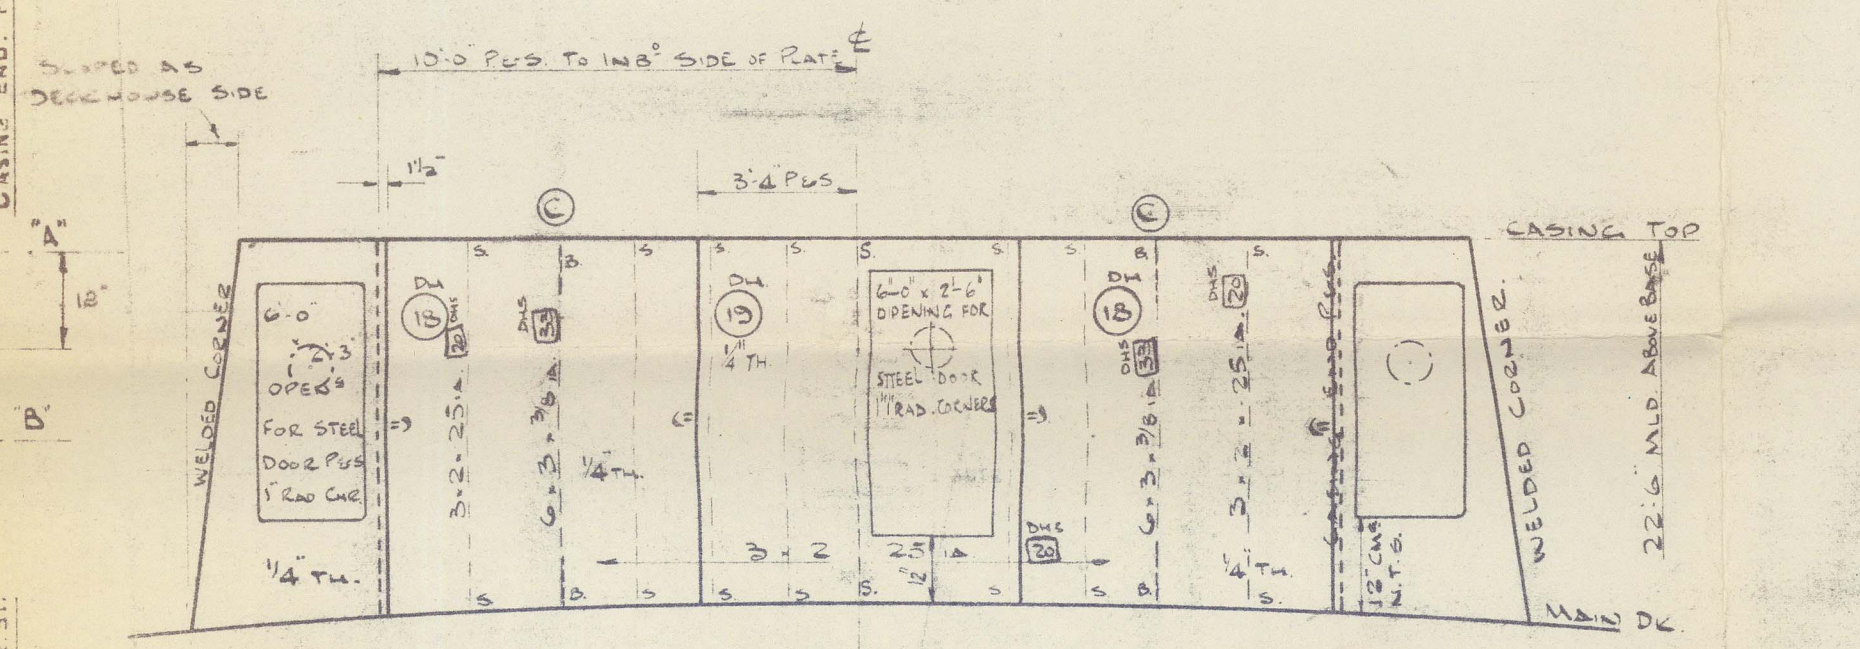

DETAIL OF STIFF IN WAY OF WEIGHER SUPPORTS FR 31

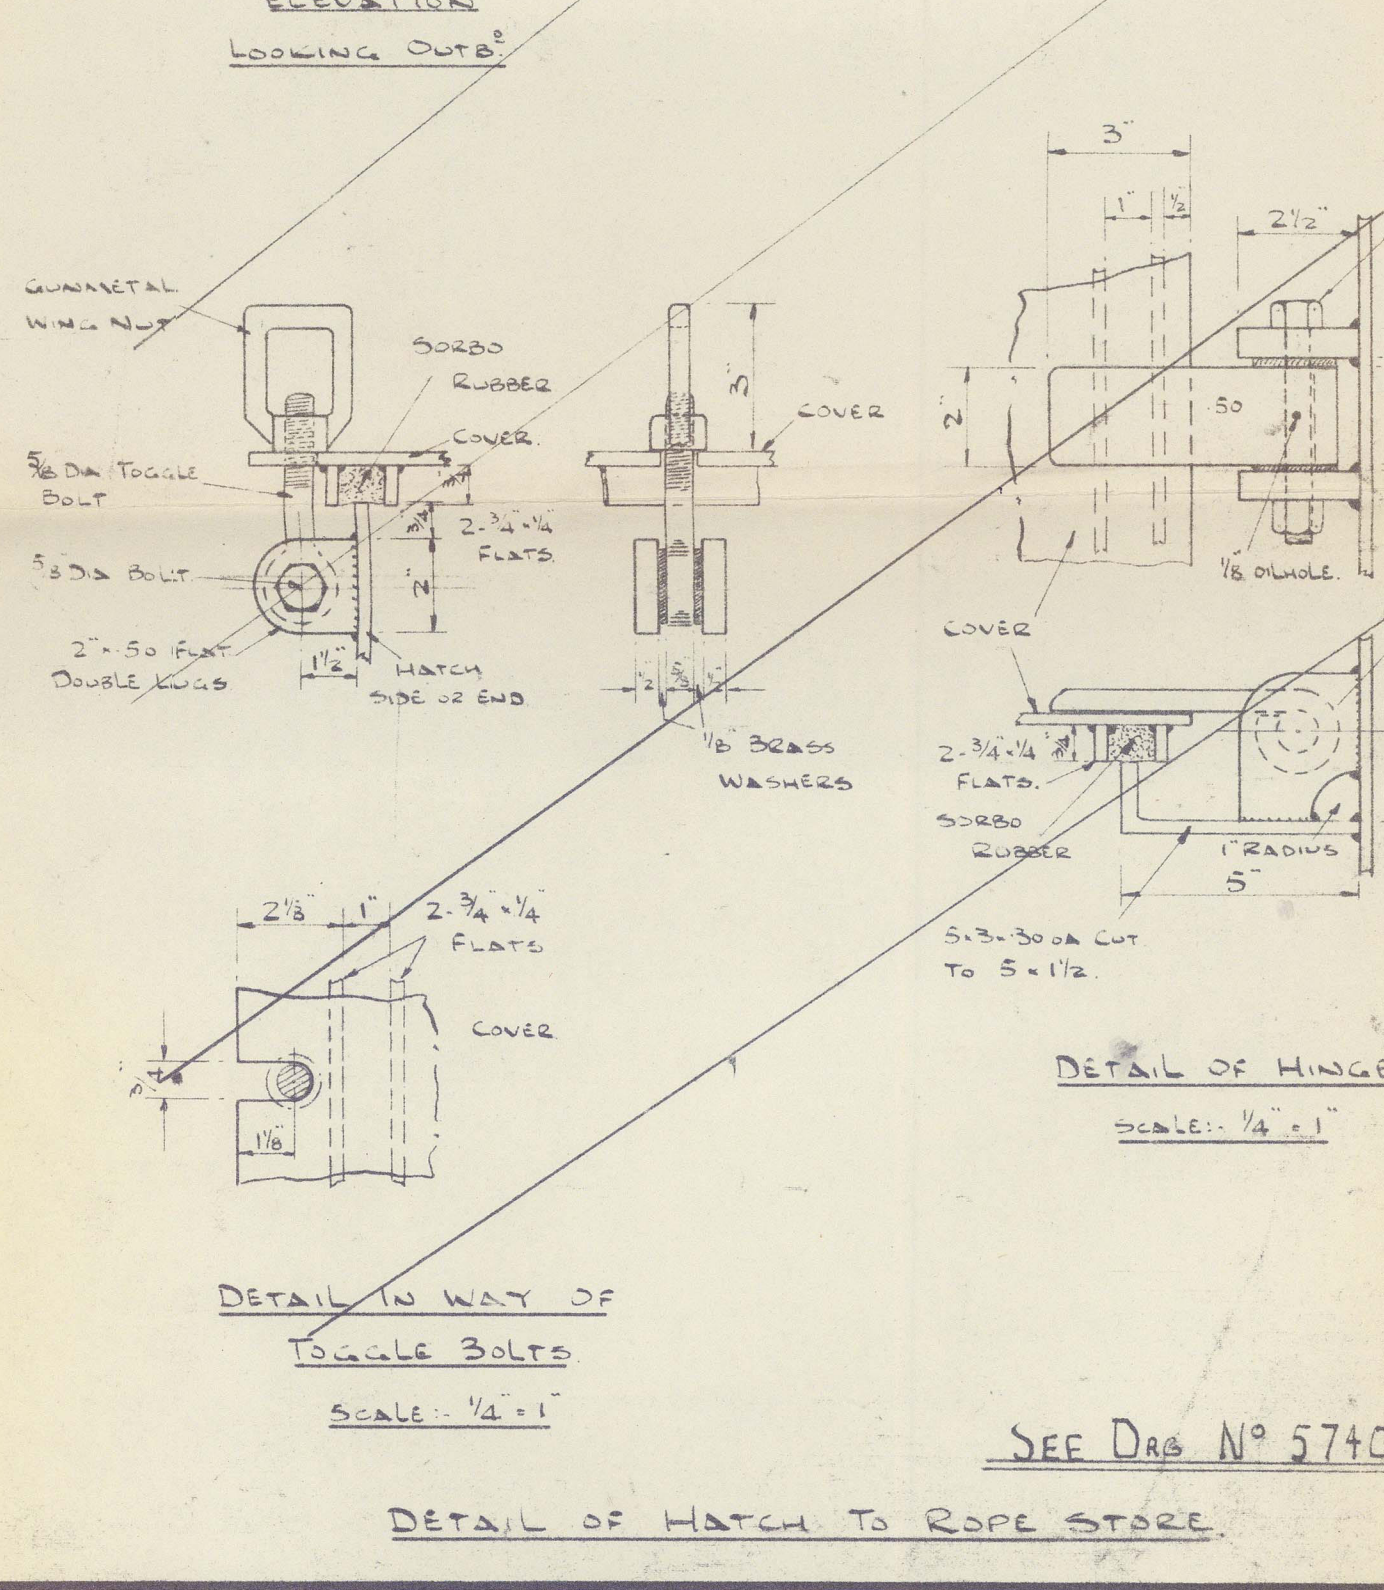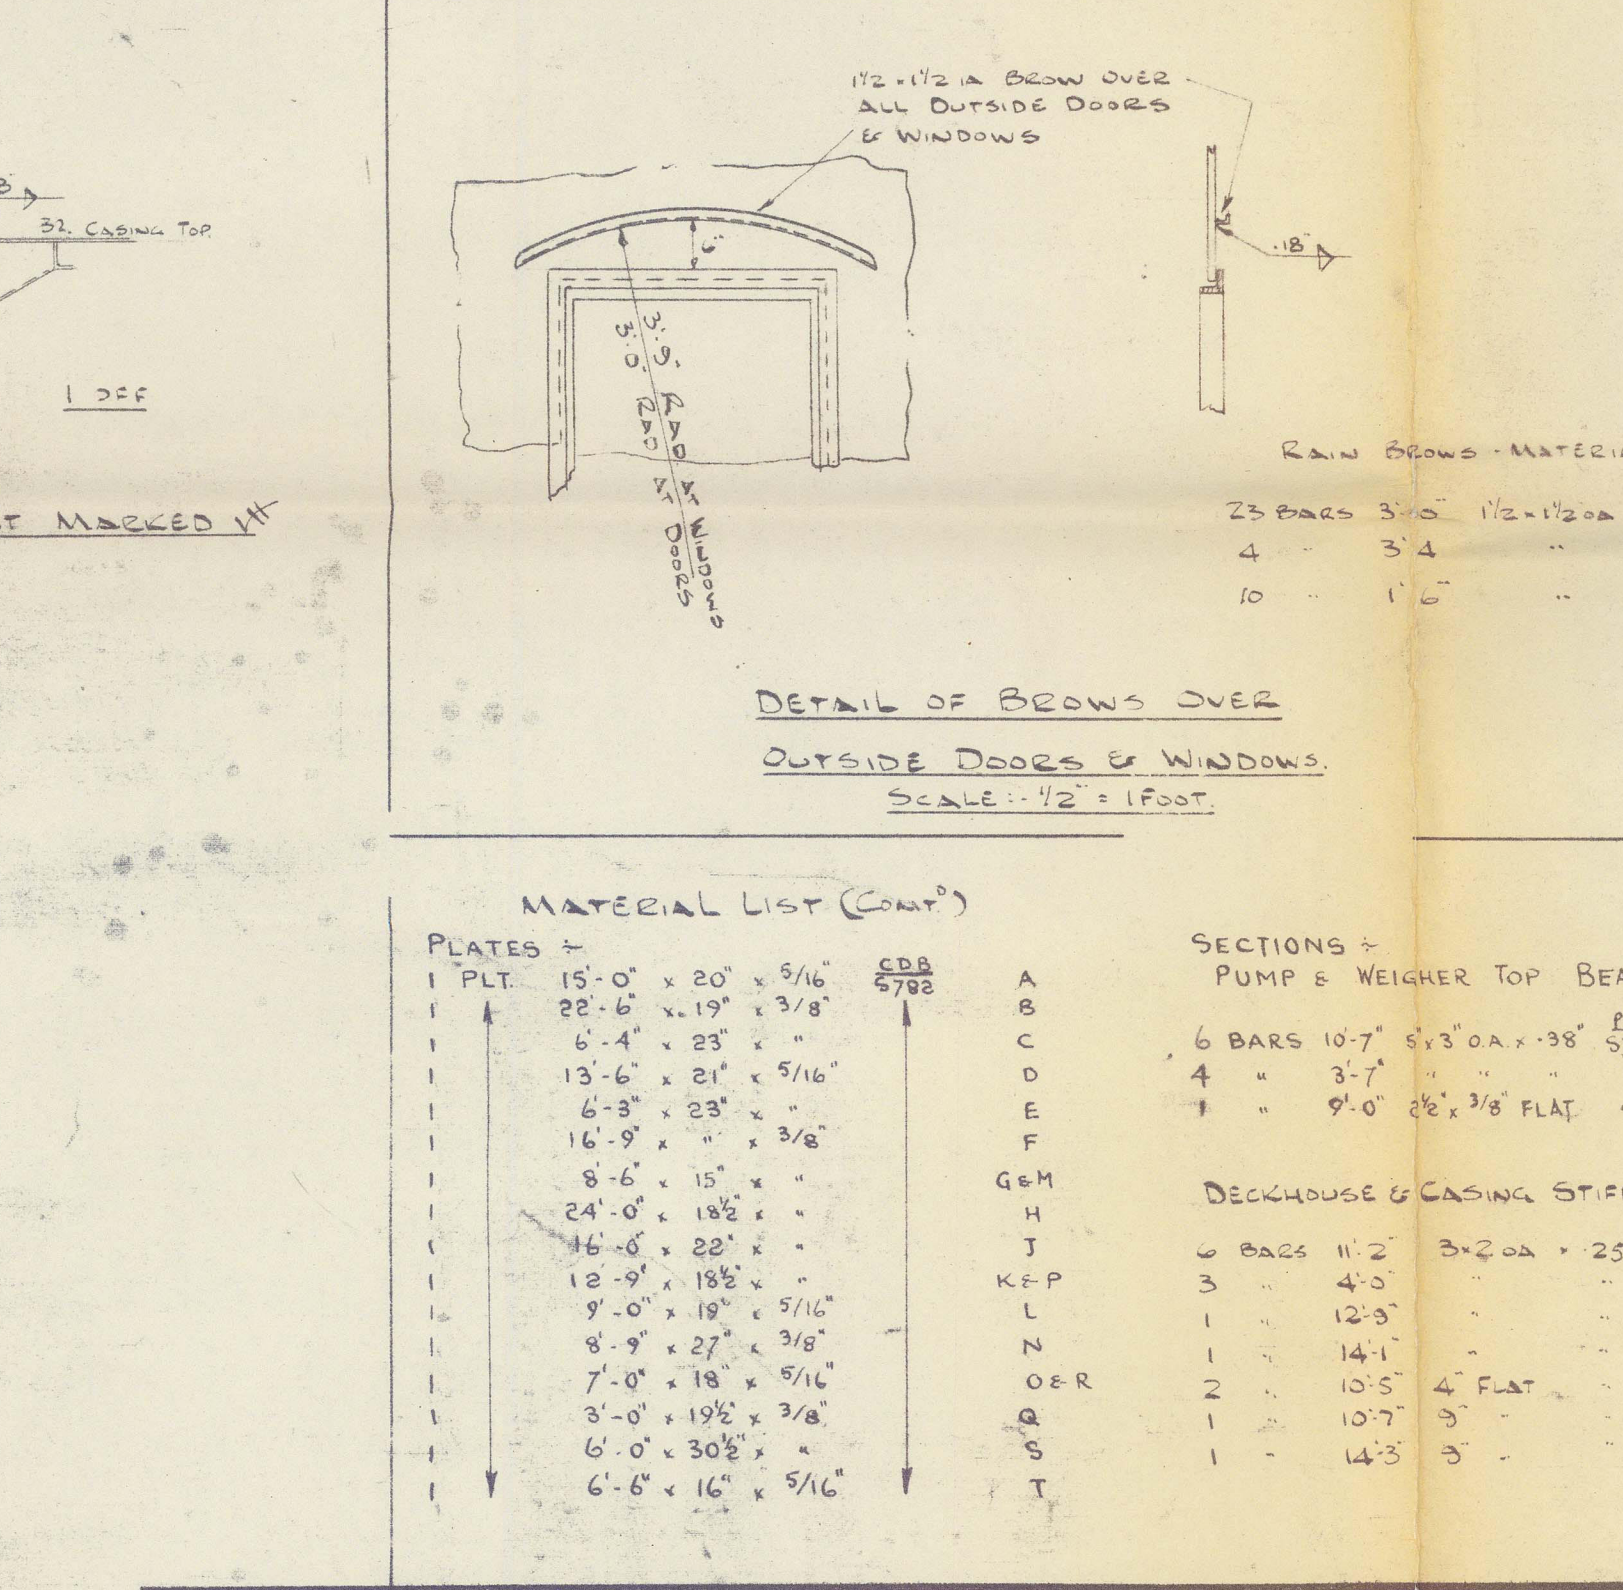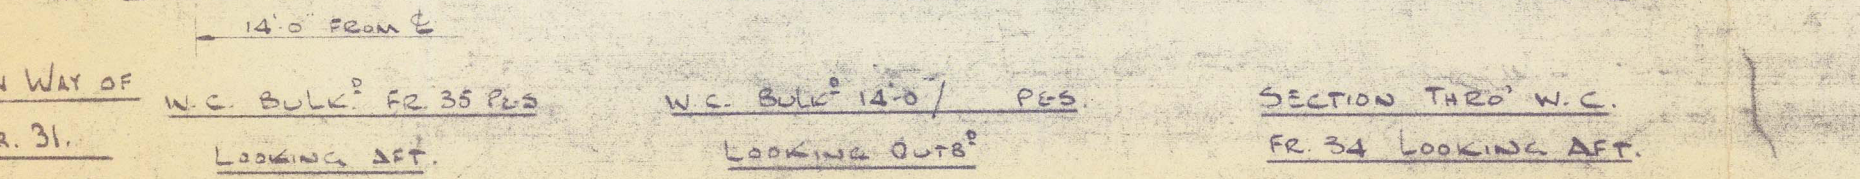

RICHARD DUNSTON LTD.

SHIPBUILDERS,

THORNE, YORKSHIRE.

DRAWN BY T.C.B. DATE 10.1.61

TRACED BY DATE

CHECKED BY DATE

REVISIONS

NO. DATE PARTICULARS

A 14.2.61 OWNERS AMENDMENTS

B 3.3.61 OWNERS & LLOYD'S AMENDMENTS

C 18.4.61 AMENDMENT TO DRAW IN BUD 19

YARD NO **5.782**

DRG. NO **5740/11**

TITLE: **DECKHOUSES & CASINGS SHEET 2**

SCALE: **1/4" = 1'**

SEE DRS NO 5740/28

DETAIL OF HATCH TO ROPE STORE

Ruband Sunston (Hessle) Ltd.

Yard. no 982

Sickhouse + basins (Sheet 2), 2 Sheets.

"As Built"

Grain Elevator Pontoon "CARNABY"

Hub. F.6 Rpt. no. 681261



© 2021

Lloyd's Register
Foundation

014556-014565-0379