
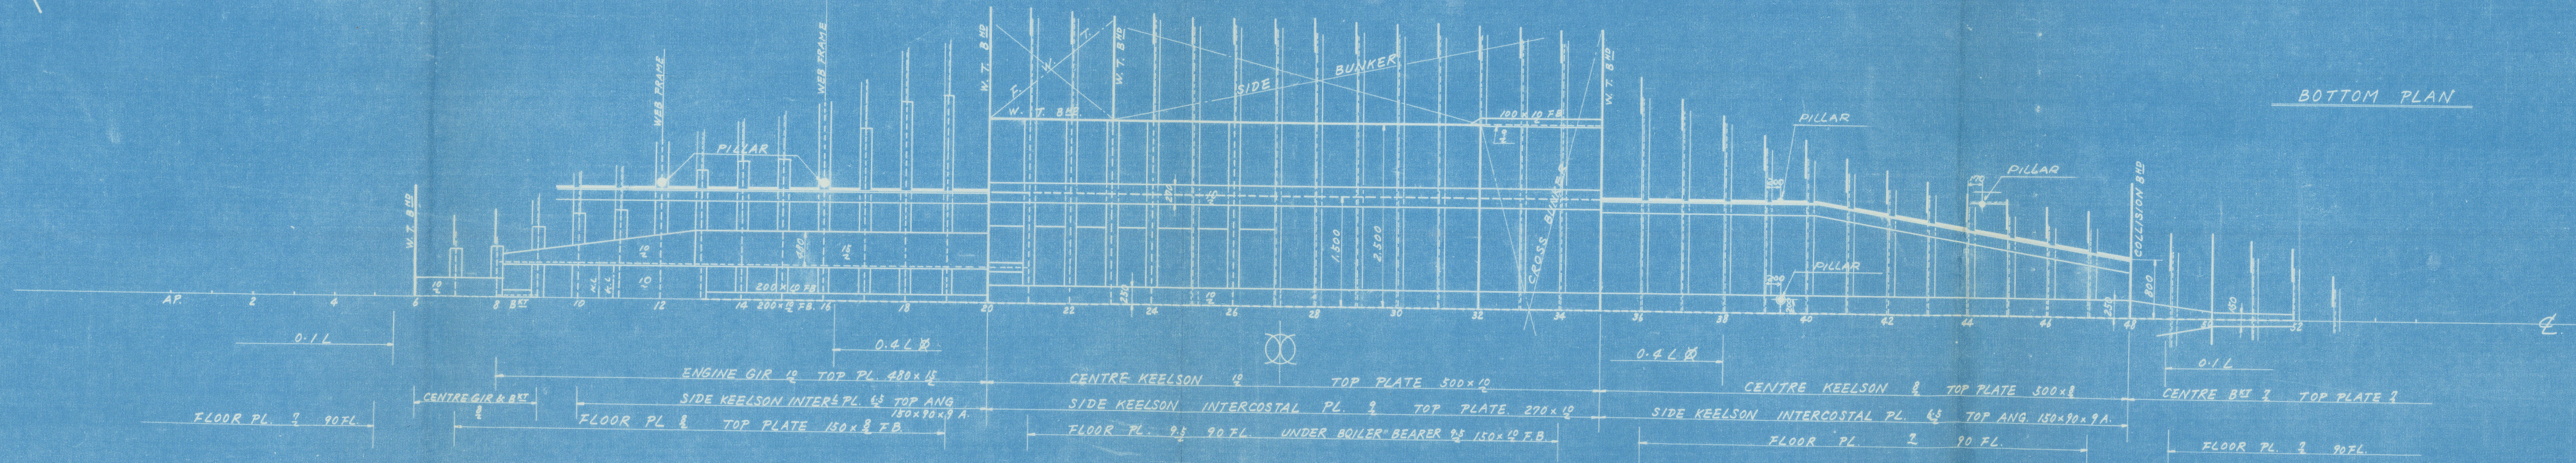
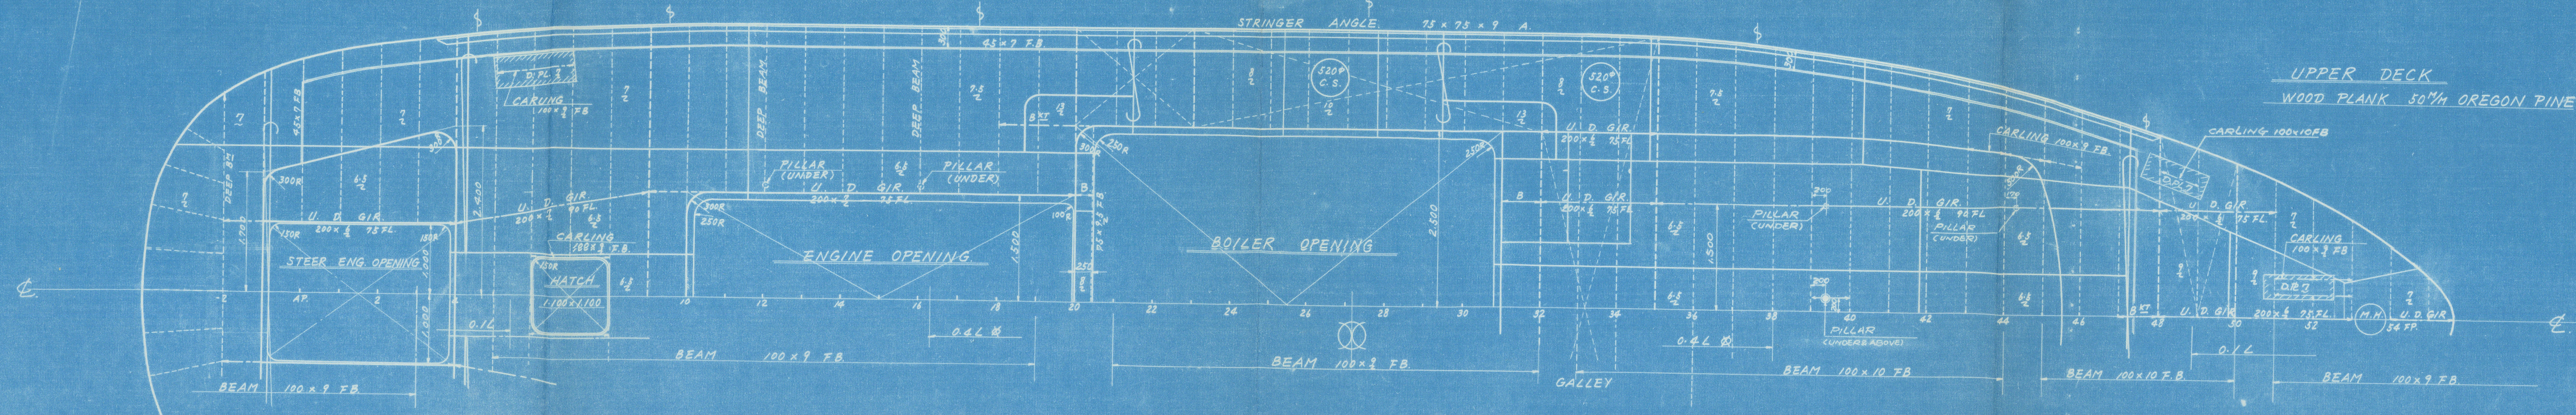
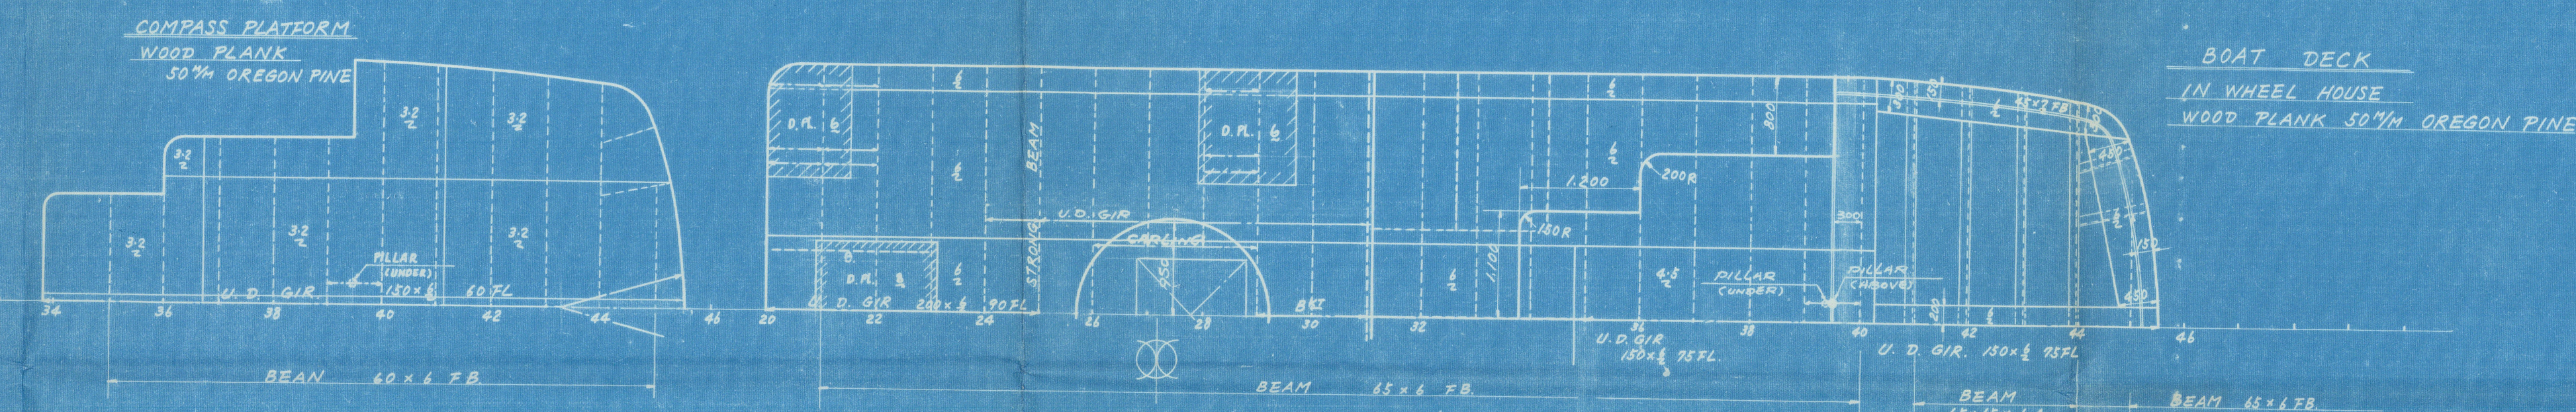


STEEL S.S. STEAM TUG "JAGUCHA"

PRINCIPAL DIMENSIONS

LENGTH P.P.	29' 900
BREADTH MOULDED	7' 800
DEPTH MOULDED	3' 500
DESIGNED DRAUGHT MOULDED	2' 650

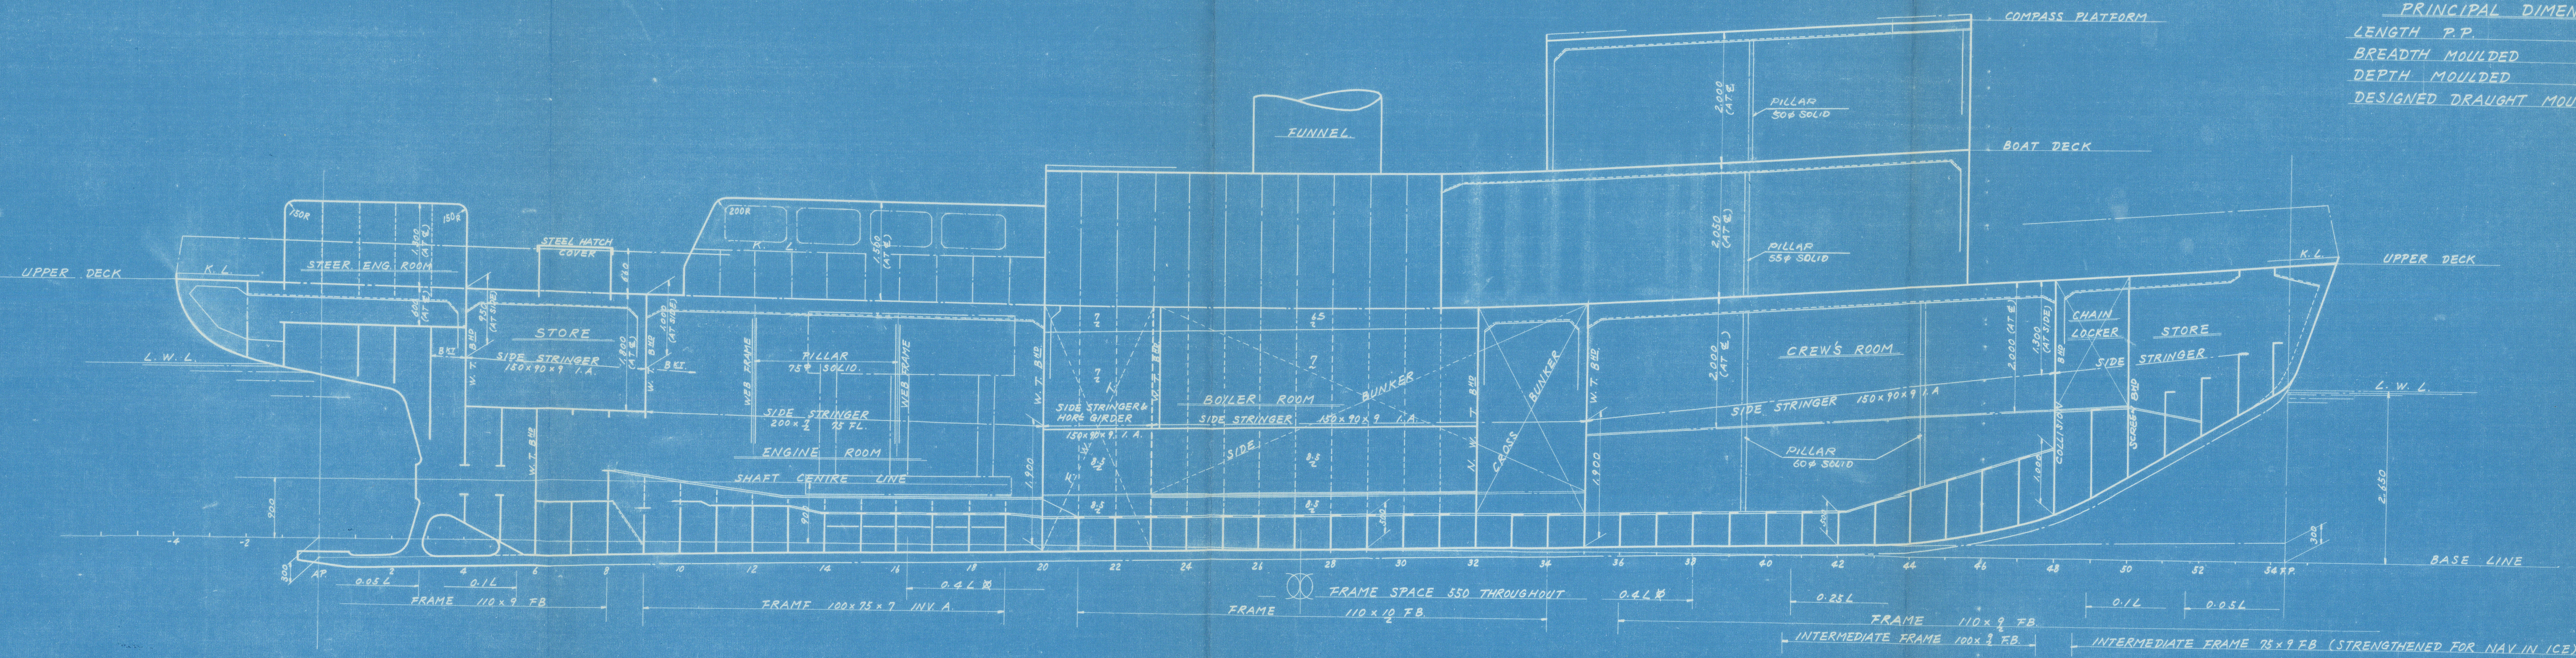

AS BUILT



NAME OF PART	MATERIAL	UNIT	REMARK
ЯГОЧА	В% СУДОИМПОРТ СССР		
CONSTRUCTION PROFILE & PLANS			
HITACHI SHIPBUILDING & ENGINEERING CO. LTD.	DRAWN BY	SCALE	1/50
YAMASHITA SHIPYARD	CHECKED BY		
SHIP DESIGNING SECTION	REVIEWED BY		
DATE	DATE		
MANUF.	MANUF.		
CODE NO.	DRAWING NO.		

014317 010358-0238