
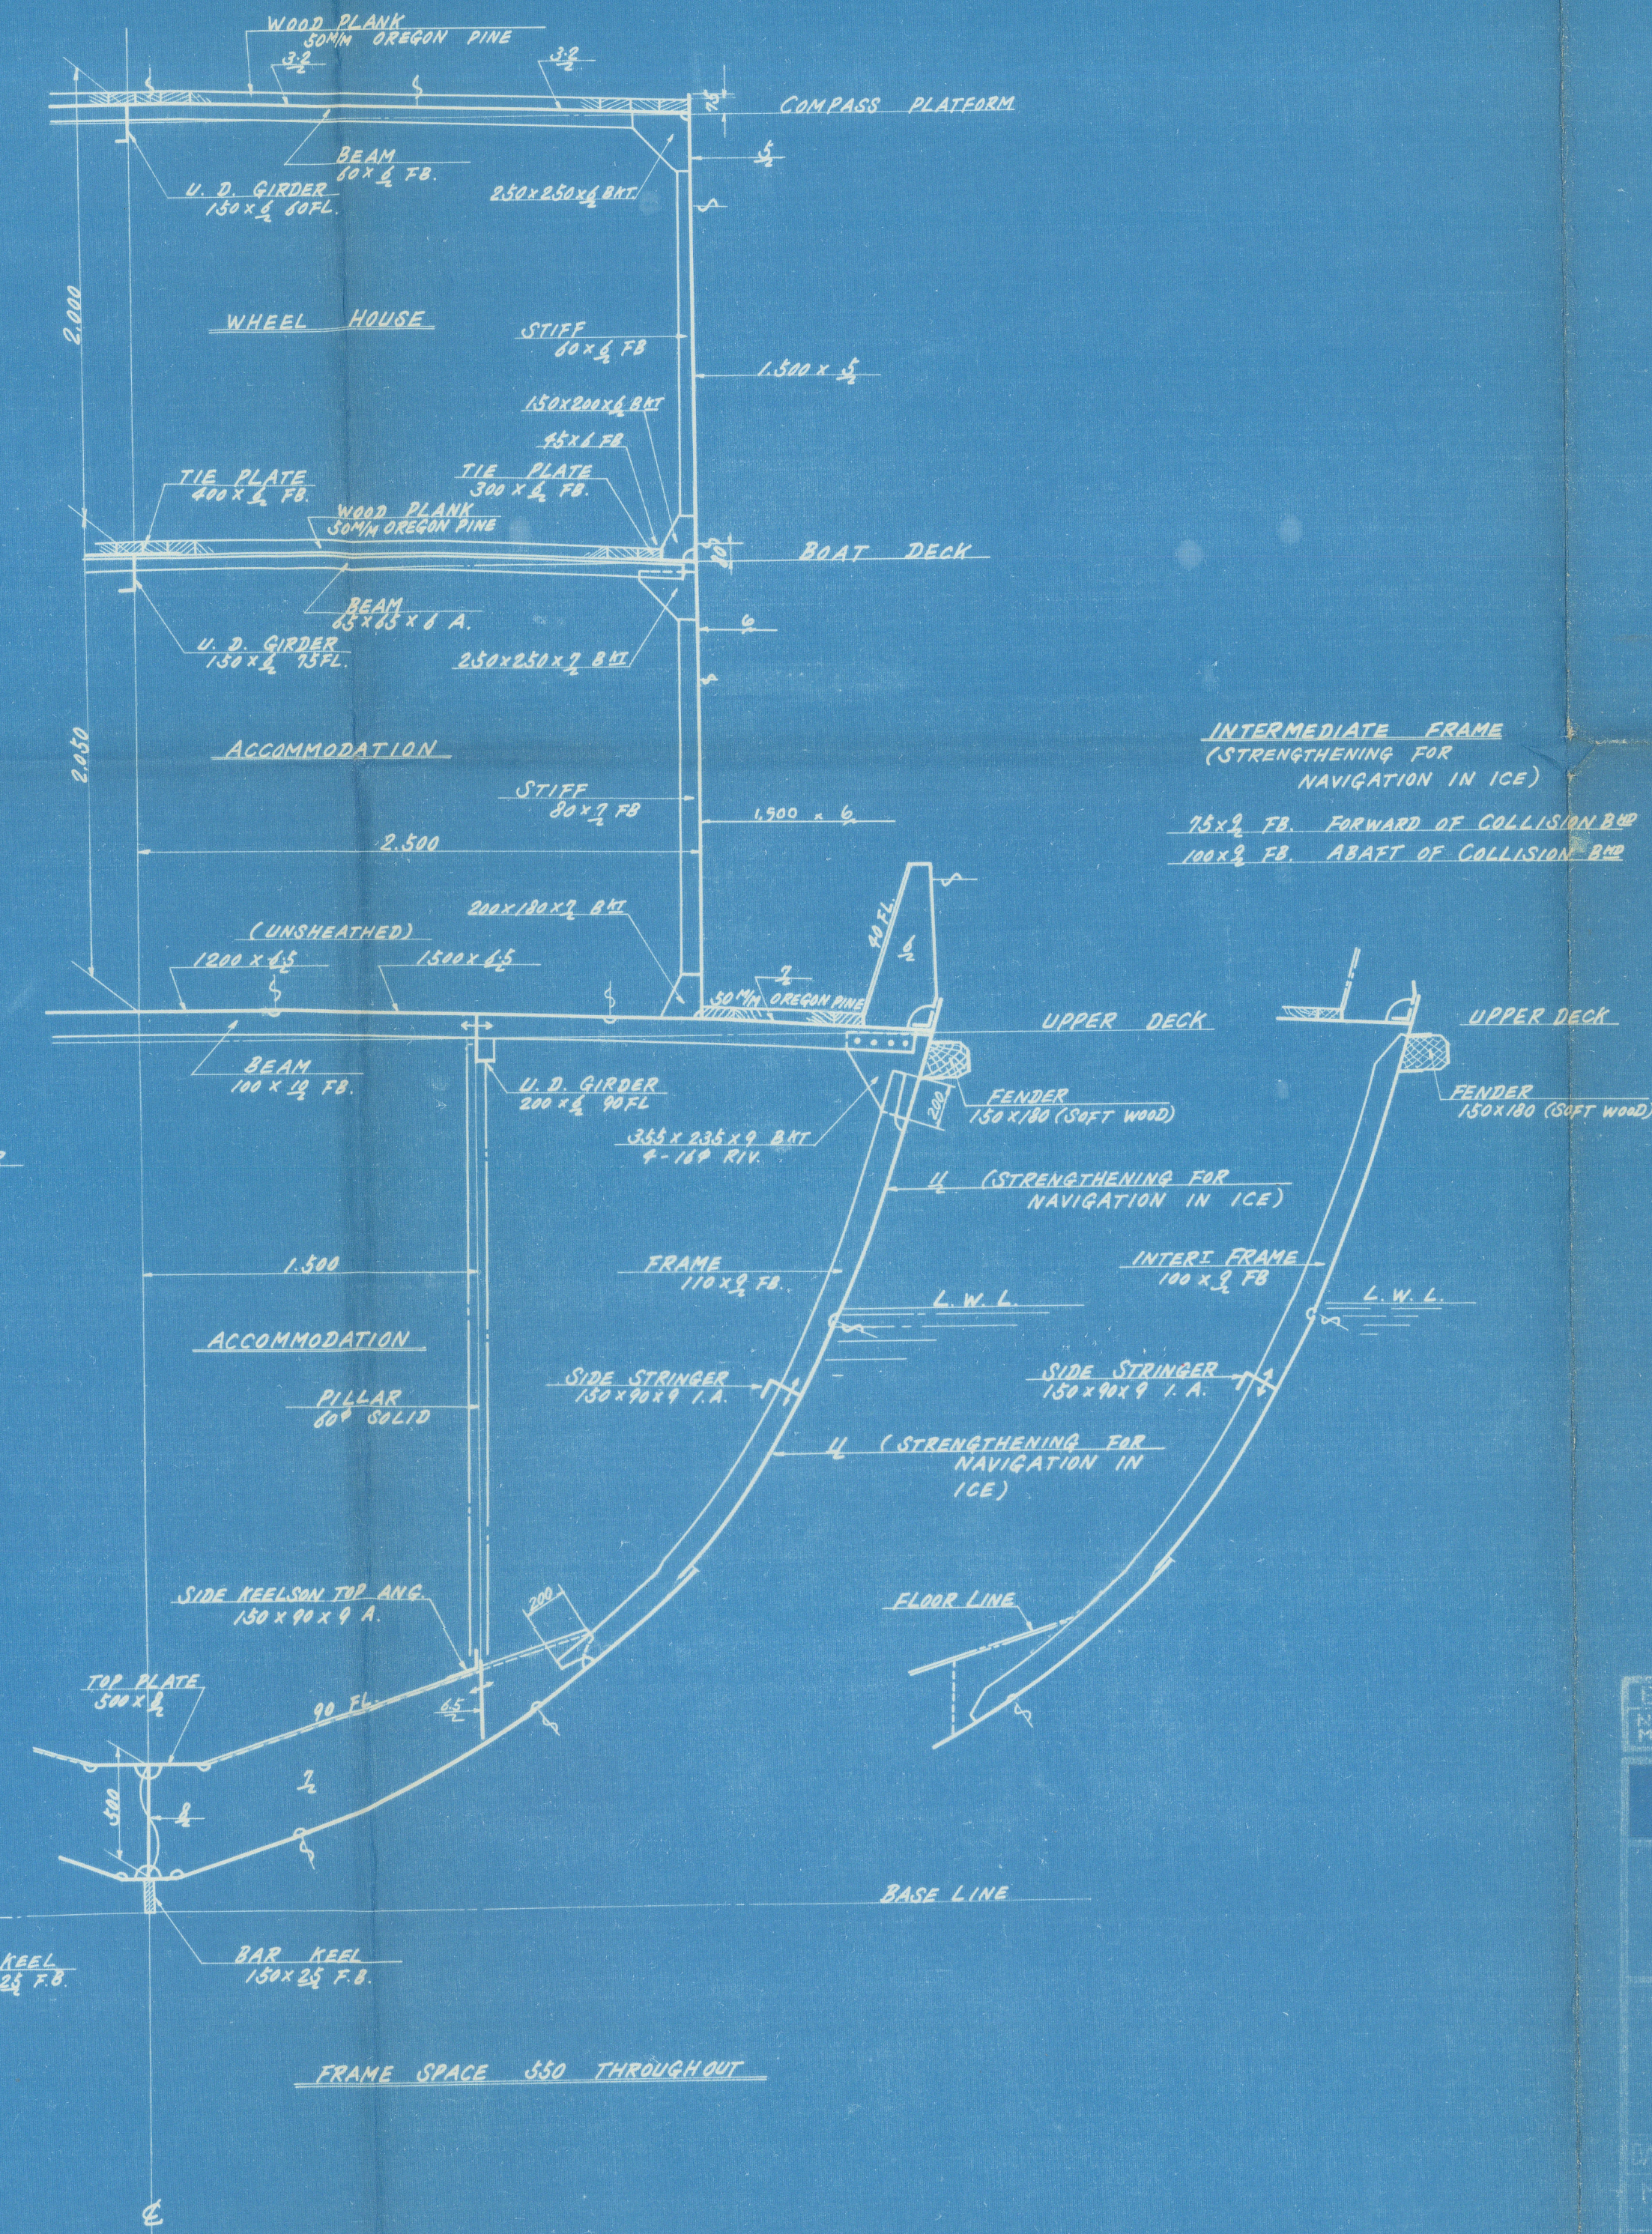
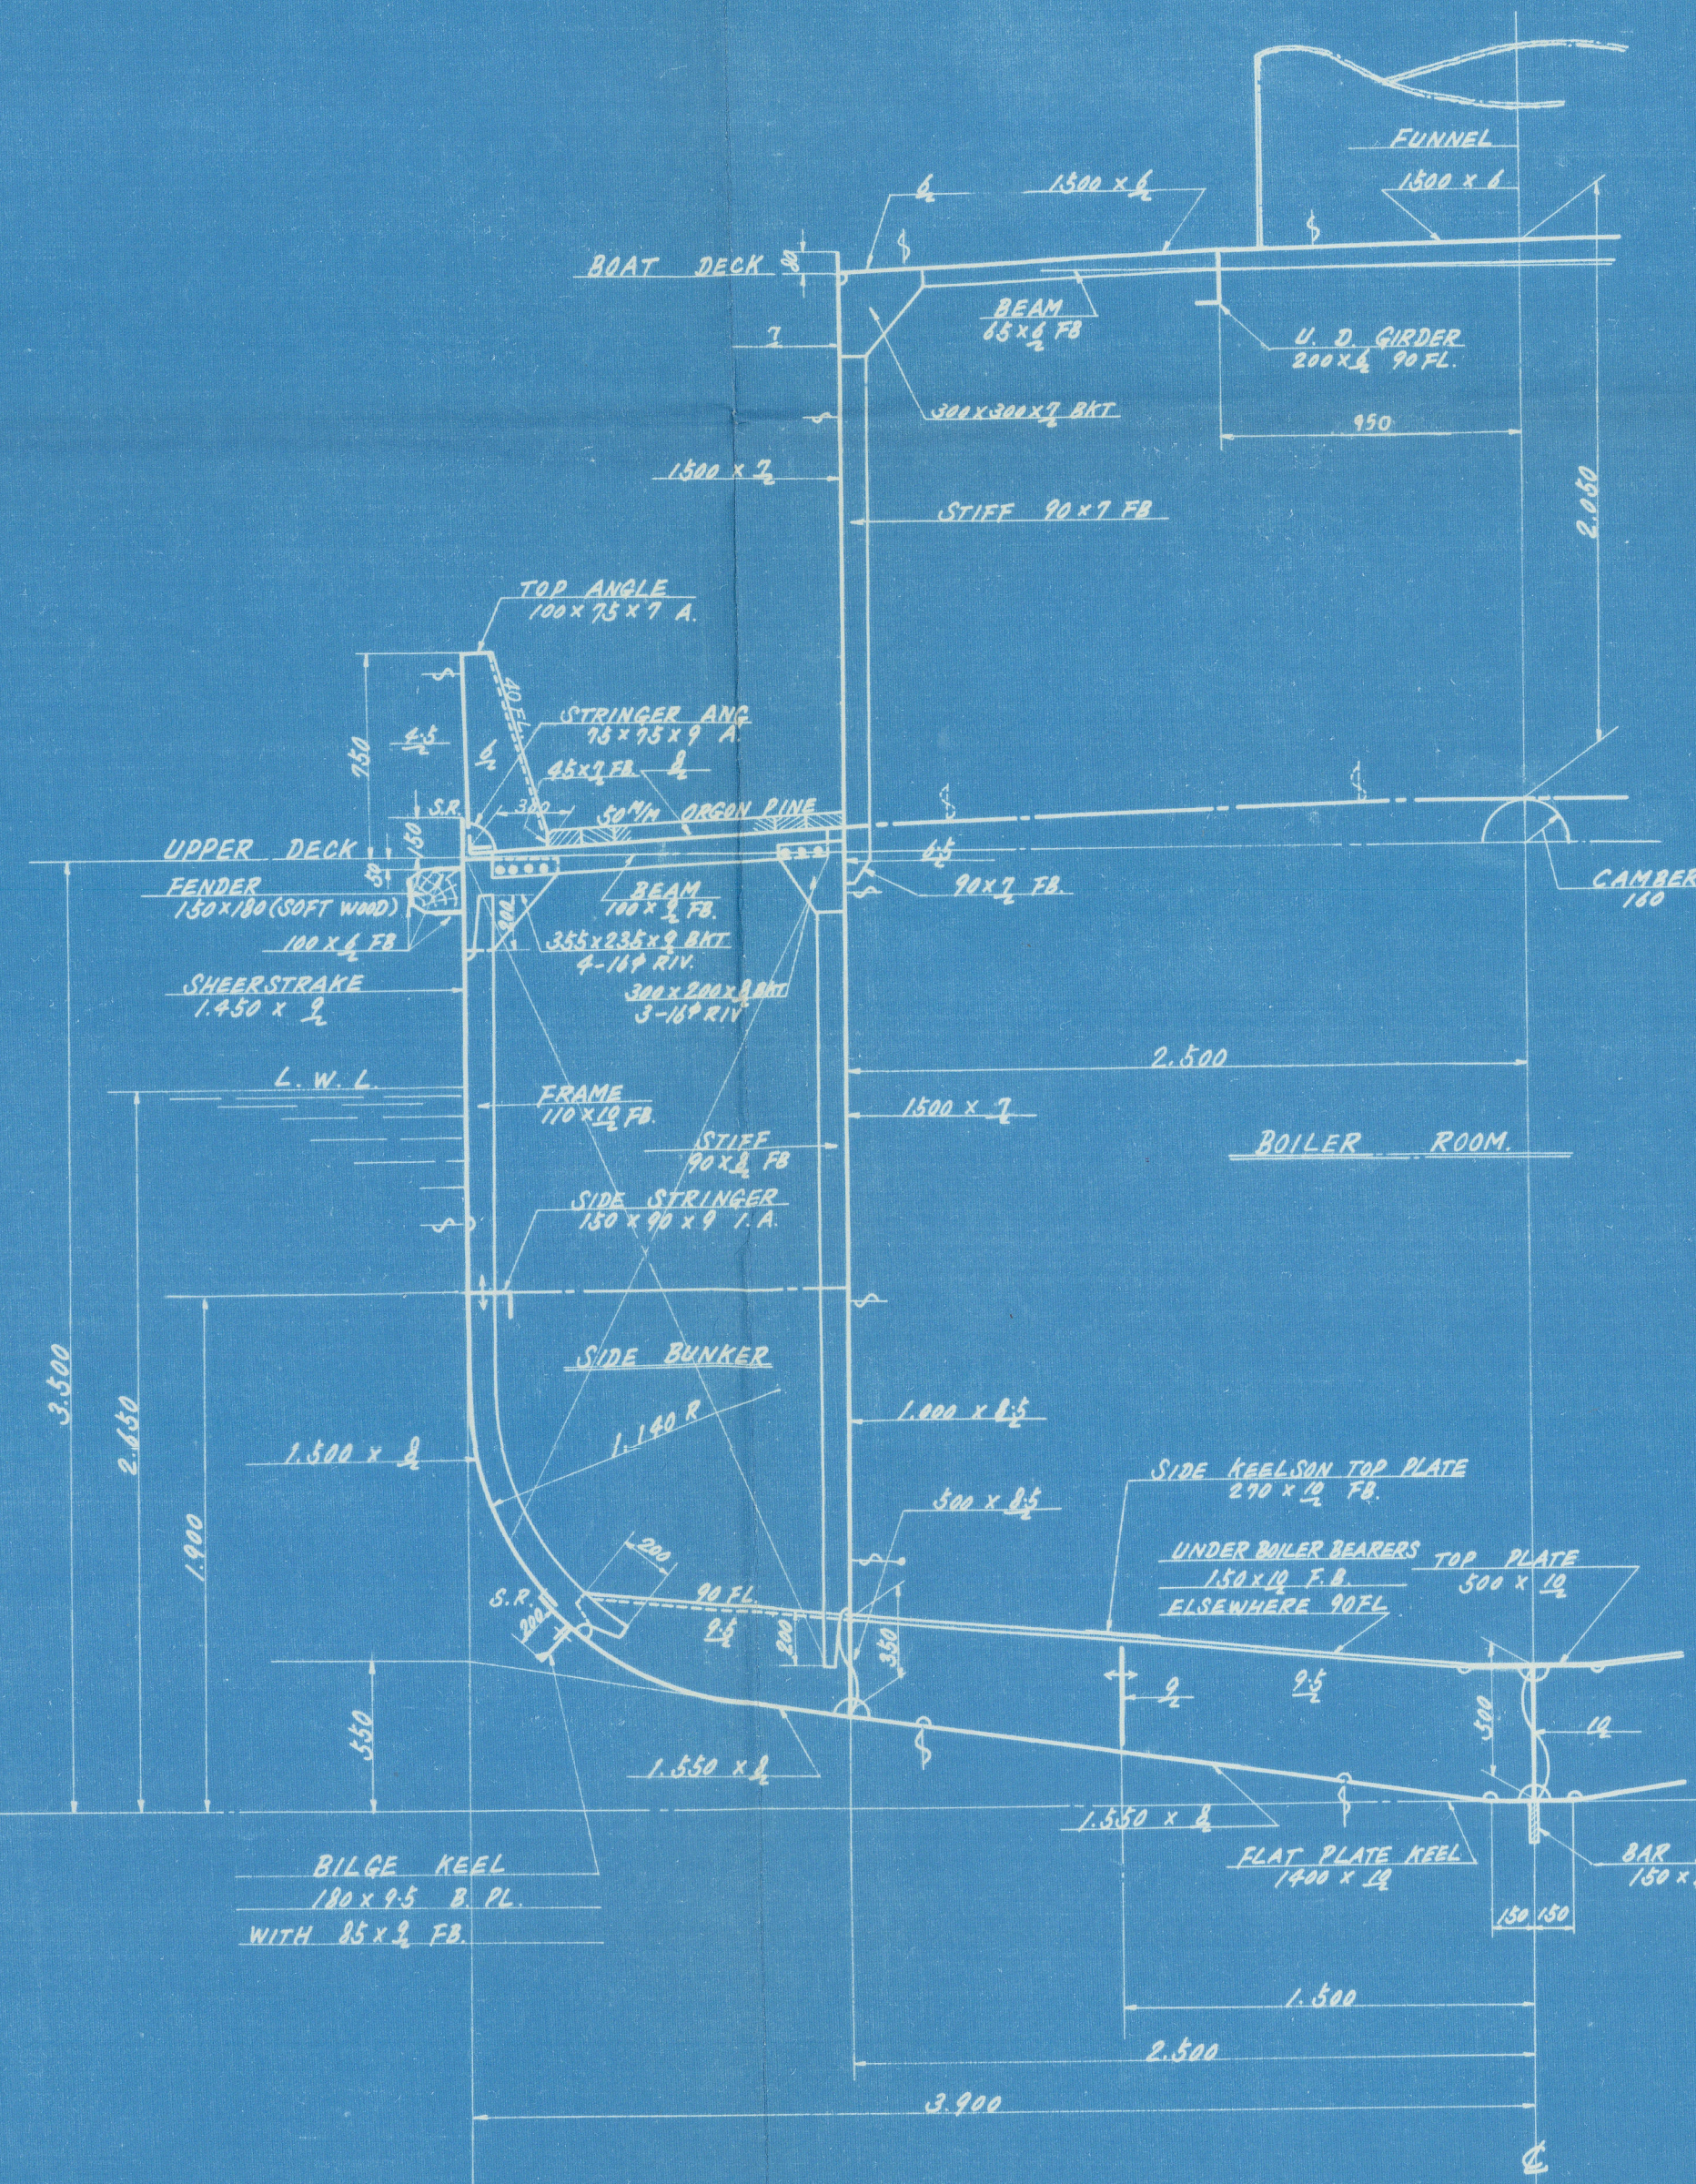


# STEEL S.S. STEAM TUG "JAGOCHA"

EQUIPMENT	NUMERAL
$L \times (B + D) = 98'10" \times (25'59" + 11'48") = 3,636.59 \text{ (SF)}$	
<b>EQUIPMENTS</b>	
BOWER ANCHORS (STOCKLESS)	293 <sup>4</sup> 2
WROUGHT IRON STD LINK CHAIN CABLE	15" - 15 FMS x 6
FIBRE MOORING ROPES (4-STRAND)	
HAWSER 5 1/2" CIRCUMFERENCE	10 FMS.
WARP 4" CIRCUMFERENCE	60 FMS.


SINGLE SCREW STEAM TUG.  
CLASS  
 LLOYD'S REGISTER OF SHIPPING, + 100 A1  
 "FOR TOWING SERVICES"  
 "STRENGTHENED FOR NAVIGATION IN ICE"

PRINCIPAL DIMENSIONS	
LENGTH P.P.	29 <sup>M</sup> 900 (98' 10")
BREADTH MOULDED	7 <sup>M</sup> 800 (25' 59")
DEPTH MOULDED	3 <sup>M</sup> 300 (11' 48")
DESIGNED DRAUGHT MOULDED	2 <sup>M</sup> 650 (8' 69")
SCANTLING DRAUGHT MOULDED	2 <sup>M</sup> 975 (9' 76")

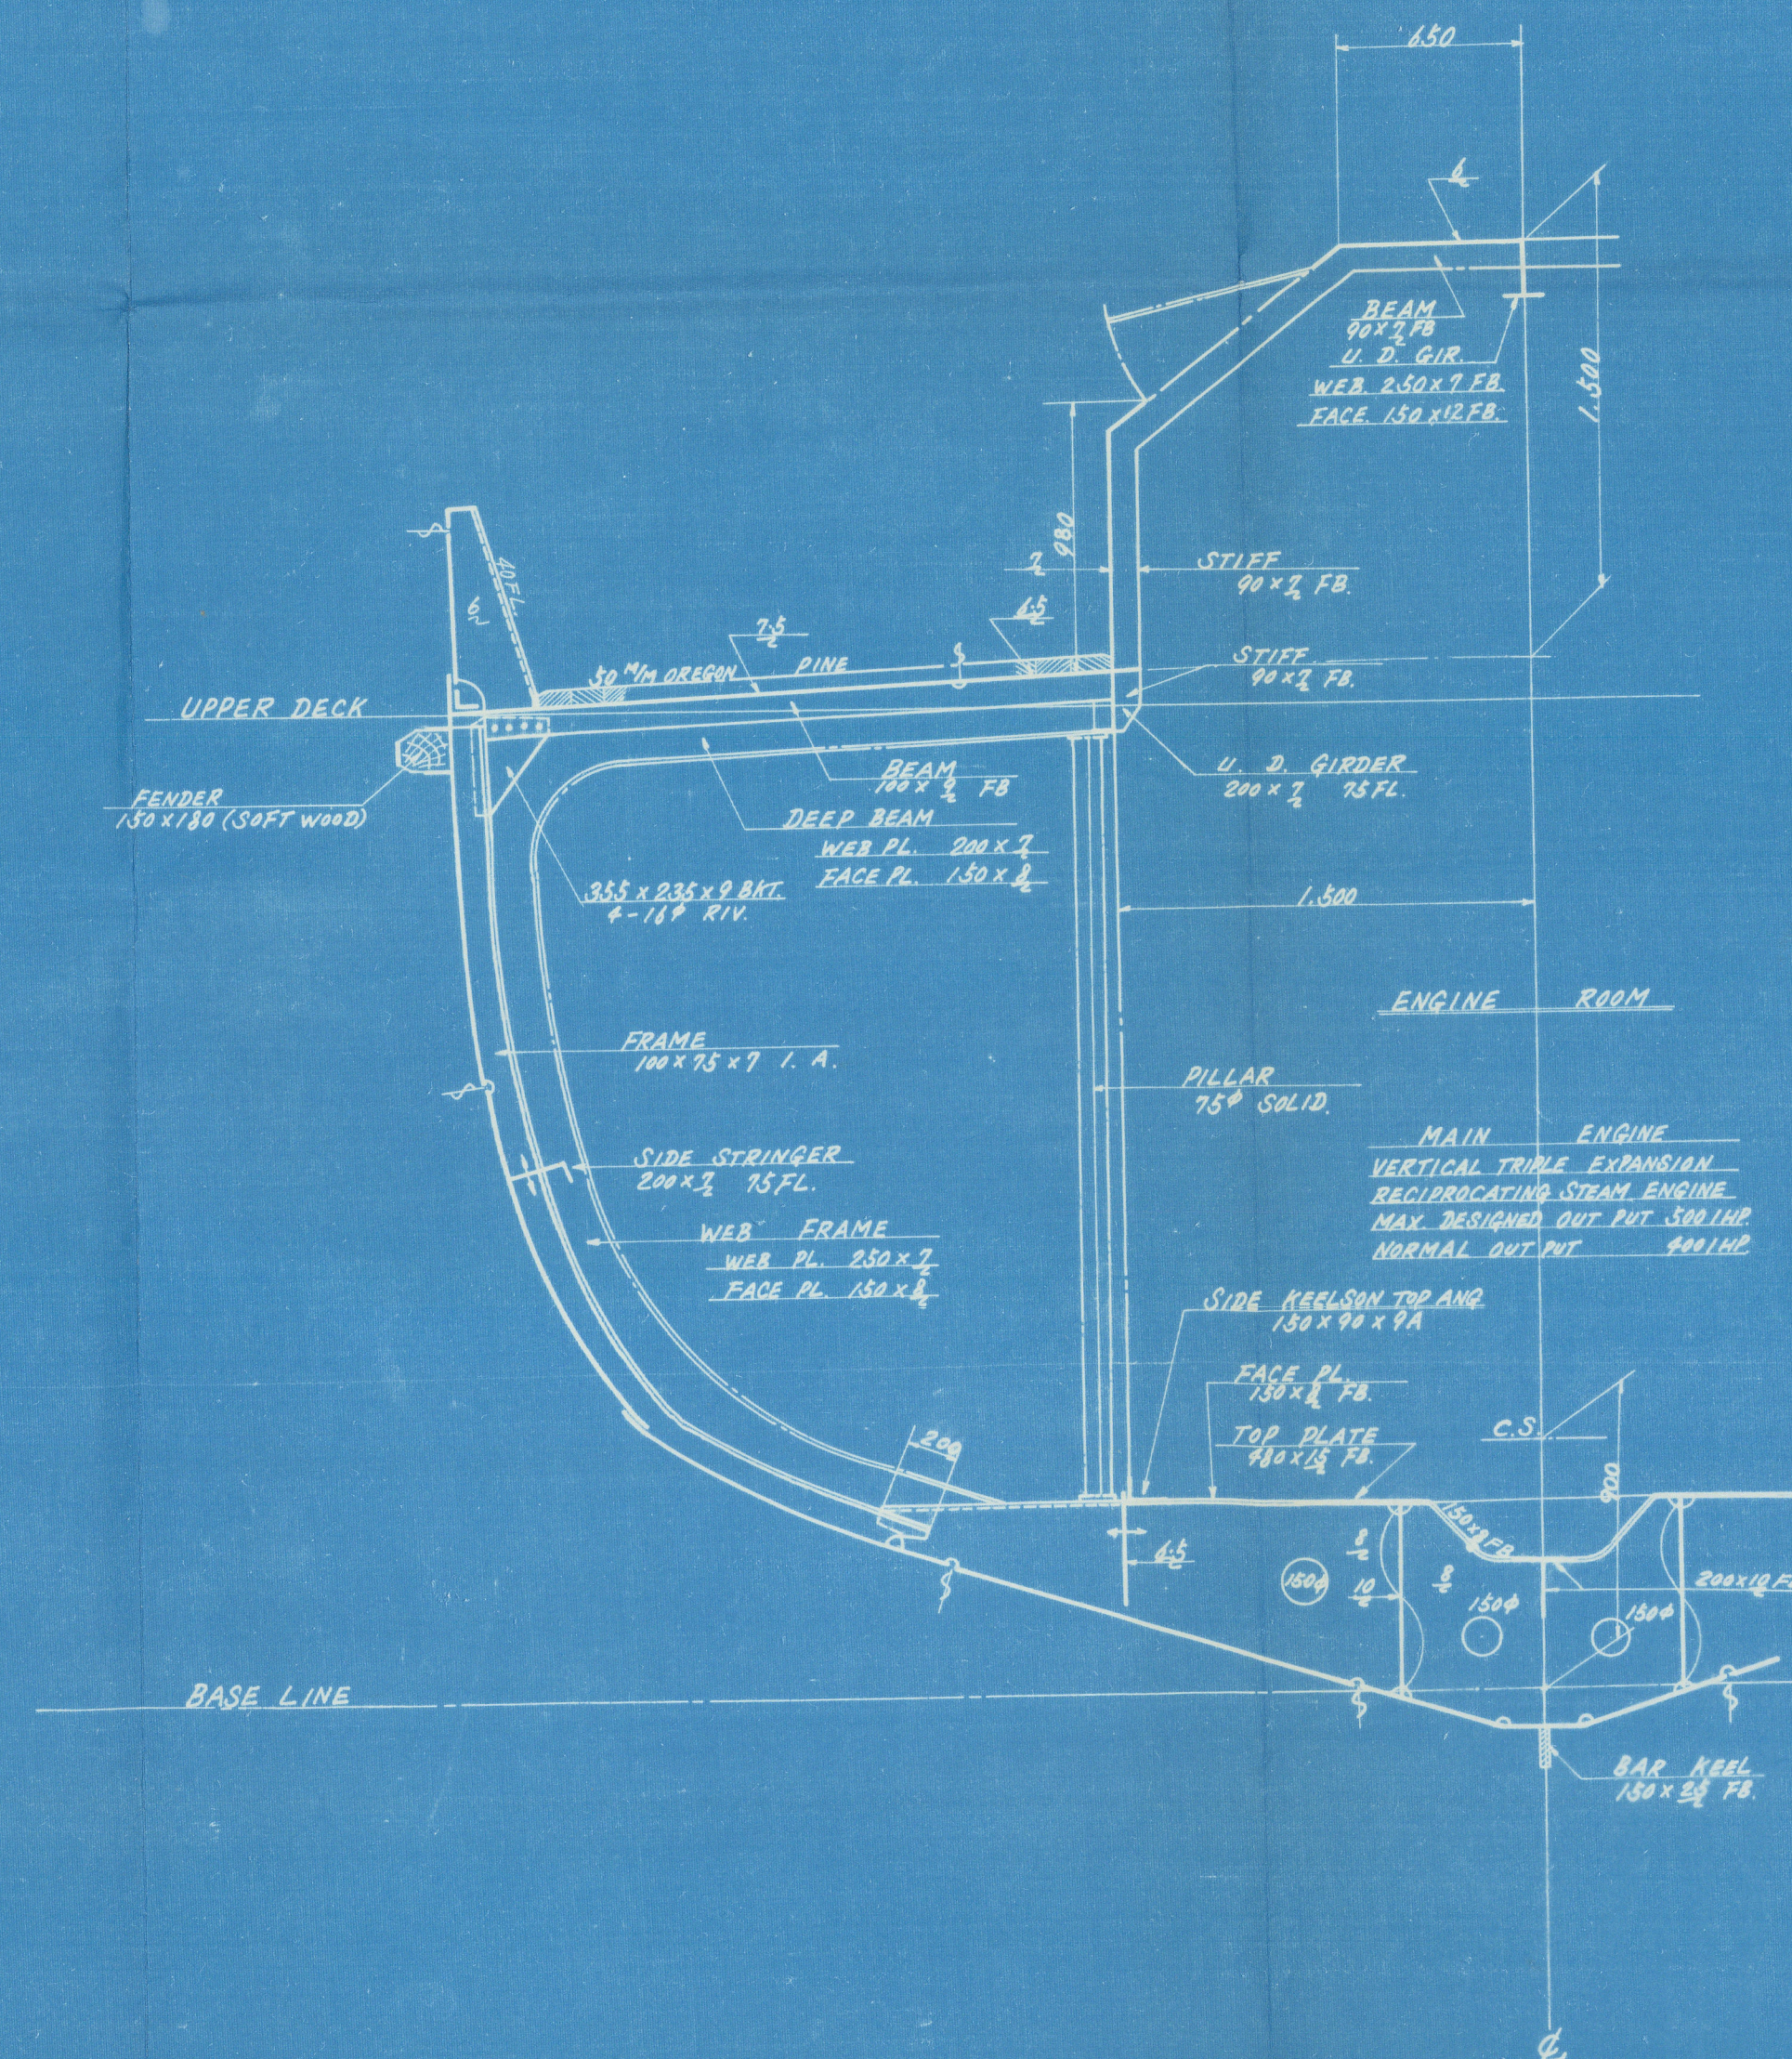

"JAGOCHA"

AS BUILT

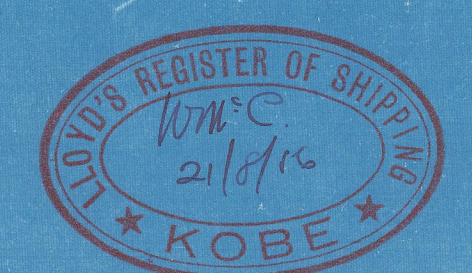

KOBE RPT. NO. 377P  
 DATED.

NAME OF PART	MATERIAL	UNIT WEIGHT	REMARKS
ЯГОЧА ½ СУДОИМПОРТ СССР			
MIDSHIP SECTION			
SCALE 1/25			
HITACHI SHIPBUILDING & ENGINEERING CO LTD	DRAWN BY		
MUKAISHIMA SHIPYARD	CHECKED BY		
SHIP DESIGNING SECTION	REVIEWED BY		
DATE	RELATED SECTION	CHIEF OF SECT	Y. Kosa
MANUF	NO	SHEET	NO
CODE	NO	DRAWING	21021