

M.V. EMPIRE TEDRITA. MIDSHIP SECTION AS FITTED.

SCALE $\frac{1}{2}$ " = ONE FOOT.

DIMENSIONS.
LENGTH BET. PP'S 190' 0" INS.
BREADTH MOULDED 32' 0" INS.
DEPTH MOULDED 14' 9" INS.

CLASS LLOYDS 100.A.1. CARRY PETROLEUM IN BULK.
WITH FREEBOARD CORRESPONDING TO A SUMMER
MOULDED DRAFT OF 13' 0 1/2" INS.



NUMERALS.

D	14-75
L x D	2803
L x (B + D)	8883
L + D	12-88




EQUIPMENT.

2 BOWER ANCHORS STOCKLESS EACH 2 1/4 CWTs
1 BOWER ANCHOR STOCKLESS SPARE 18 "
1 STREAM " EX. STOCK 5 1/2 "
210 FTMS 1 3/8" STUD LINK CABLE
60 " 3/4" G. 12 FLEXIBLE STEEL WIRE, STREAM.
90 " 3" " " " TOW WIRE.
90 " 2 1/2" " " " HAWSERS.
90 " 1 1/4" " " " WARPS.

STEM 6" 1 1/2"
FRAMING IN PEAKS SPACED 22"
" ELSEWHERE " 22 1/2"

BULB ANGLES ARE N.B.S.

TEST 5'-0" ABOVE CROWN.
CAMBER 7 1/2".

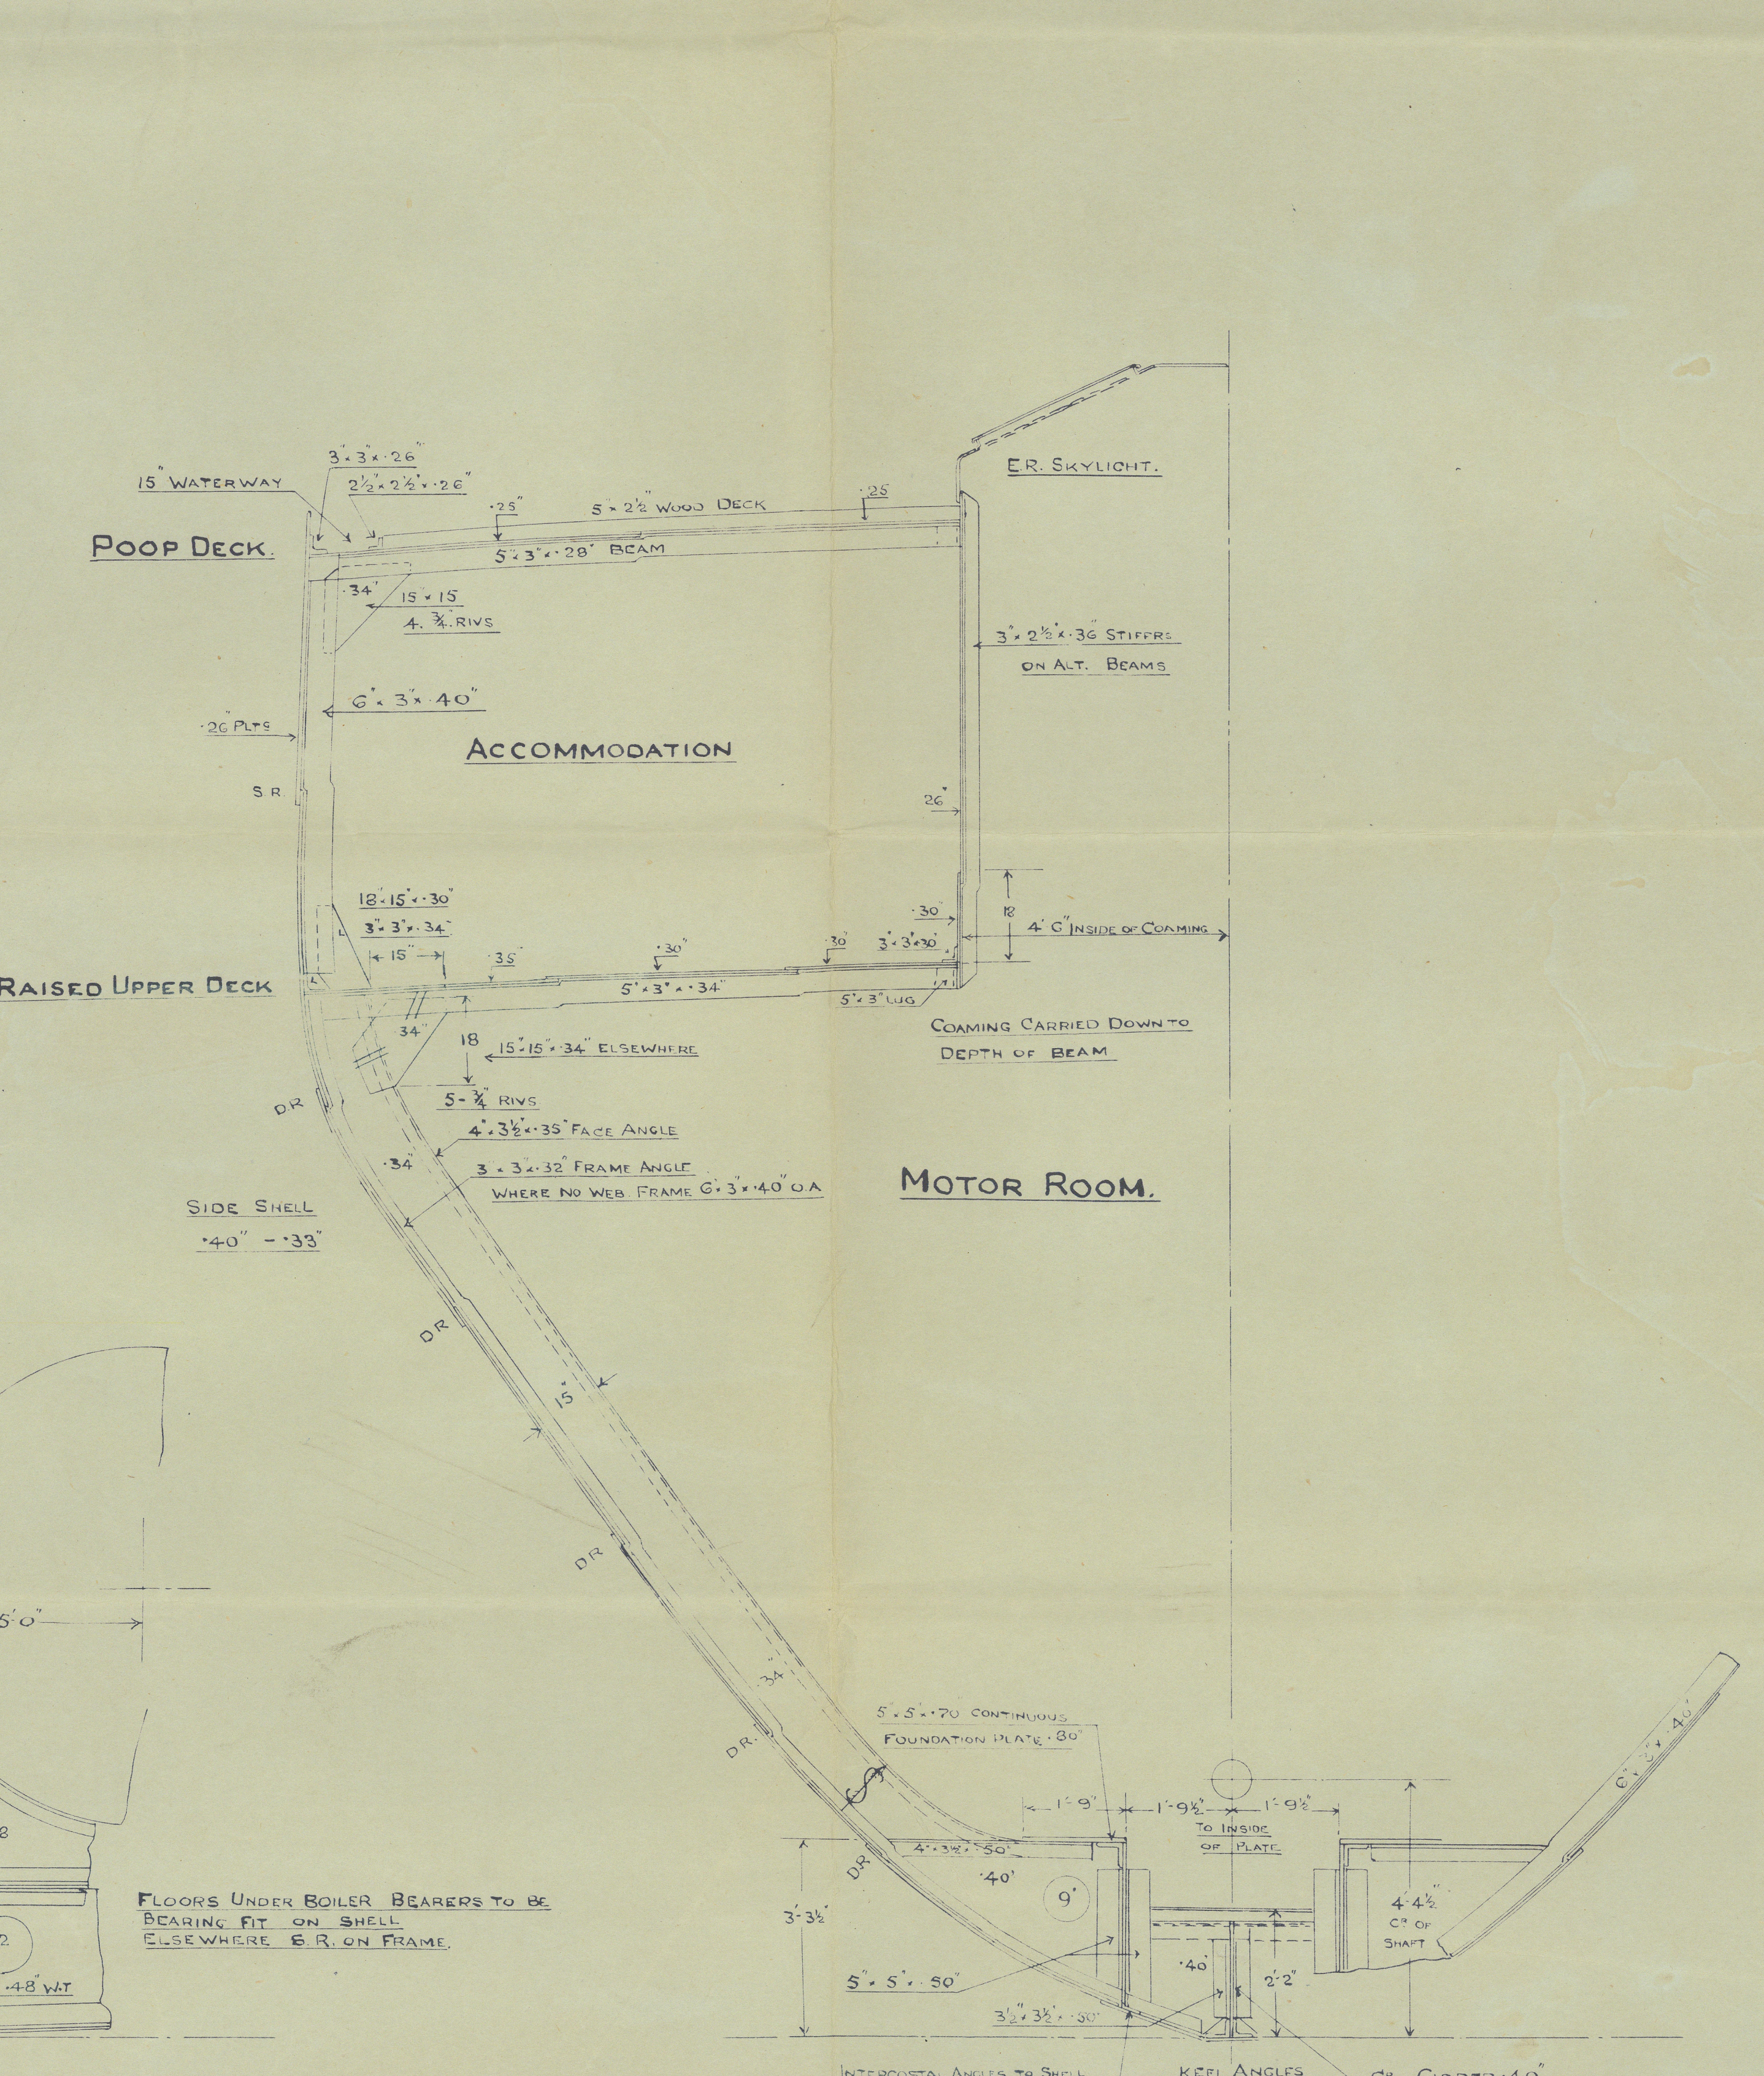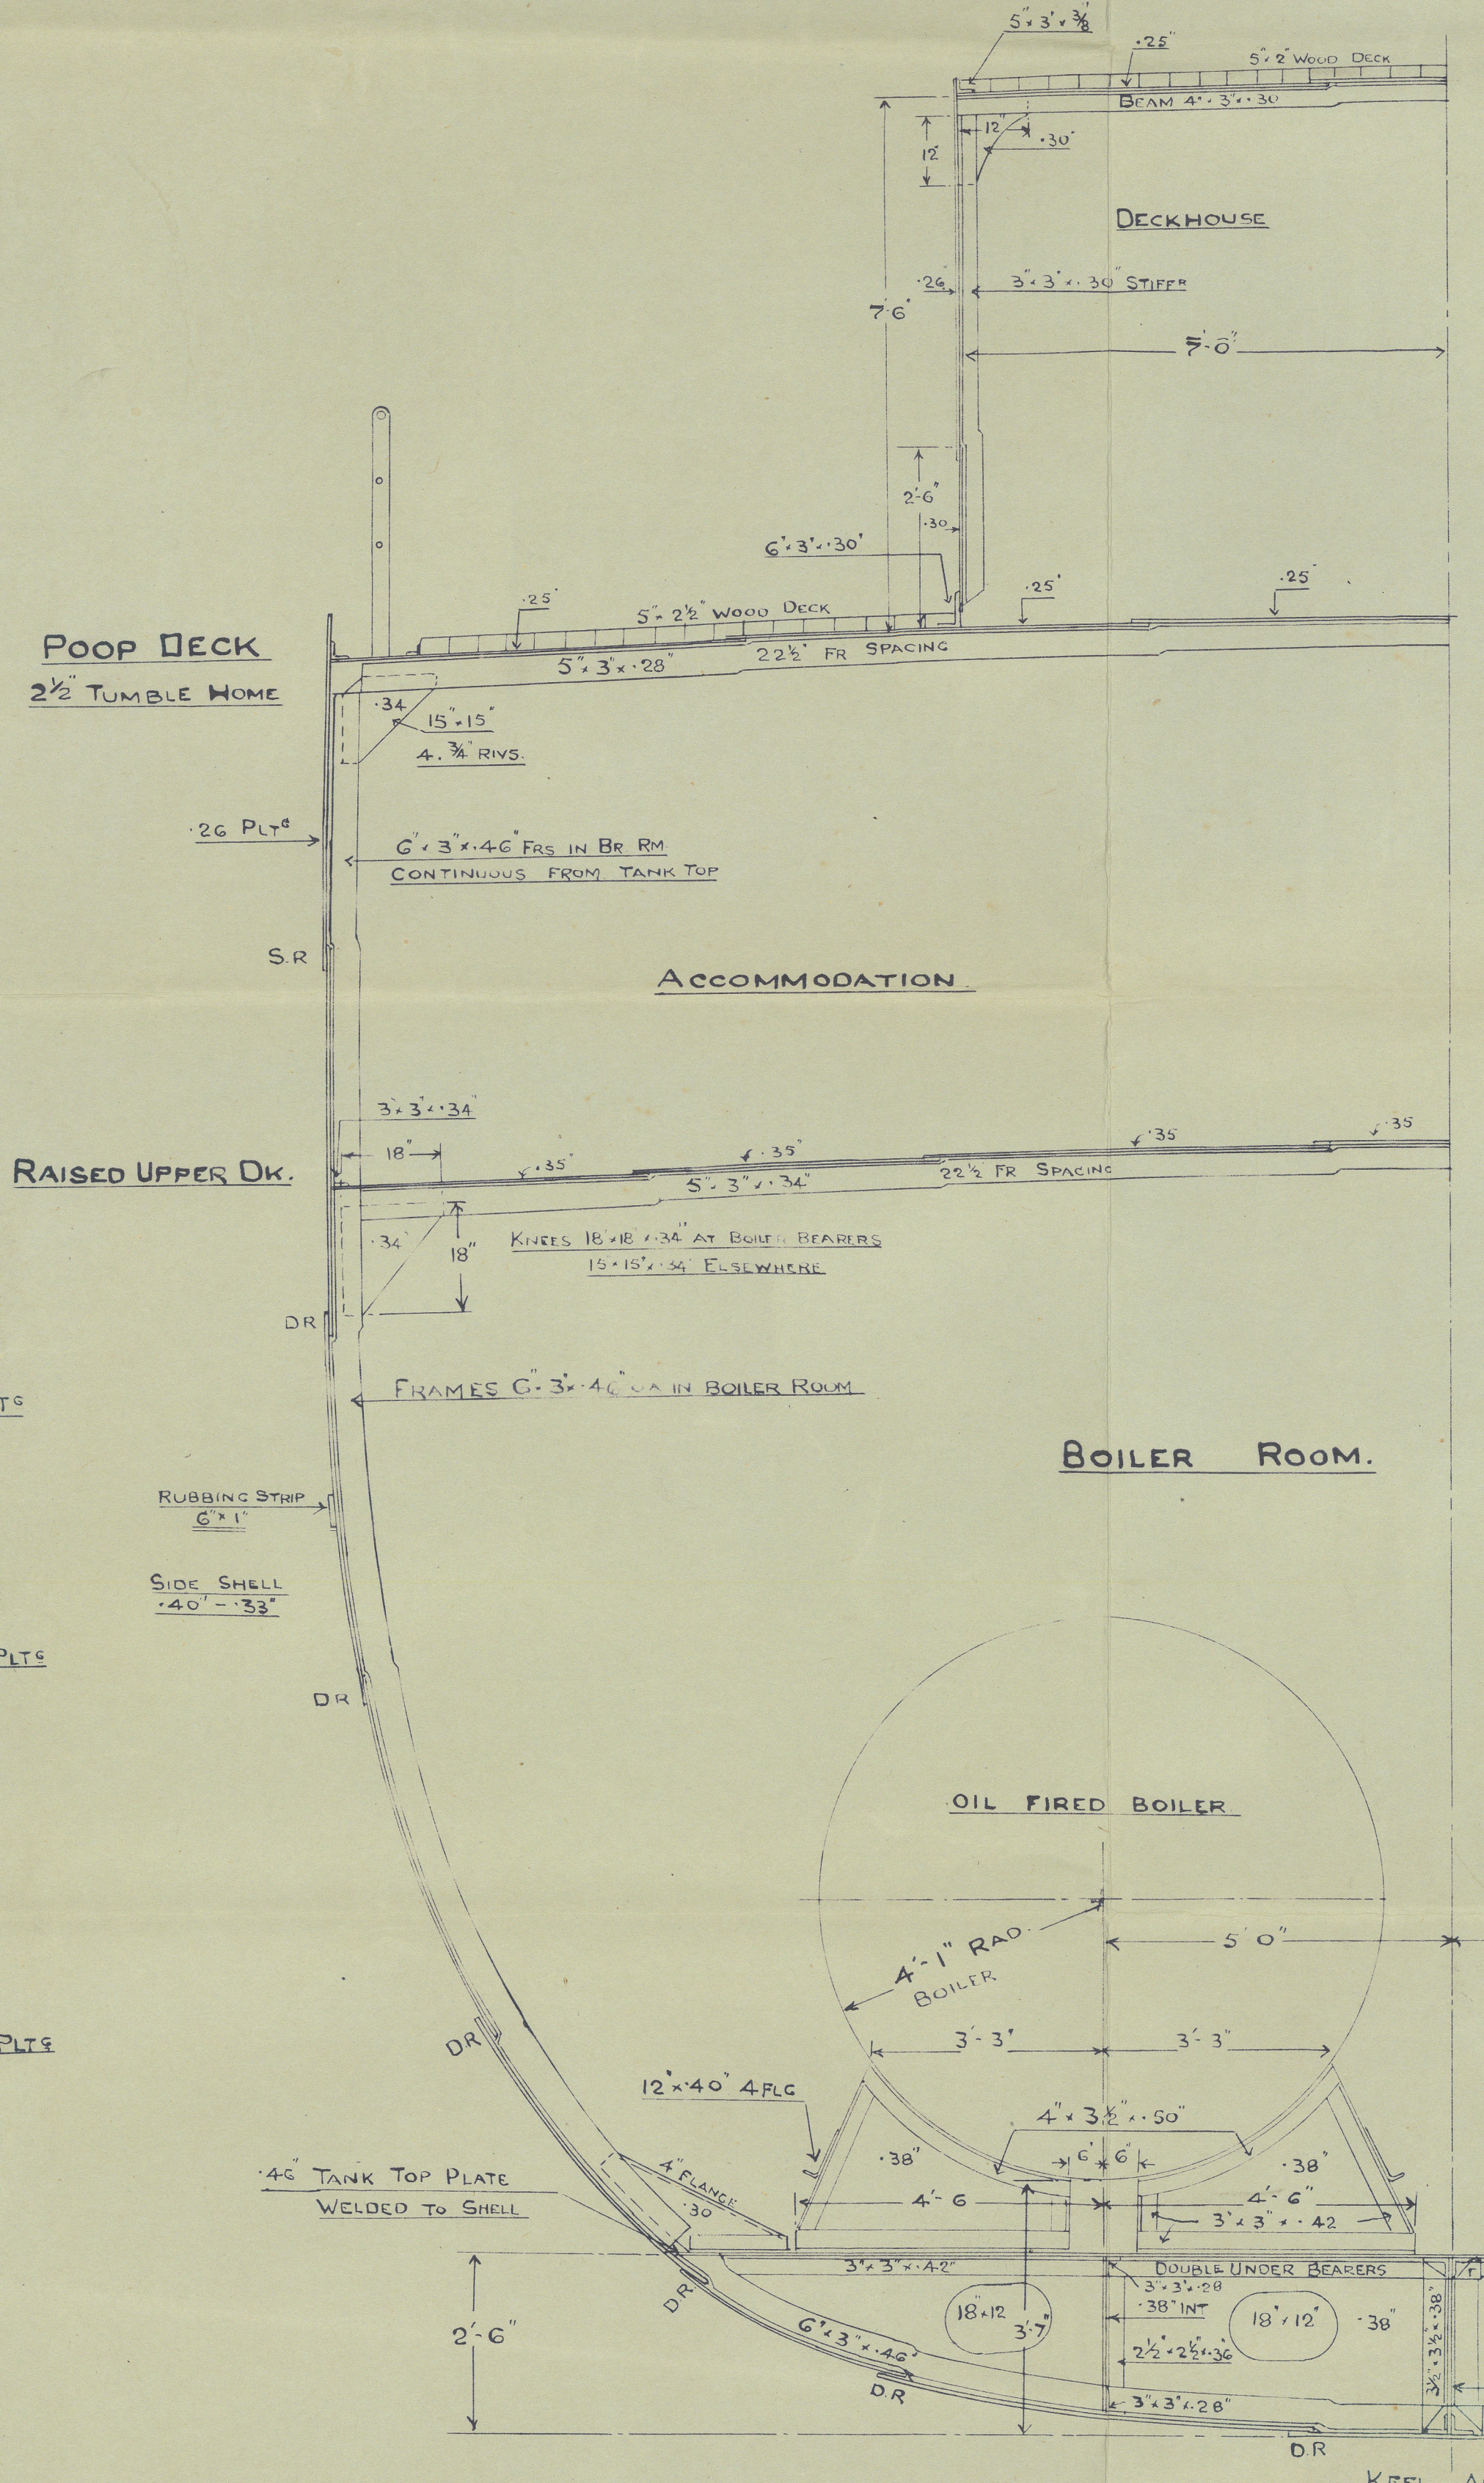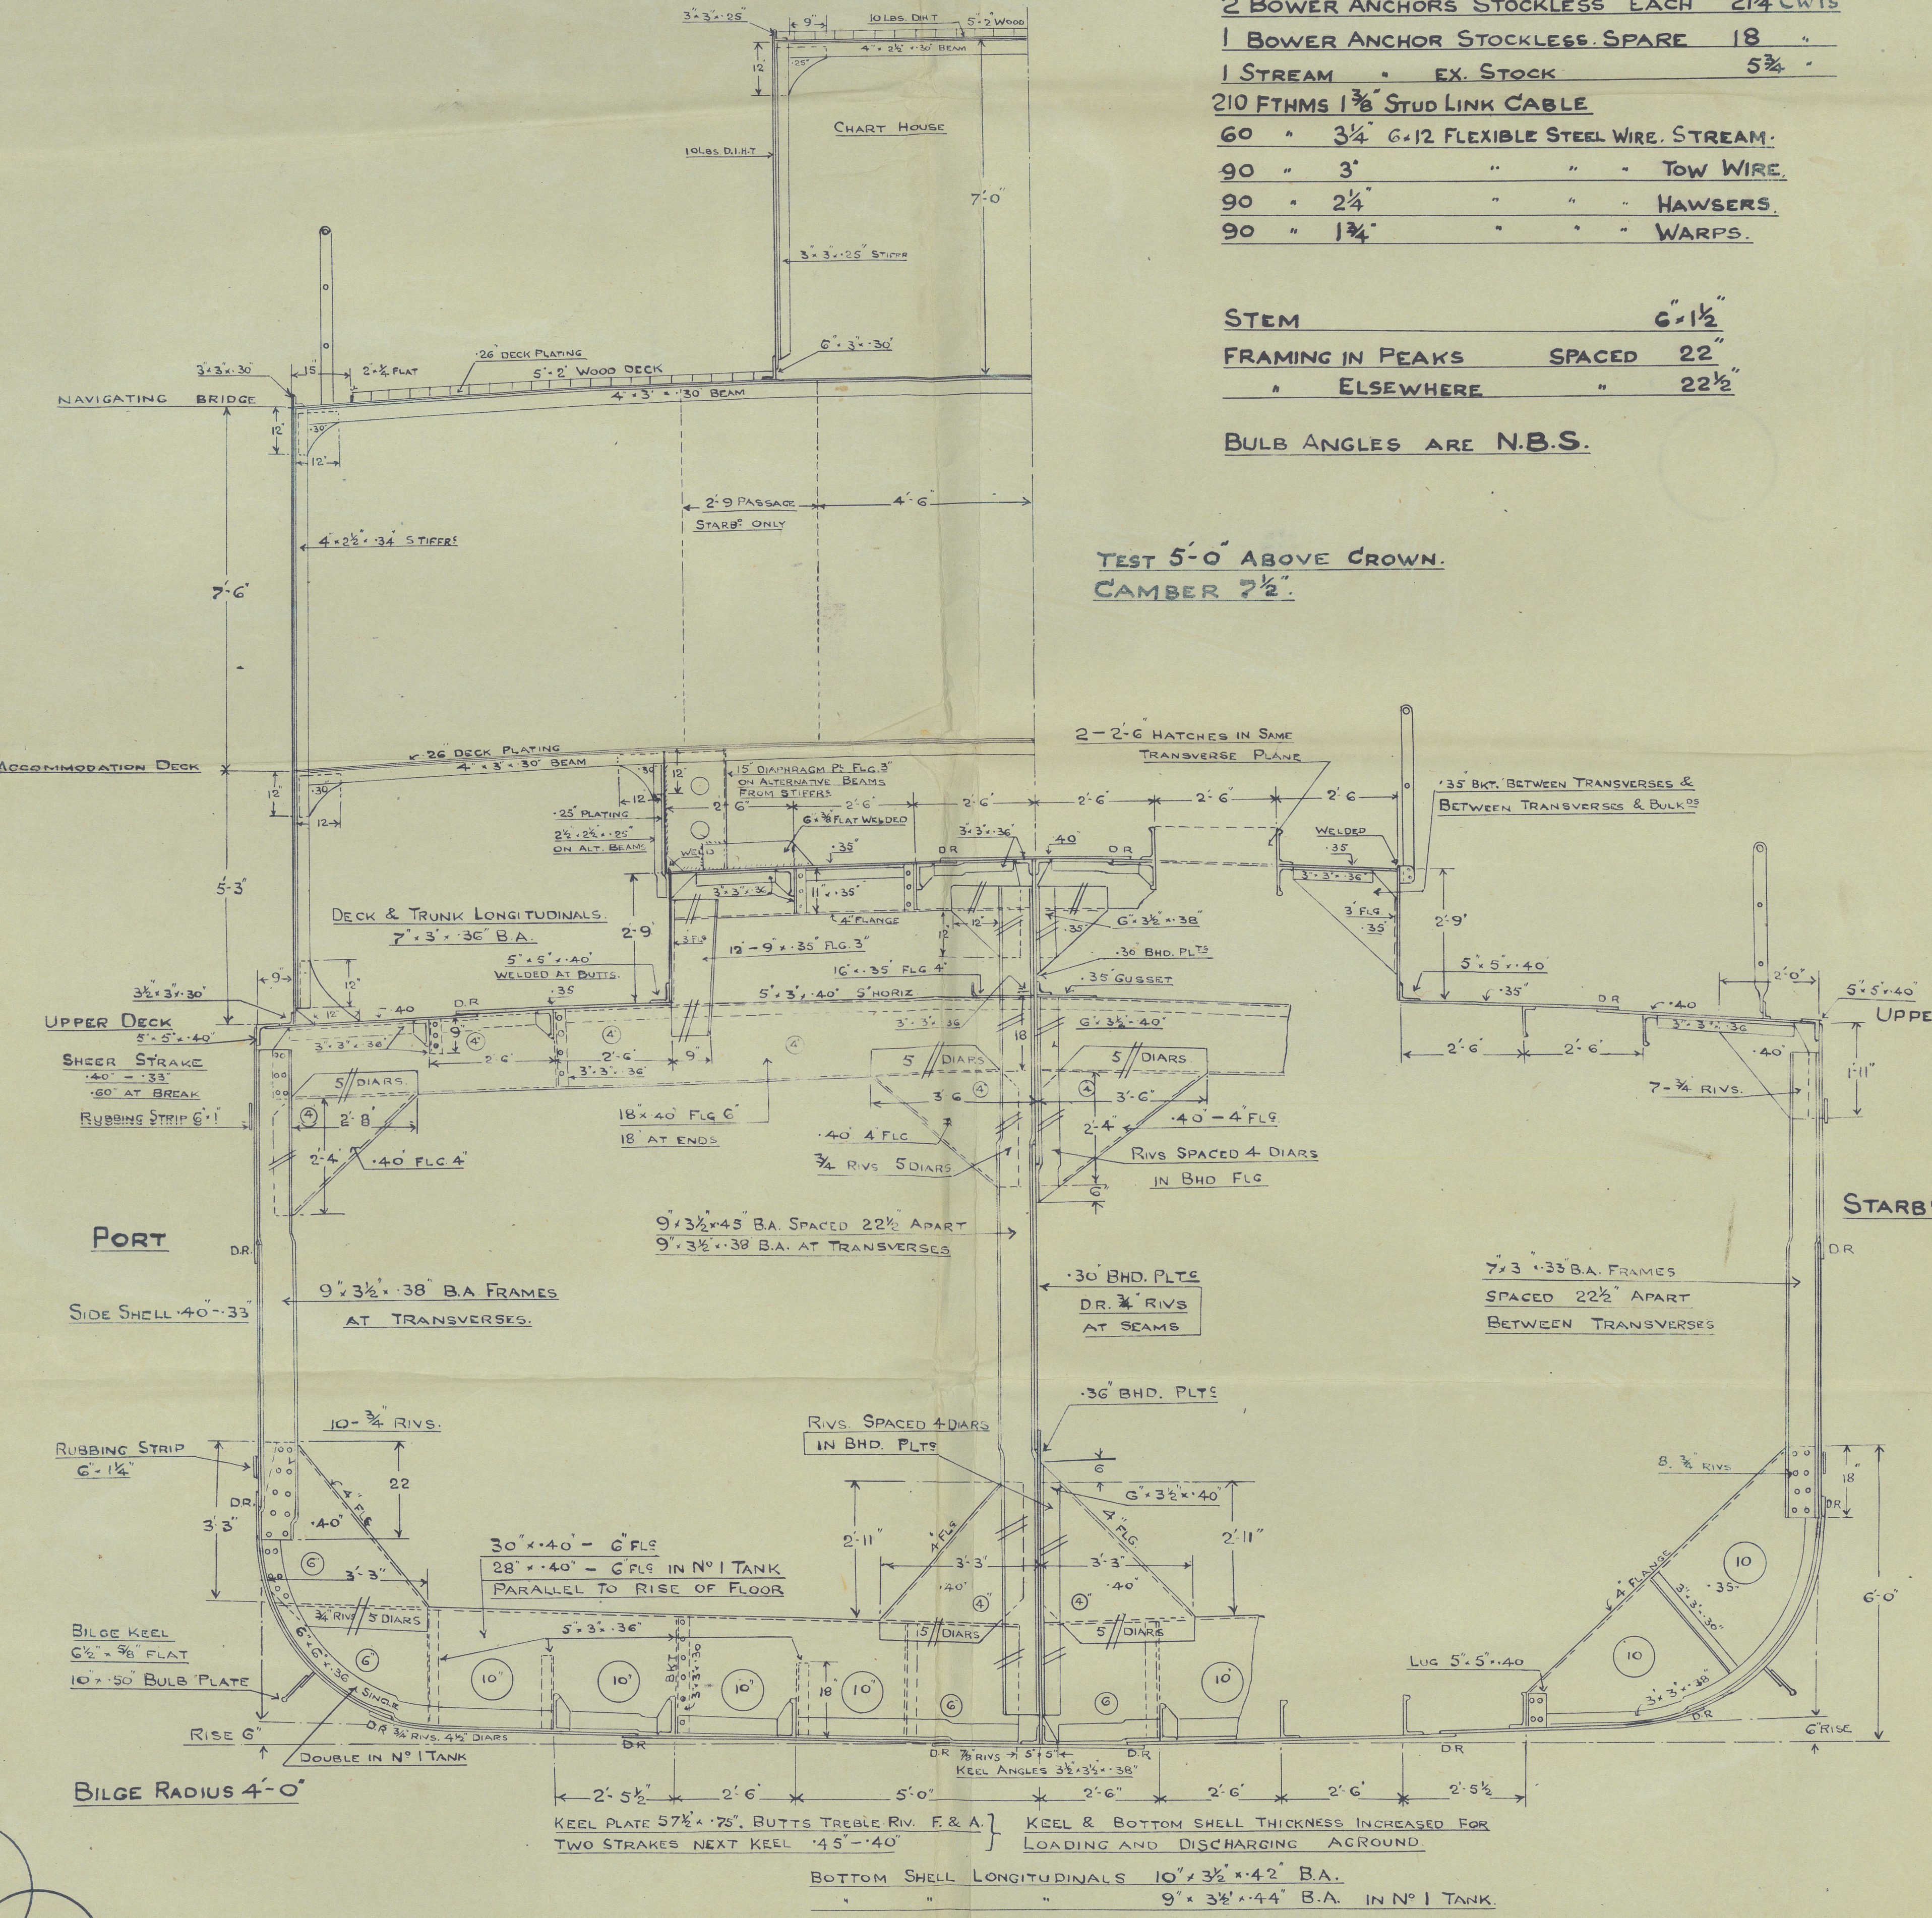


SECTION THRO' BOILER ROOM.
IN WAY OF N.W.T. FLOOR.

SECTION THRO' ENG. ROOM.
IN WAY OF WEB AT FRAME 14.

Ar. J. Inglis Esq

Yard no 1314^p

Empire Tedrita 

Medicine Section
(as built)

Glasgow Rm no 71055.




Ar. J. Inglis Esq

1313^p

Empire Tedrita

Glasgow Rm no 70705

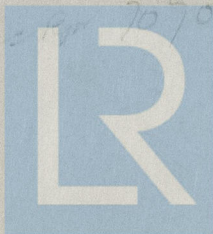

© 2021

Lloyd's Register
Foundation

014986-014985-01271