


"ITAIMBÉ"

Coupe longitudinale.
OF VESSEL
AS BUILT.

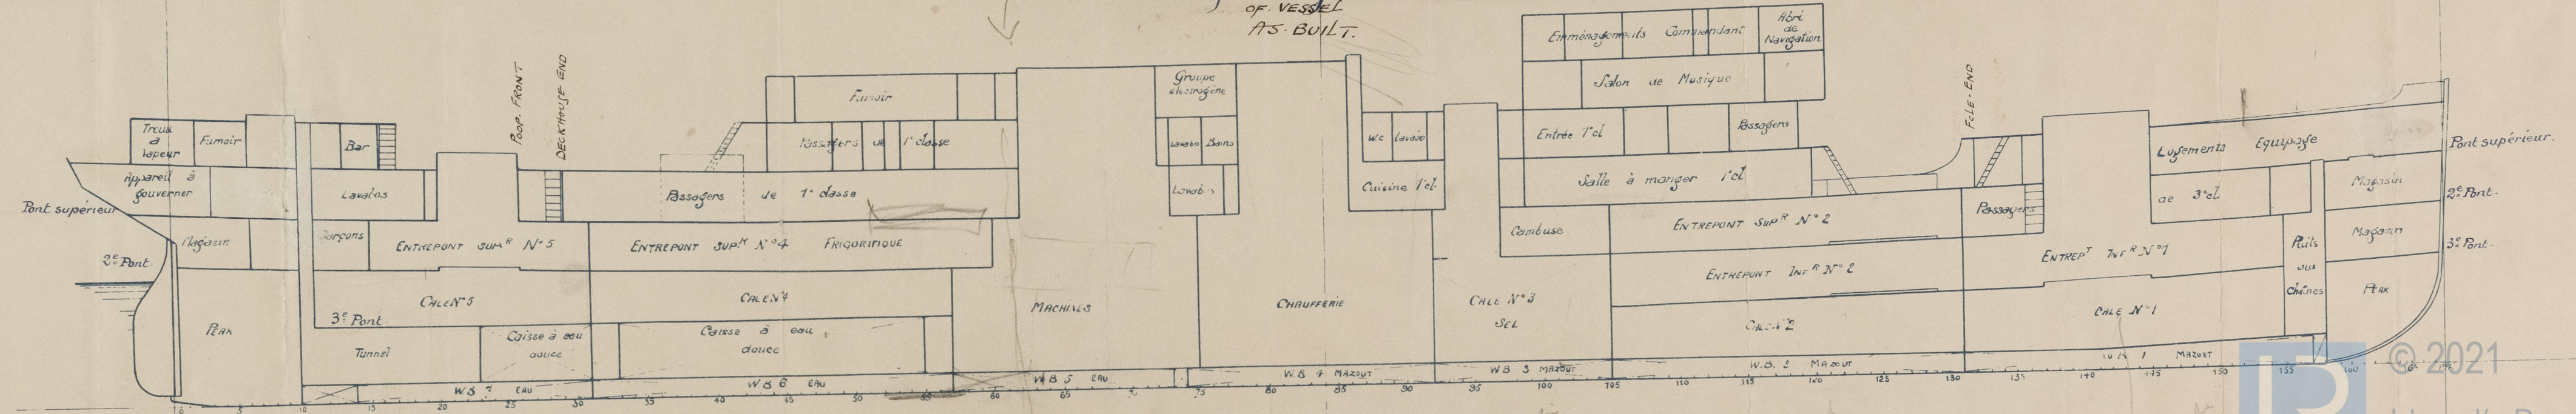

St. Kaimbe

Chartes de Penhoet
St. Nazaire

No 05

Outline Profile Shewing
vessel as built
including modified portions
of, poop & fore ends, bulwarks,
bulkheads &c.

Chartes de Penhoet

1507

015102-015110-0084

St. Nazaire

14/2/27



© 2021

Lloyd's Register
Foundation