

— SHIP N^o Y.C.325 —

— DIMENSIONS —

LENGTH B.P. — 105'-0"



BREADTH MLD — 33'-0"

DEPTH MLD — 14'-6"

FOR DETAILS OF MAST
SEE "RIGGING PLAN"

— SCALE 1/4" TO ONE FOOT —

— GENERAL ARRANGEMENT PART I. —

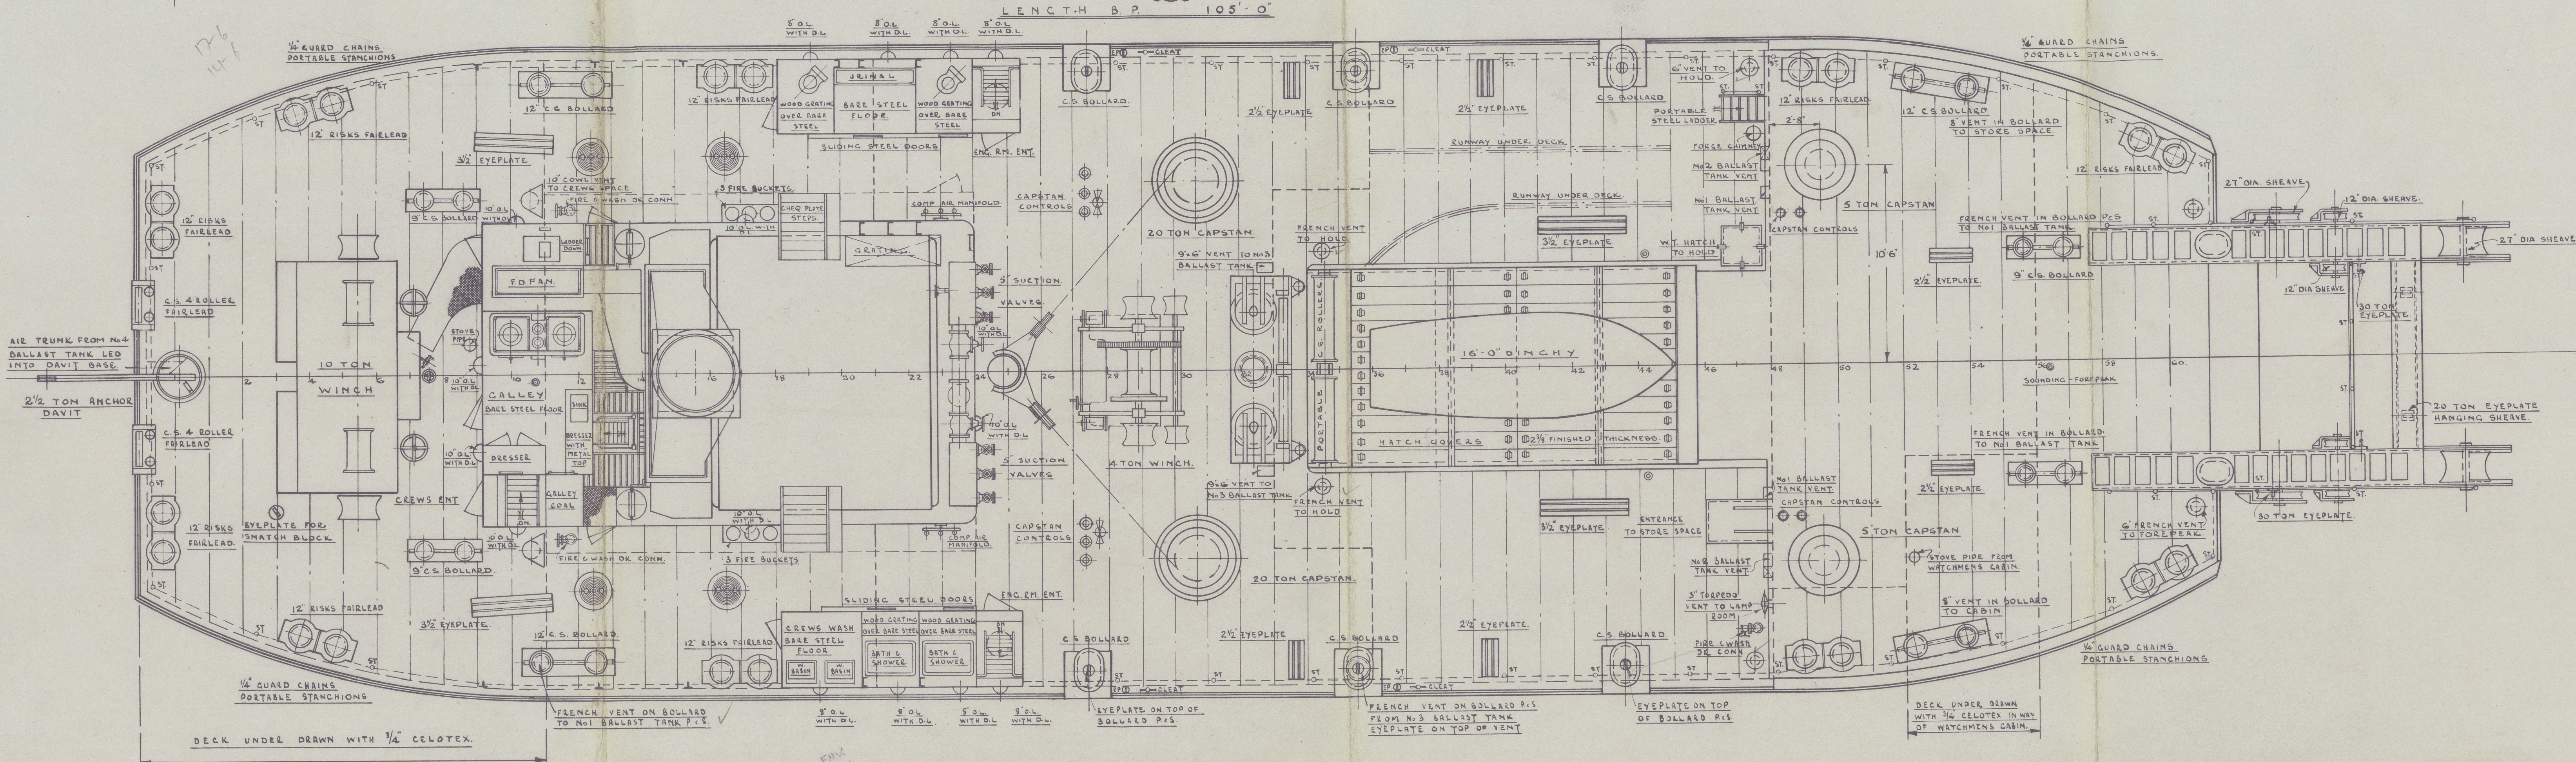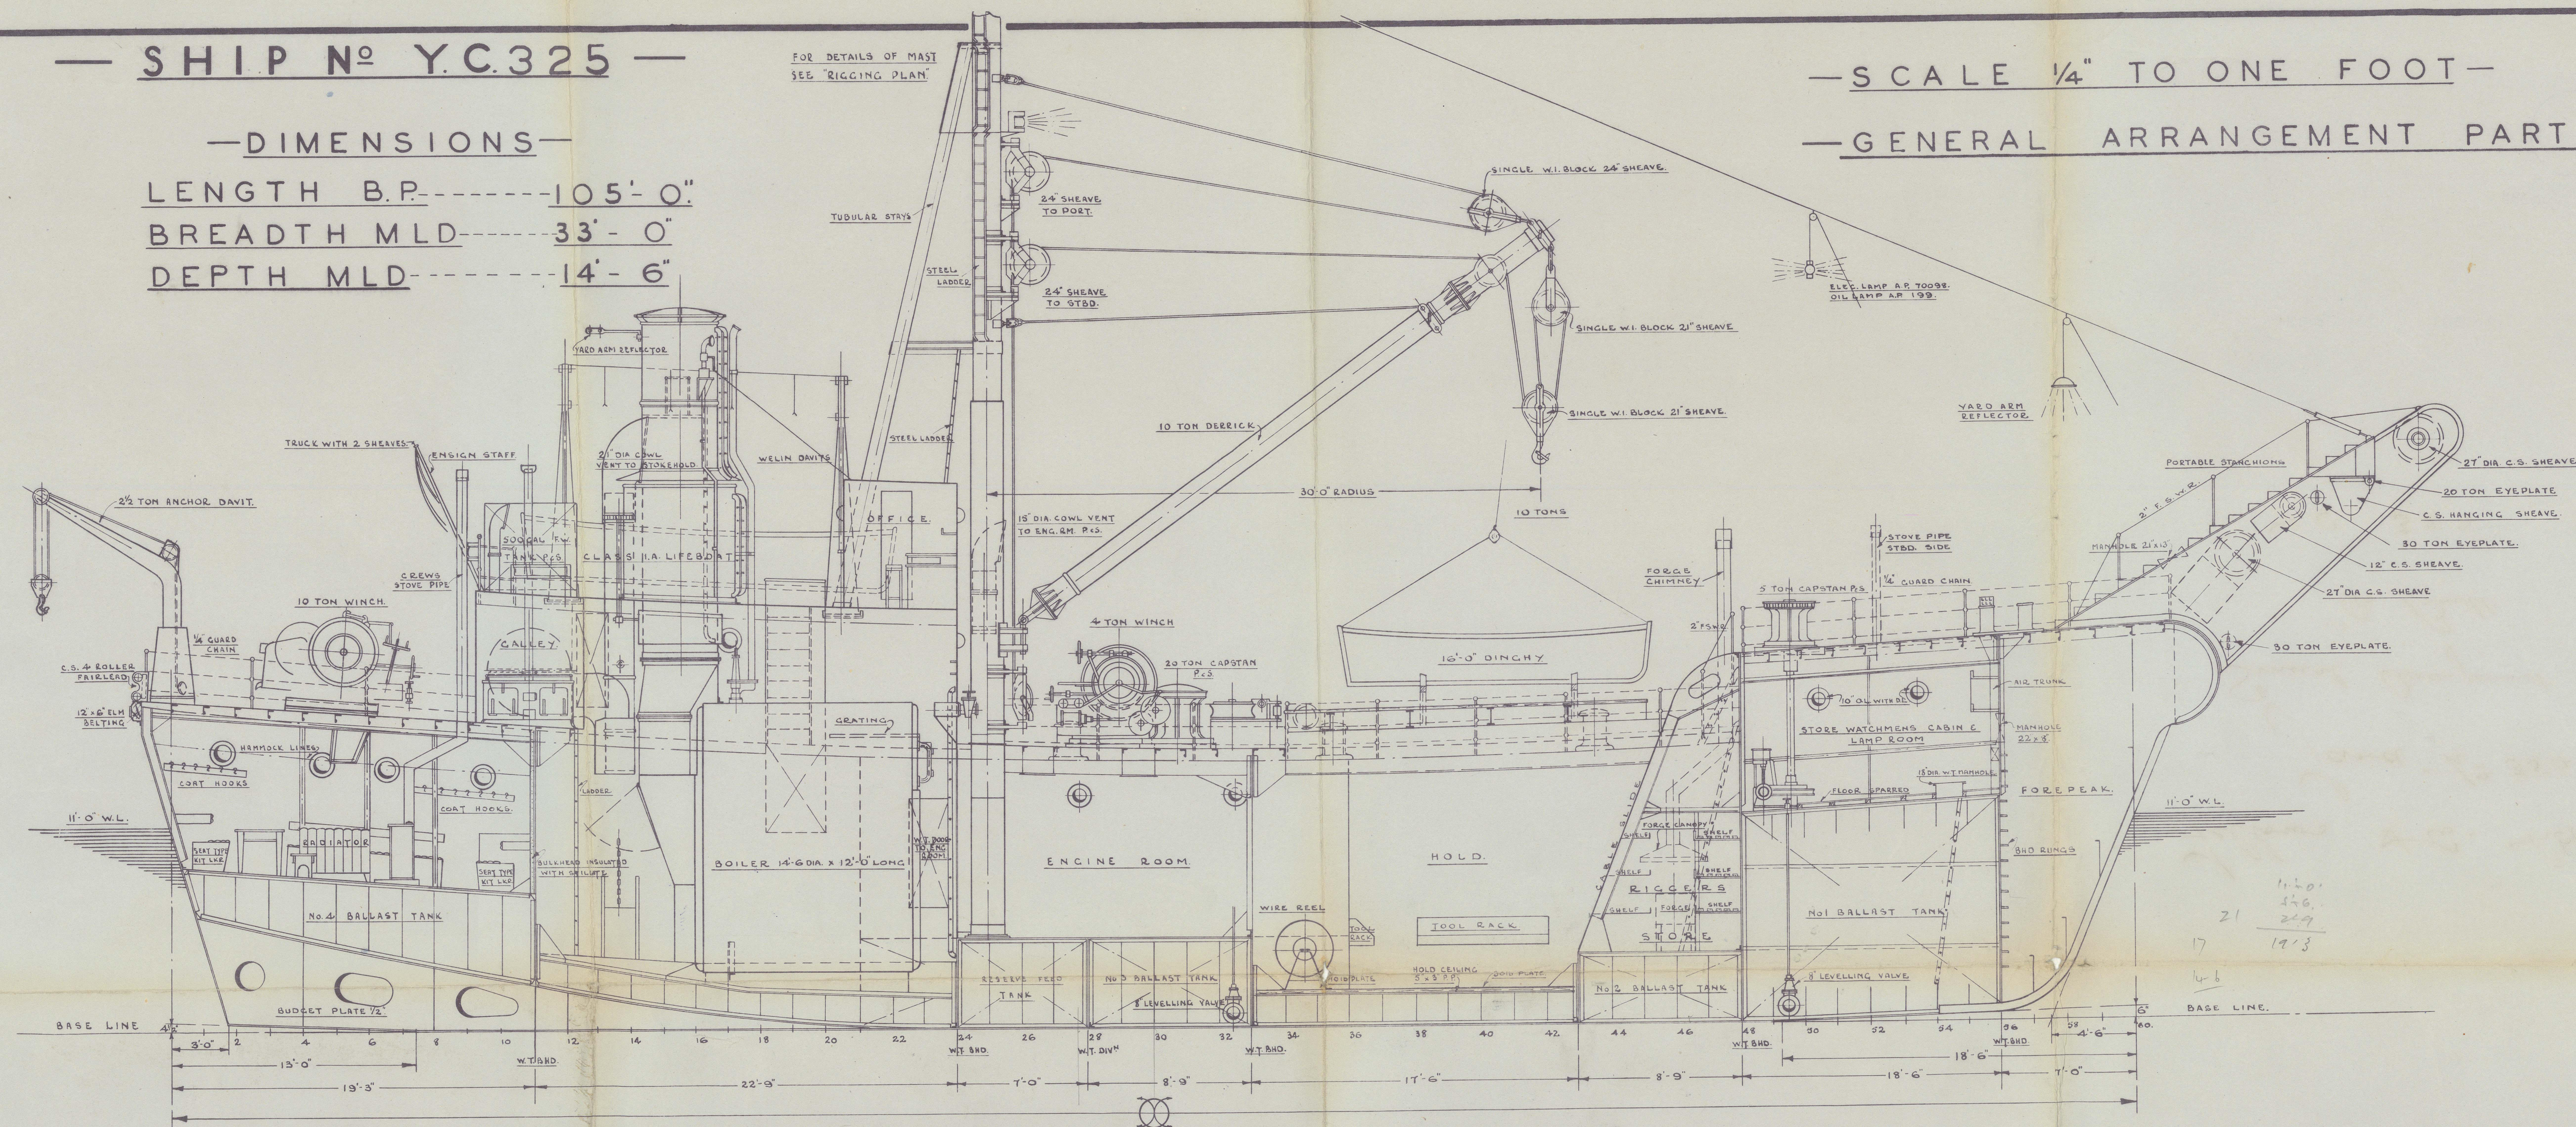


Mooreport
Fellows & Co. Ltd.,

Land n^o 354.


General Arrangement Part: 1.

"As Built".

Y.C. 325 

GENERAL ARRGT. PART 1.

RECORDS DEPT.,
LONDON.

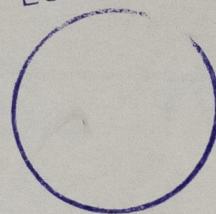

015284-015291-0032



© 2021

Lloyd's Register
Foundation