

Copy

Same as Budget

Scott & Co's
Shipbuilders
Bowling

Raised Quarter Deck 4 ft high, Topgallant Forecastle 6 ft high
The following additions to requirements of rules included under viz.
Keel $\frac{1}{2}$ thicker, $\frac{1}{2}$ deeper, Stem 1" broader, $\frac{1}{2}$ thicker Stern Post 1" broader
Rudder stock $\frac{1}{2}$ more in dia. Two web frames in hold on each side
under Main Deck. Stud chain cable $\frac{1}{6}$ thicker Stringers 10" broader

S.S. No 77

Scale $\frac{1}{2}$ " = one Foot


FRAMEWORK IRON
SHELL PLATING STEEL

S.S. "Cornelian"

as built

12/3/90

Jy.

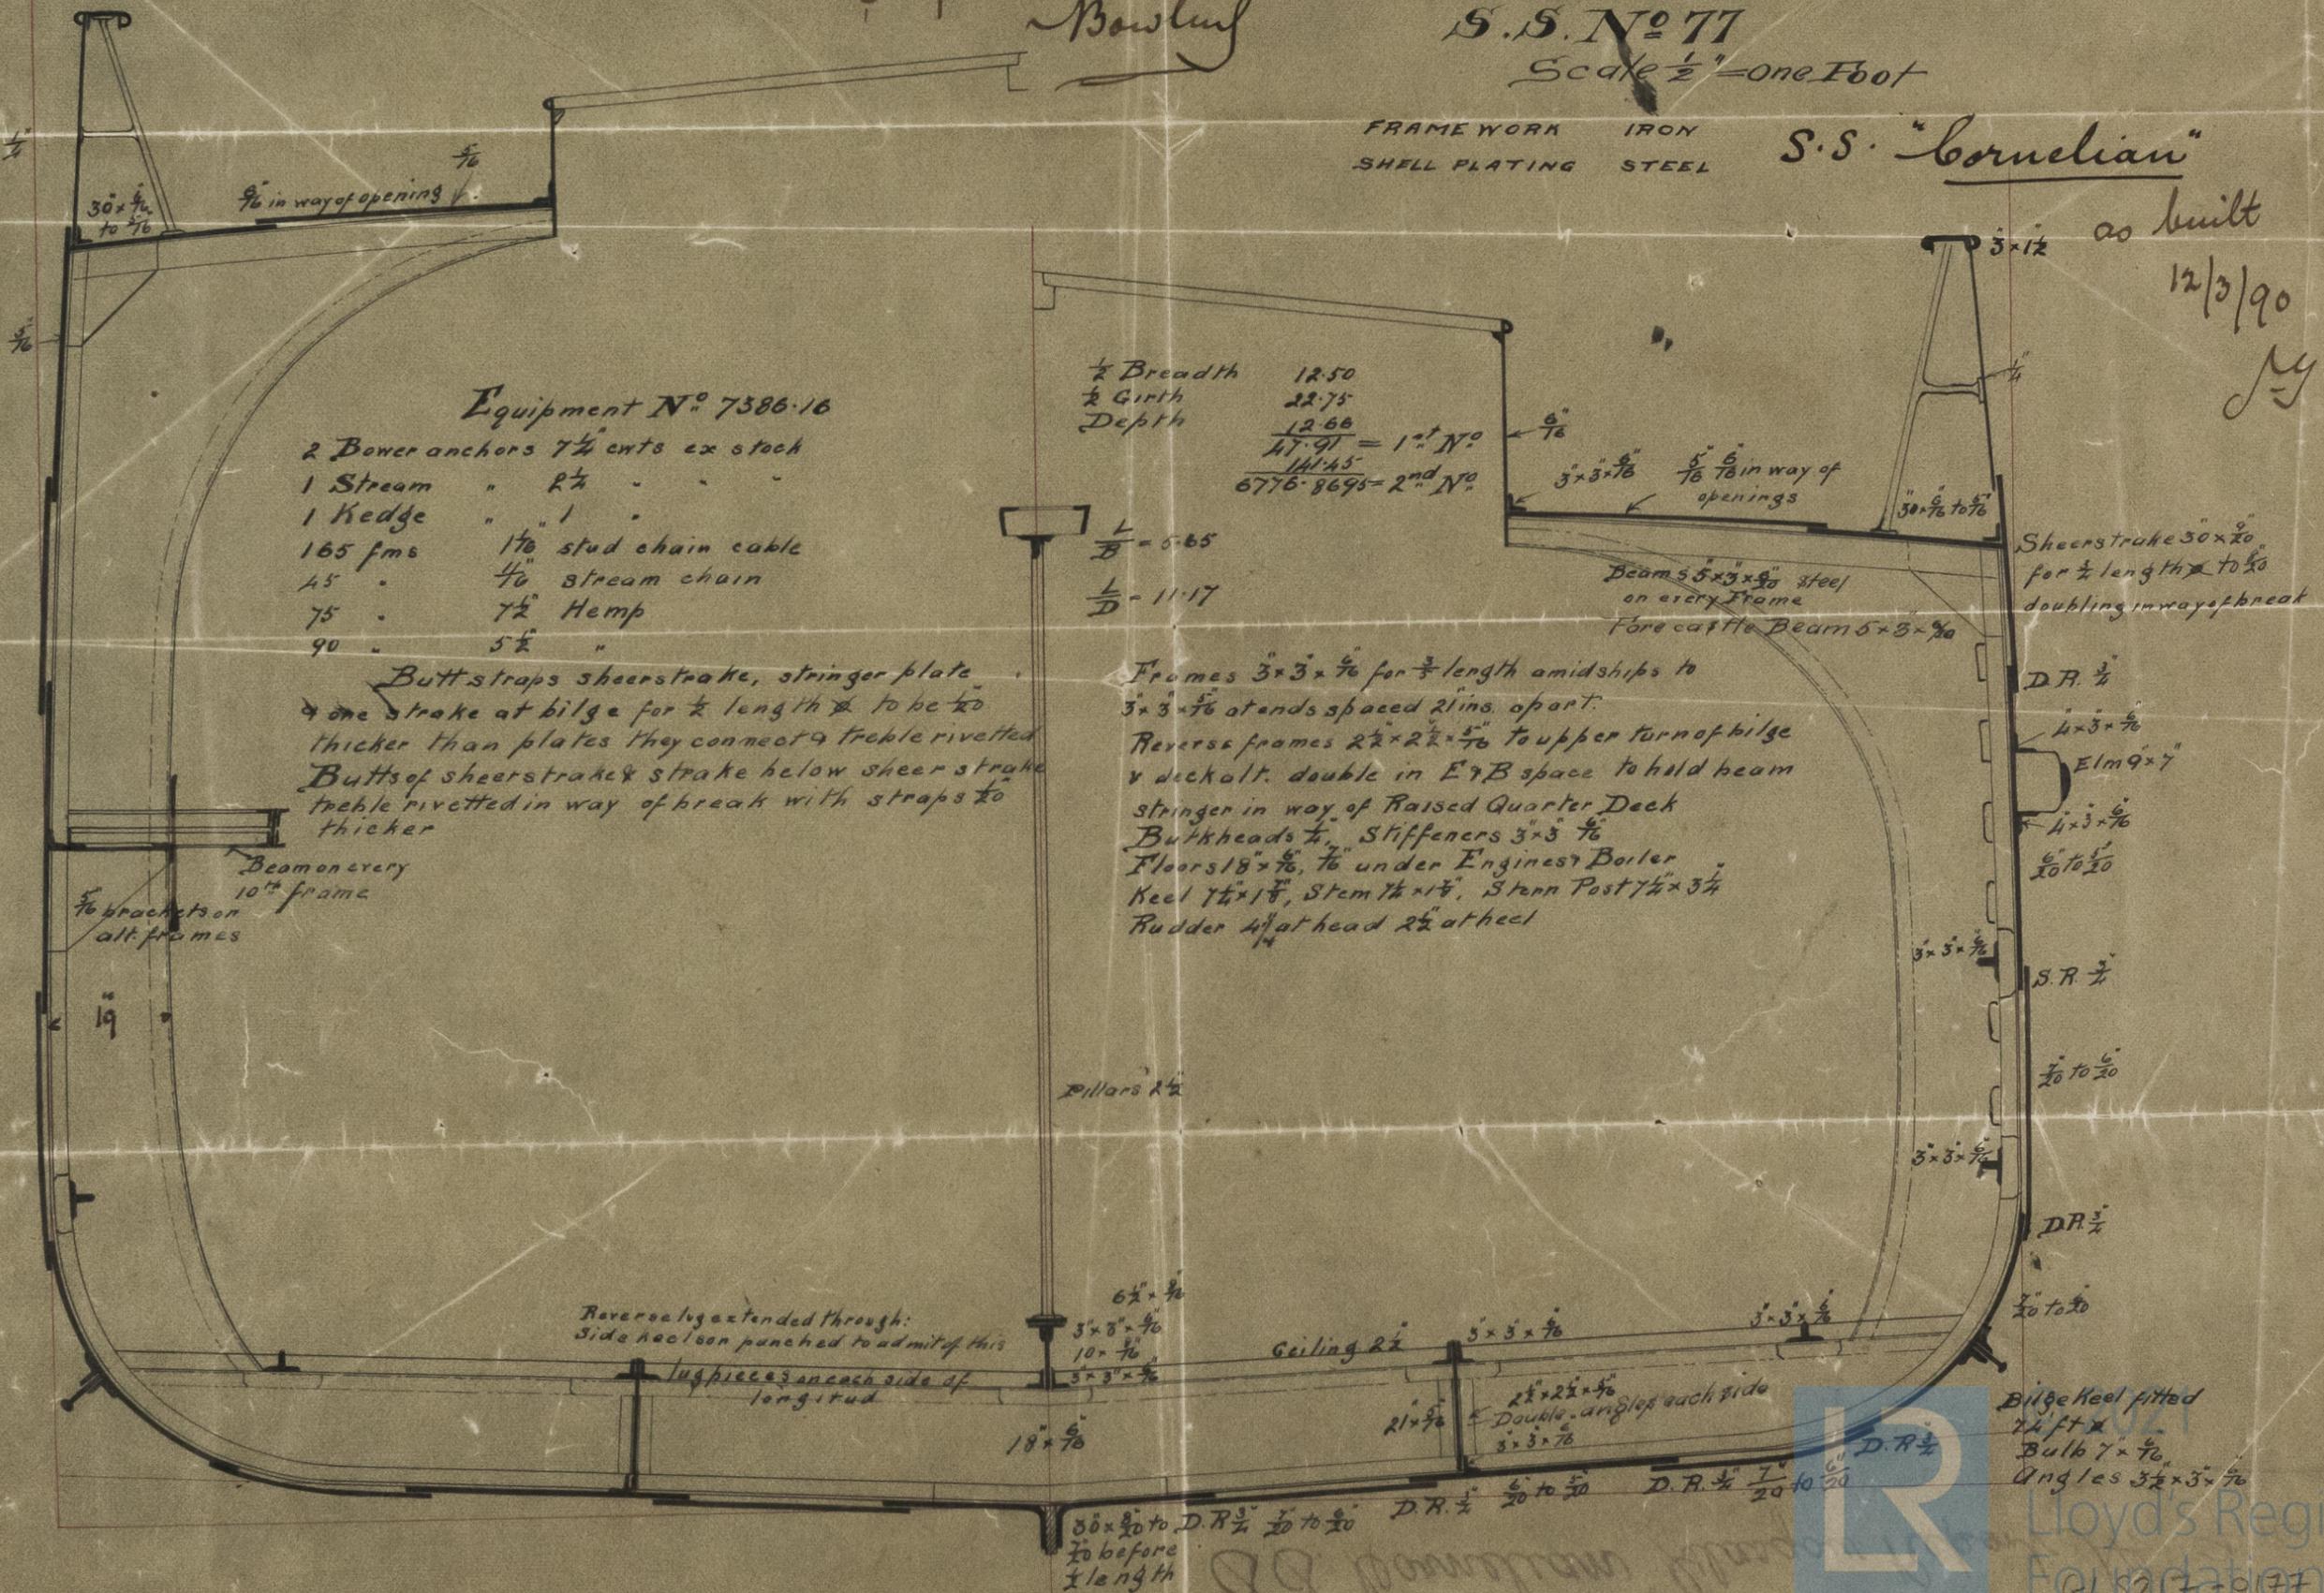

- Equipment No 7386-16
- 2 Bower anchors $7\frac{1}{2}$ cts ex stock
 - 1 Stream " $2\frac{1}{2}$ "
 - 1 Kedge " 1 "
 - 165 fms $1\frac{1}{16}$ stud chain cable
 - 45 " $\frac{4}{16}$ stream chain
 - 75 " $7\frac{1}{2}$ Hemp
 - 90 " $5\frac{1}{2}$ "

$\frac{1}{2}$ Breadth	12.50
$\frac{1}{2}$ Girth	22.75
Depth	$\frac{12.66}{17.91} = 1^{st}$ No
	$\frac{14.45}{6776-8695} = 2^{nd}$ No

$\frac{L}{B} = 5.65$
 $\frac{L}{D} = 11.17$

Butt straps sheerstrake, stringer plate
& one strake at bilge for $\frac{1}{2}$ length & to be $\frac{1}{2}$
thicker than plates they connect & treble rivetted
Butts of sheerstrake & strake below sheer strake
treble rivetted in way of break with straps $\frac{1}{2}$
thicker

Frames $3 \times 3 \times \frac{5}{8}$ for $\frac{1}{3}$ length amidships to
 $3 \times 3 \times \frac{5}{8}$ at ends spaced 2 ins. apart.
Reverse frames $2\frac{1}{2} \times 2\frac{1}{2} \times \frac{5}{8}$ to upper turn of bilge
& deck alt. double in E & B space to hold beam
stringer in way of Raised Quarter Deck
Bulkheads $\frac{1}{2}$, Stiffeners $3 \times 3 \times \frac{5}{8}$
Floors $18 \times \frac{5}{8}$, $\frac{1}{16}$ under Engines & Boiler
Keel $1\frac{1}{2} \times 1\frac{1}{8}$, Stem $1\frac{1}{2} \times 1\frac{1}{8}$, Stern Post $7\frac{1}{2} \times 3\frac{1}{4}$
Rudder $4\frac{1}{4}$ at head $2\frac{1}{2}$ at heel

Sheerstrake 30×20
for $\frac{1}{2}$ length & to $\frac{1}{2}$
doubling in way of break

D.R. $\frac{3}{4}$
 $4 \times 3 \times \frac{5}{8}$
Elm 9×7
 $4 \times 3 \times \frac{5}{8}$
 20 to 20

S.R. $\frac{3}{4}$
 20 to 20

D.R. $\frac{3}{4}$
 20 to 20

Bilge Keel fitted
 $2\frac{1}{2}$ ft x
Bulb $7 \times \frac{5}{8}$
Angles $3\frac{1}{2} \times 3 \times \frac{5}{8}$



Lloyd's Register
Foundation

