


13/9/89 23/9/89

S. S. "Rotokino"
Glasgow Report


19/2/10
as built
"Rotokino"

[Handwritten signature]

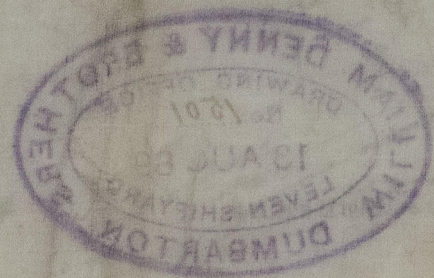

FORECASTLE
27-6-21-3

L.OYDS

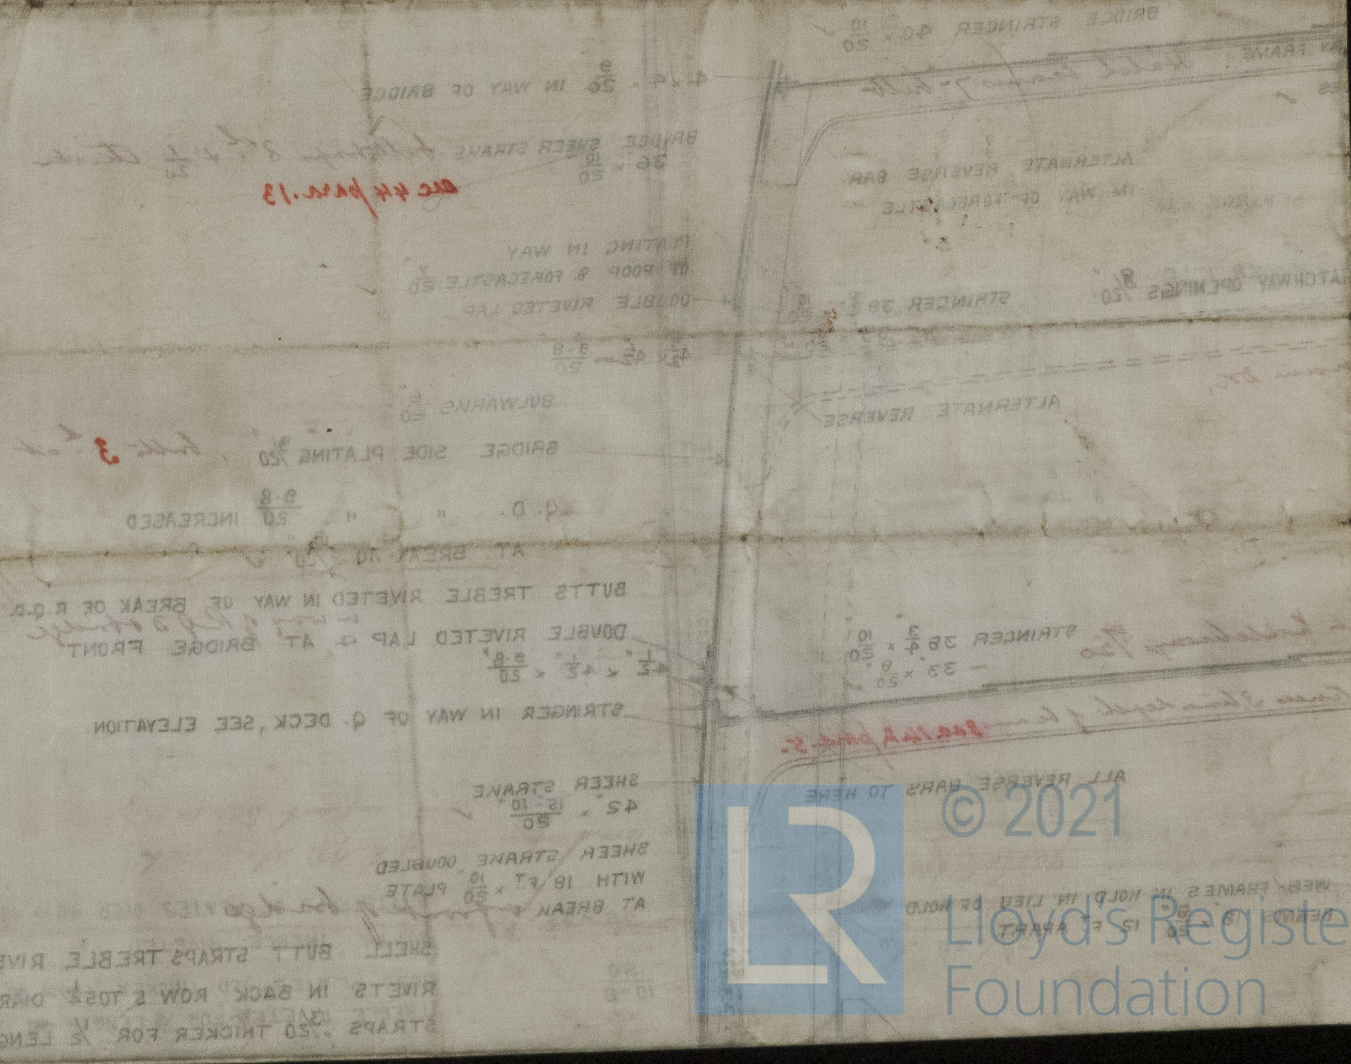

675218-0125