


SCALE 1 INCH = 1 FOOT.


No 456
SS. Pioneer.

As built.

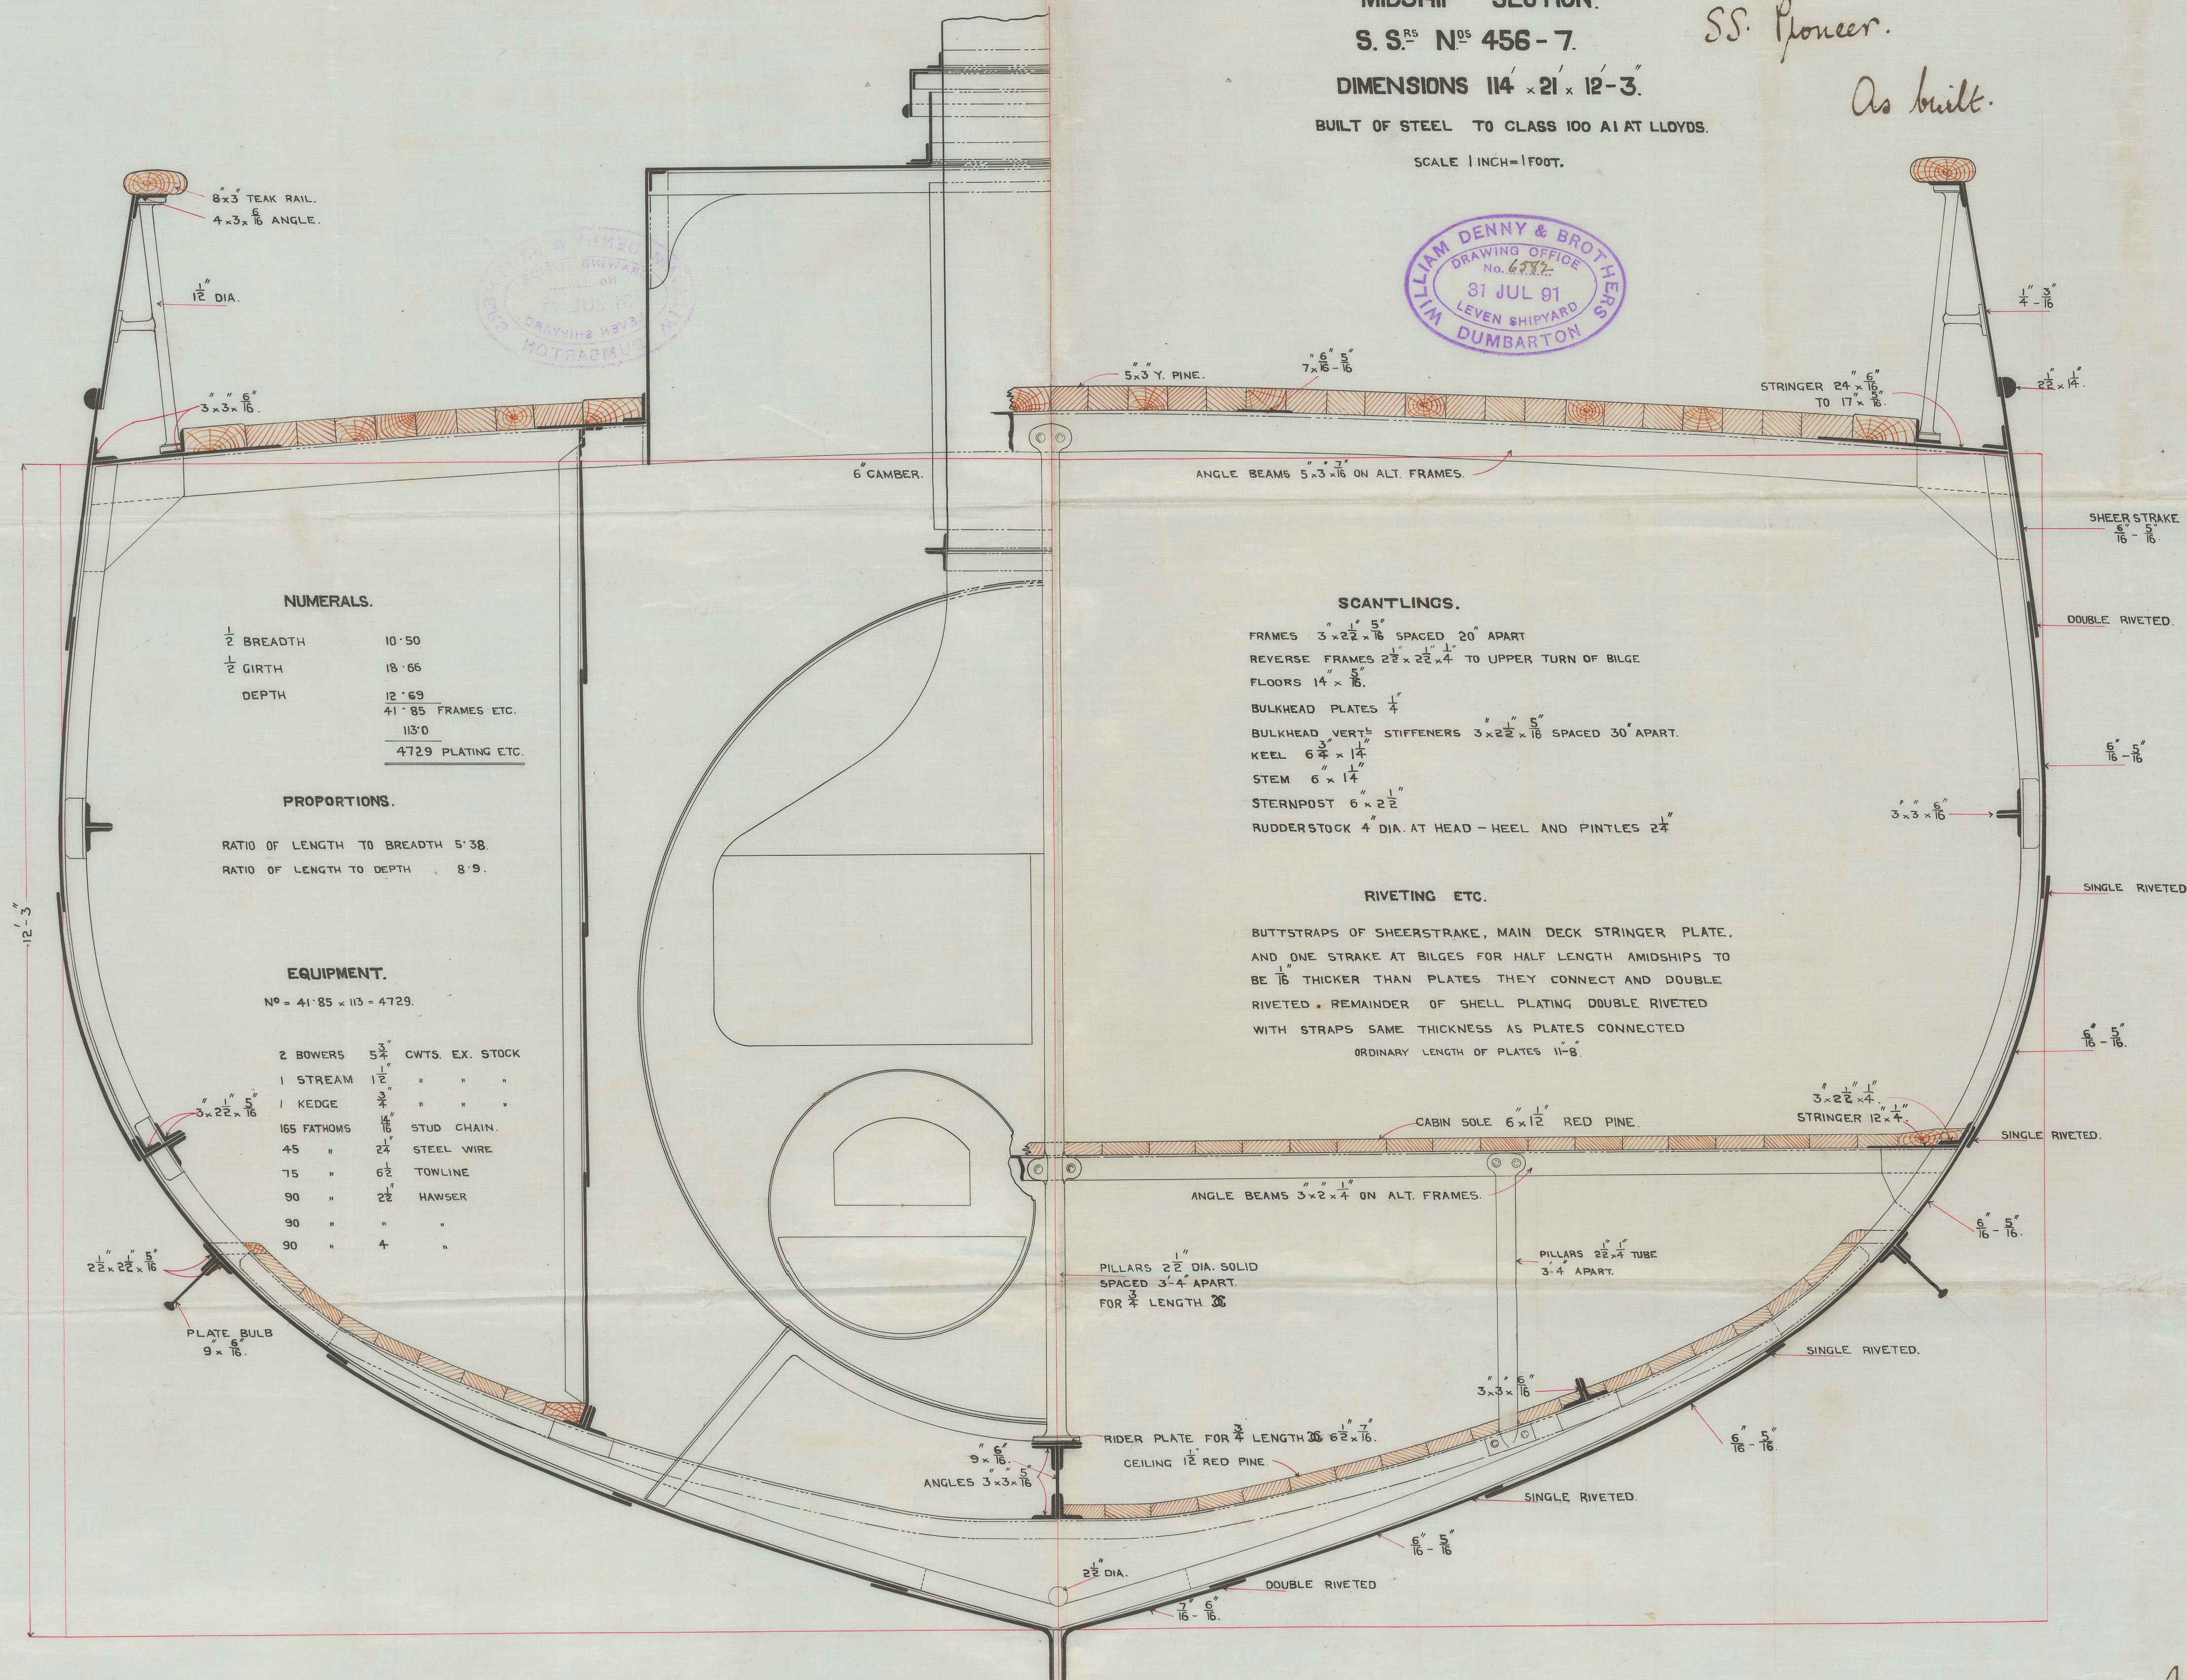

My dear

2A

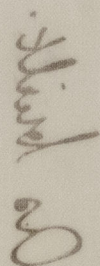

22. parson.
No 429

DATE 12/02/14 4:51 PM 3

2. 2. N_{24}^{20} 422-7.


THE NOTES

ЗДАГОС 1 НСН1 1007-ТД

ЗЕМЛЯ ТЛА ИО $\bar{A} \times C \times E$ МААЗВ УДМА

2 x 2 X 19 ME.

$\frac{1}{x} =$
 $\frac{1}{210} =$
 $\frac{1}{210} =$

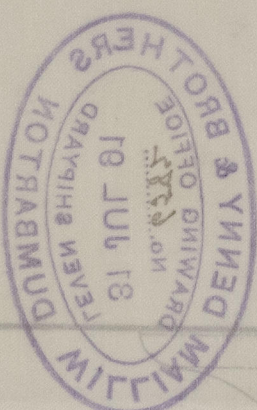

© 2021

Lloyd's Register
GL5224-0187
Foundation