

# MIDSHIP SECTION

STEEL SCREW TRAWLER "OSPREY" No. 67

TO CARRY 100 A1 STEAM TRAWLER

As built.  
J. Thomson  
13-7-93

## DIMENSIONS

HALF MOULDED BREADTH . . . 10.2  
DEPTH FROM TOP OF KEEL . . . 12.0  
HALF MIDSHIP GIRTH . . . 17.80  
LEN. AS PER RULE . . . 47.25

## NUMERALS

10.2 + 12.0 + 17.80 = 40.0 THWAITEHIPS  
10.2 + 12.0 + 17.80 x 97.25 = 3890.0 LONG

## PROPORTIONS

97.25 ÷ 12.0 = 8.10  
97.25 ÷ 20.4 = 4.767


## EQUIPMENT FOR 20 TO 140 TONS

1 ANCHOR 4 CWTs IN STOCK  
1 D<sup>2</sup> 4 D<sup>2</sup> D<sup>2</sup>  
1 D<sup>2</sup> 2 1/2 D<sup>2</sup> D<sup>2</sup>  
60 FMS. 1 1/2 SL CHAIN  
60 FMS. 3 1/2 HAWSER  
60 FMS. 3 1/2 WARP

## NOTE

BULKHEAD PLATING  
KEEL & STEM  
BULKHEAD  
RUDDER  
BULKHEAD STANCHIONS  
HOLD PILLARS  
RIVETS  
SLIPS

IRON  
REMAINDER  
OF  
STEEL

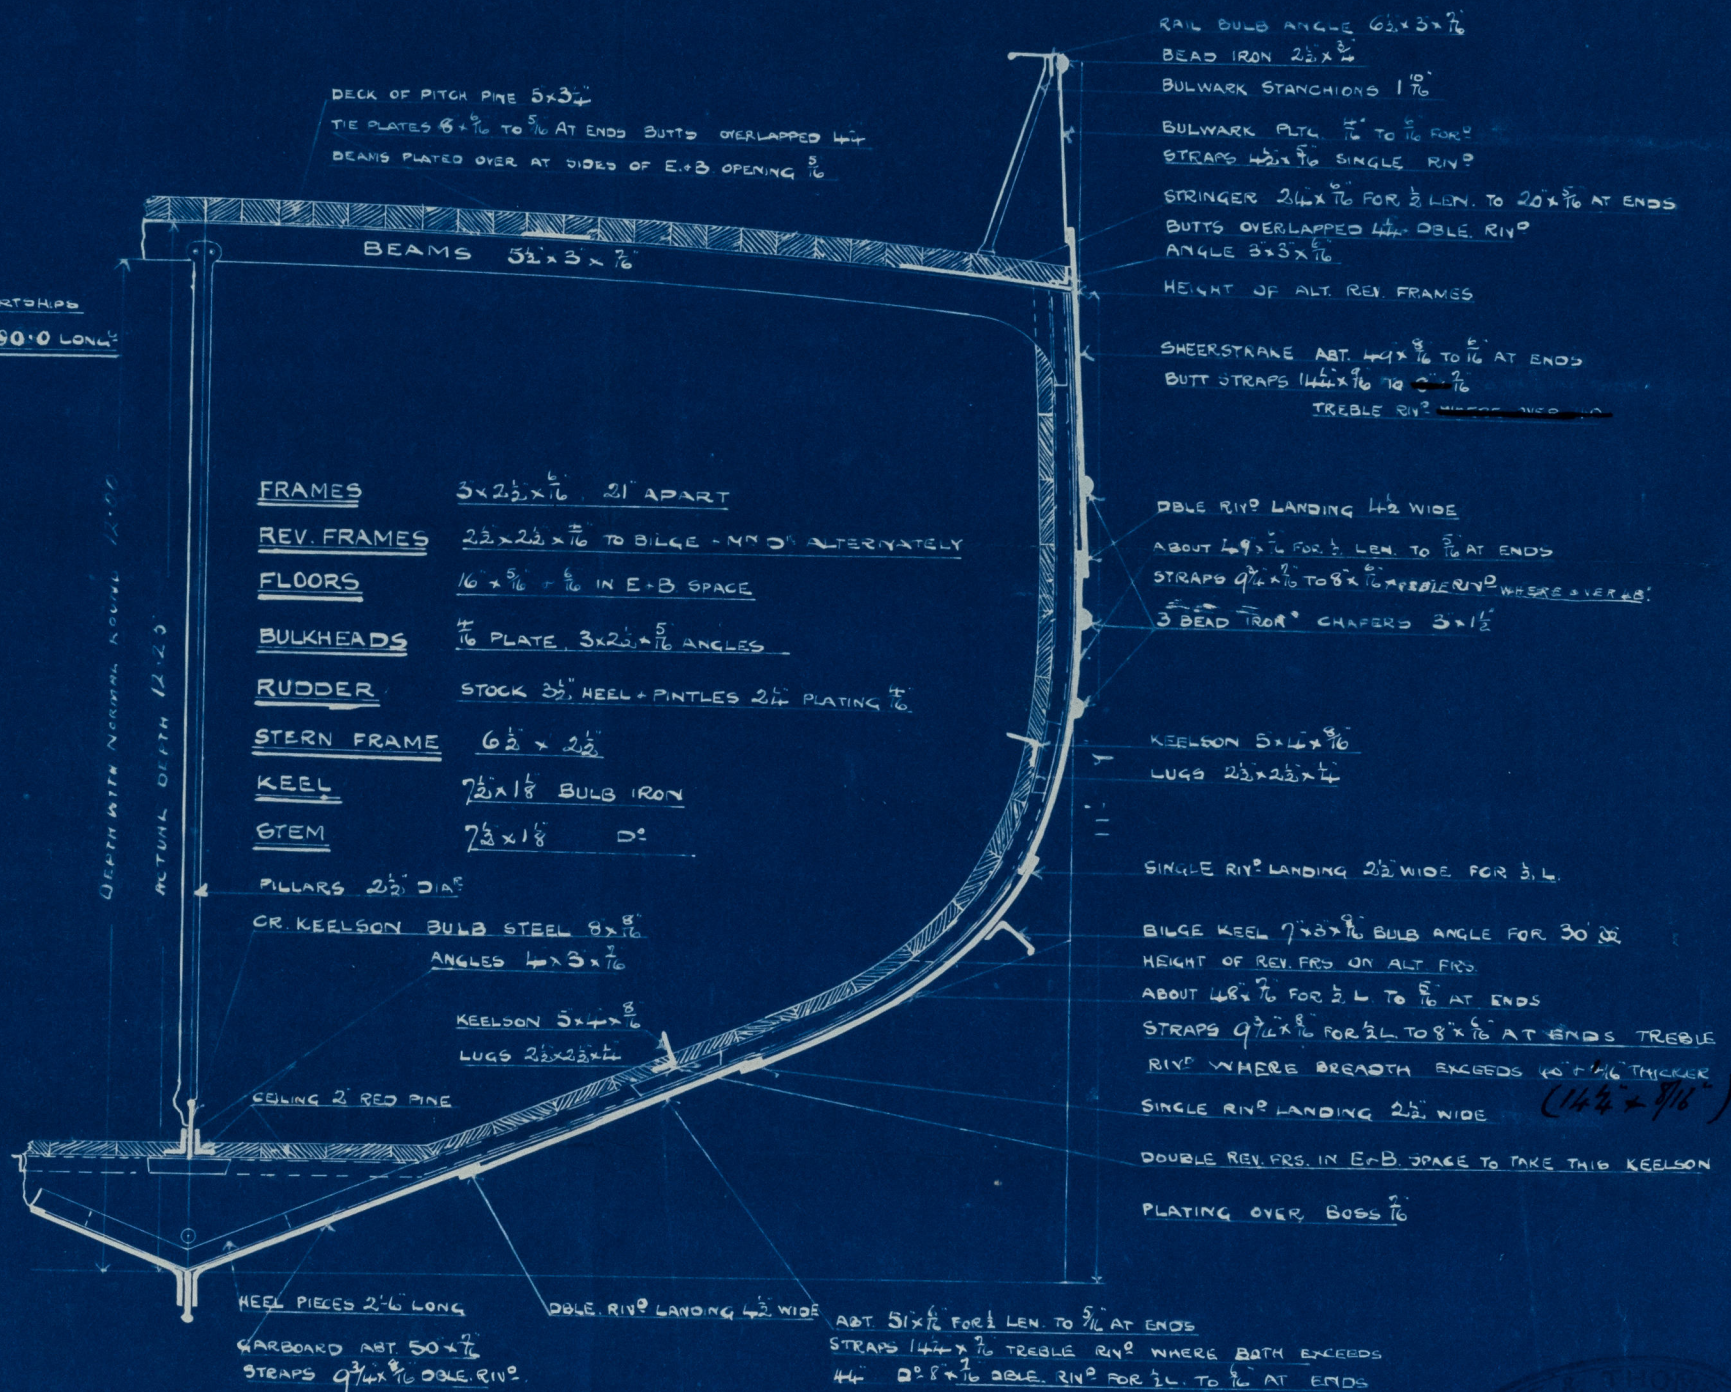

SCALE 1/2" = 1 FOOT.



Lloyd's Register  
Foundation



copy

S. S. Osprey "Glasgow Report No."



© 2021

Lloyd's Register  
Foundation

GLS235-0010