

24.5.94
11.7.94

LONGITUDINAL SECTION + DECK PLANS

OF NO. 92 STEEL SCREW STEAMER

90'-0" x 20'-0" x 7'-6" M.P.




SCALE 2" = 1 FOOT

Lo Class 100 A1

MAKIE & THOMSON
SHIPBUILDERS
21 MAY 94
GOVAN
GLASGOW

MAKIE & THOMSON
SHIPBUILDERS
21 MAY 94
GOVAN
GLASGOW

As Built
22/9/94

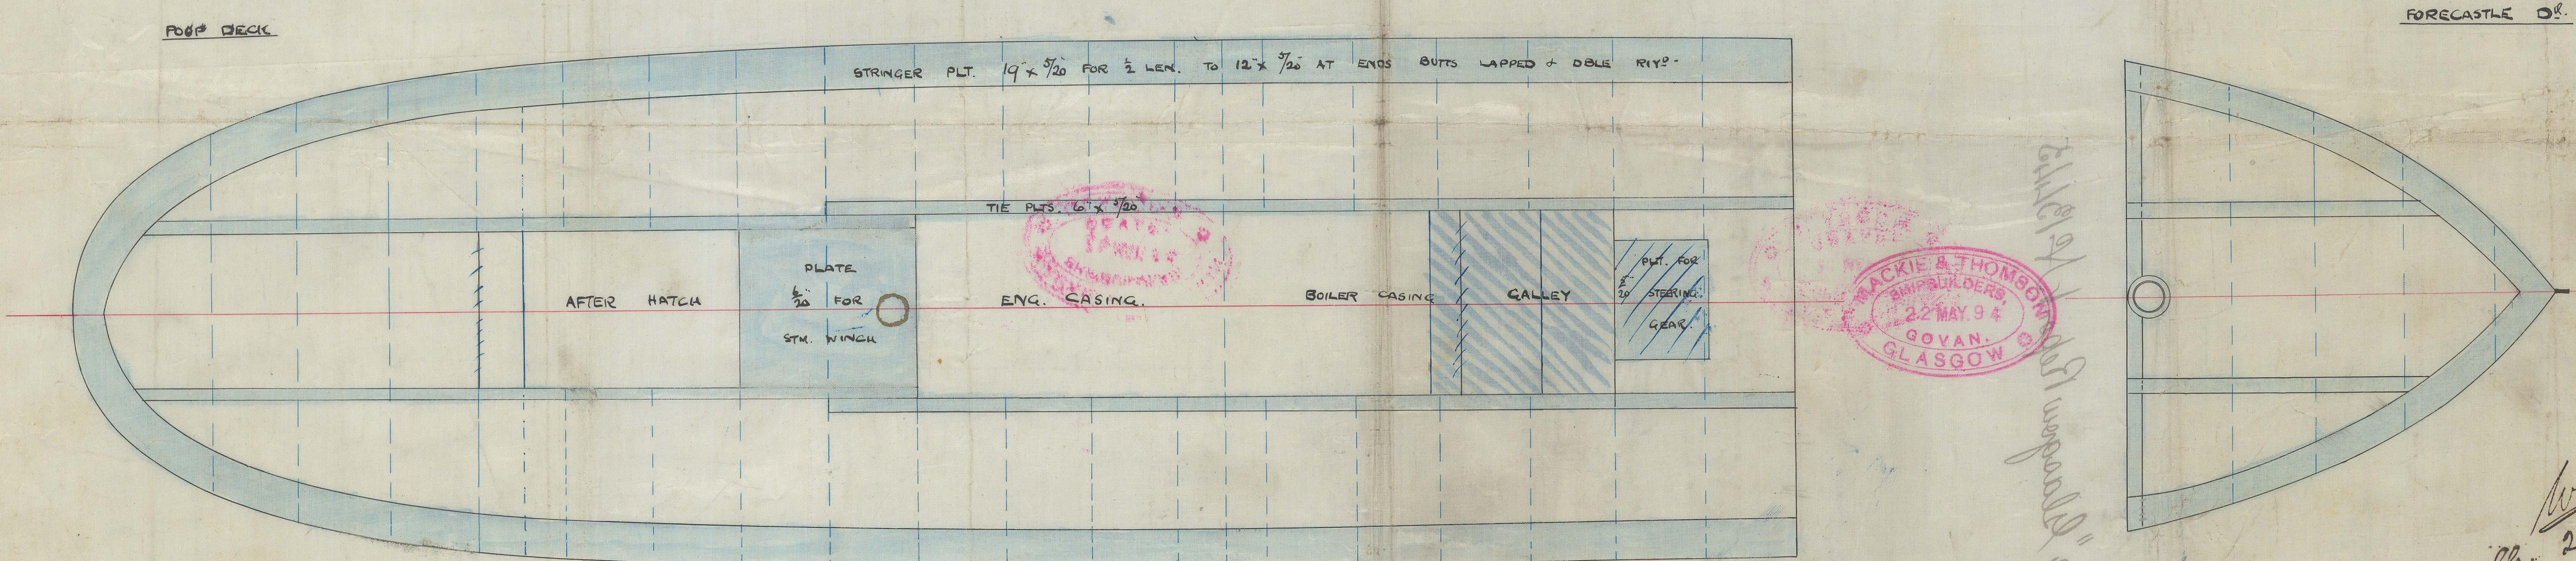
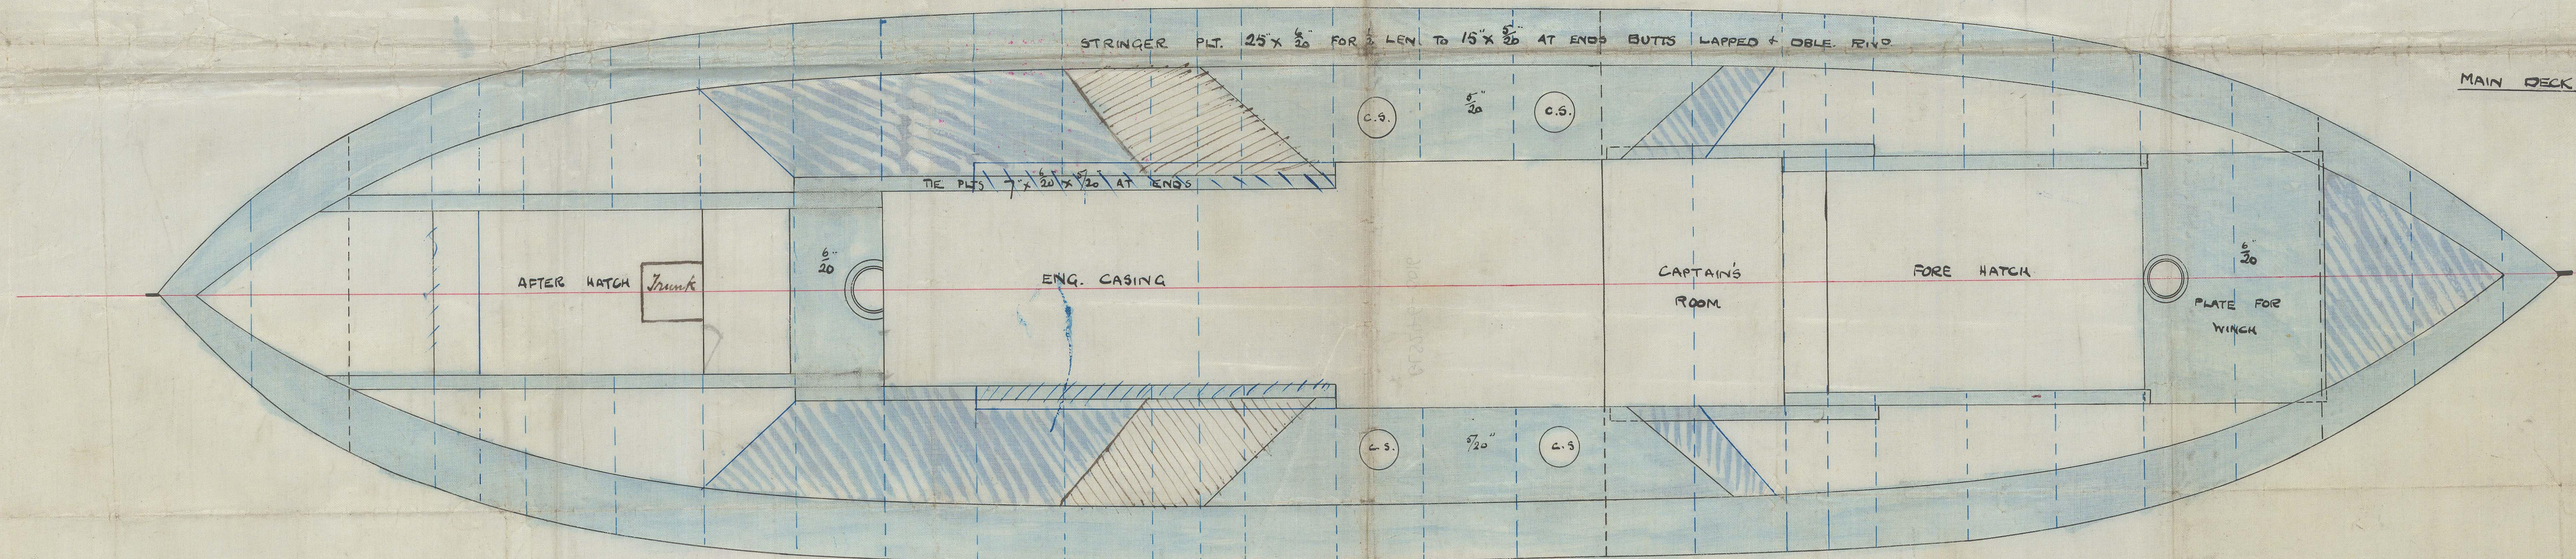
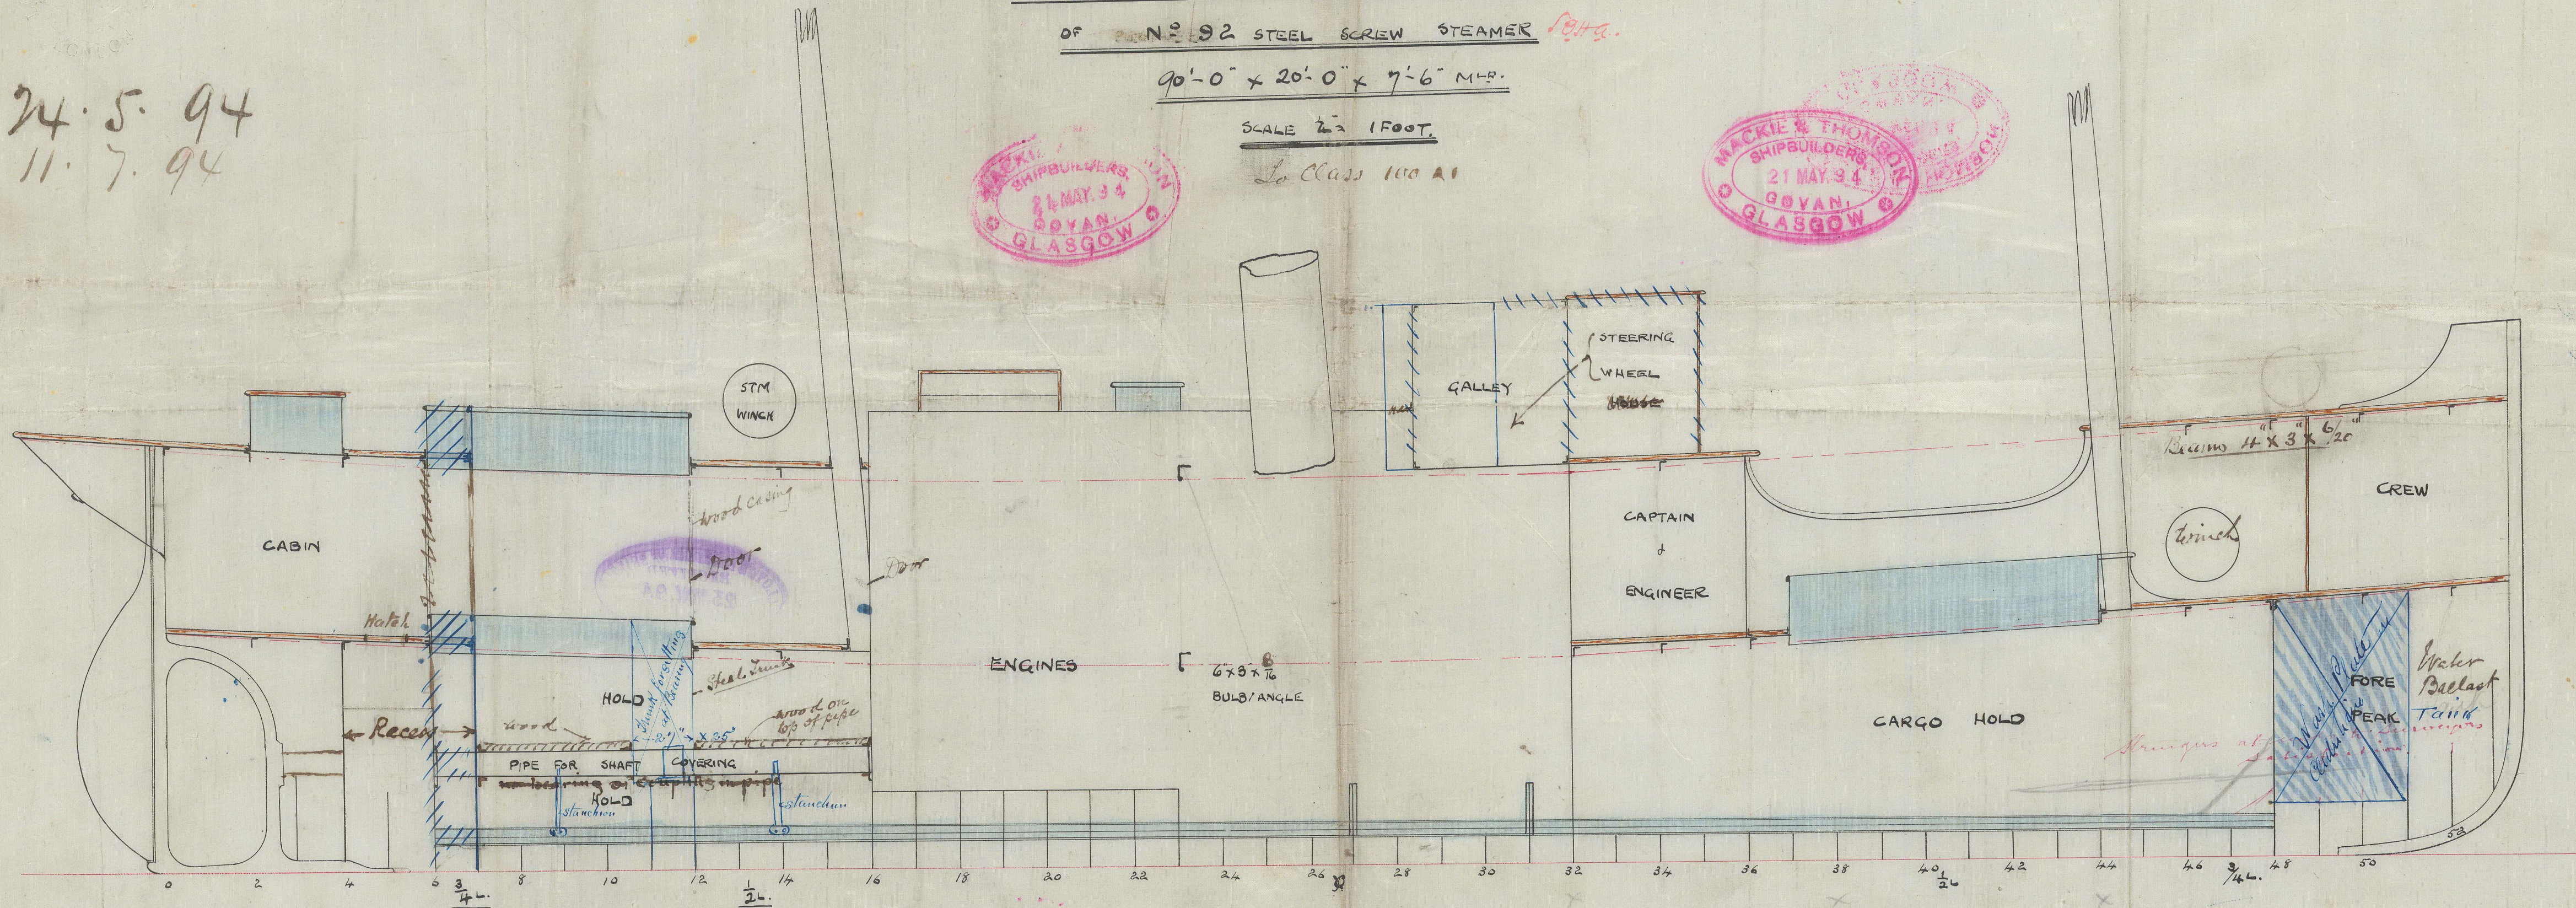


Check of 'As Built' against 'As Ordered' by

22/5/94

18/5/94

S.S. Banshee "Glasgow Report No 13445"

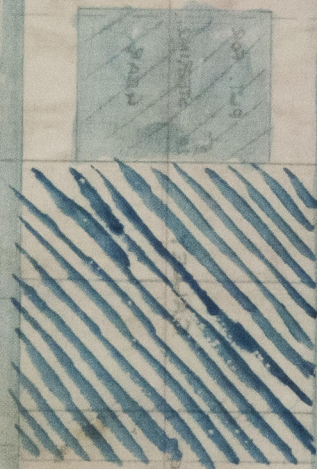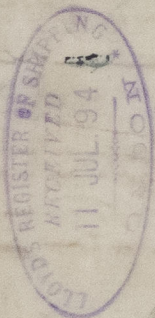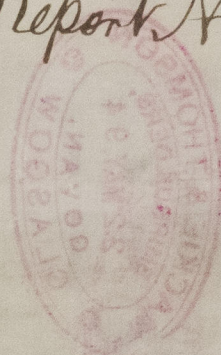

© 2021

Lloyd's Register
Foundation

GLS2476-0016

