



Ld. 16:6 94
 23:1:95

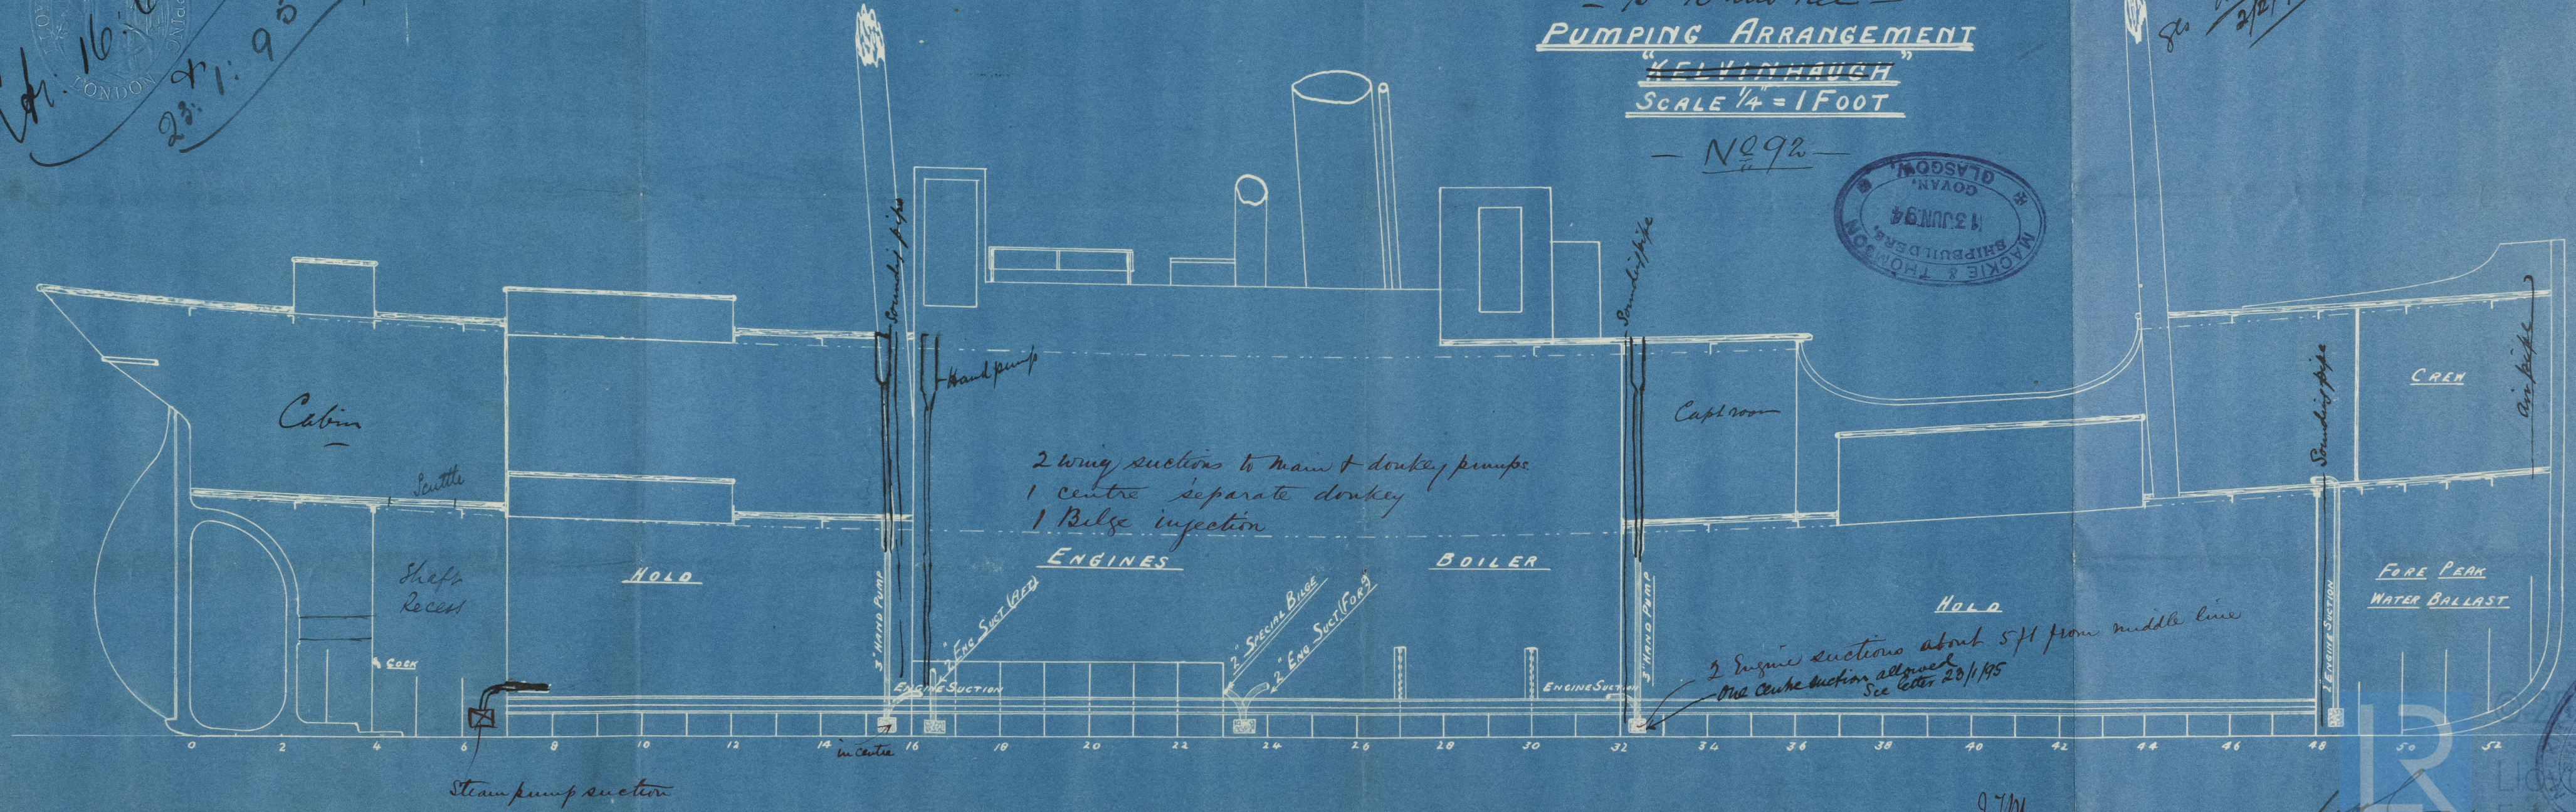

- 3/8 "Panshee"
 PUMPING ARRANGEMENT
 "KELVINHAUGH"
 SCALE 1/4" = 1 FOOT


- No 92 -

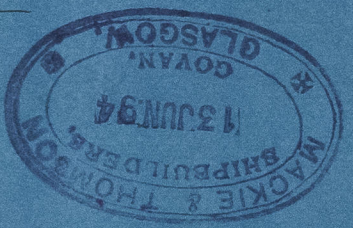

As Built
 W. H.
 2/2/95

J.M.
 15/6/94



W. H.
 14/6/94

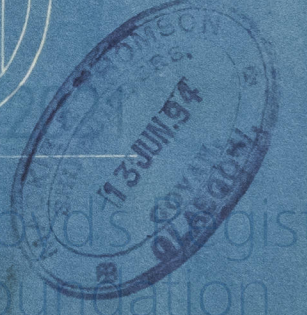

S. S. "Banshee" Glasgow Report 13445.-



Handwritten:
Hamburg
Machine 7. 11992

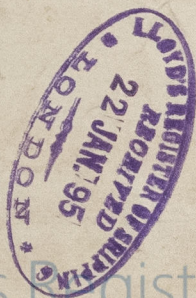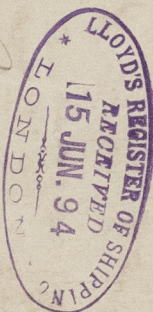

© 2021

Lloyd's Register
Foundation

GLS246-0018

GLS246-0018