


27169
No 4-4-9-50-1

SKETCH SHOWING BEAMS, BULKHEADS ETC
SCALE $\frac{1}{8}$ " = 1 ft
BUILDERS DIMENSIONS 345 x 43-9 1/2 x 27 1/2

See amended Plan
as Built

2. 11. 95
8. 11. 95
18. 11. 95


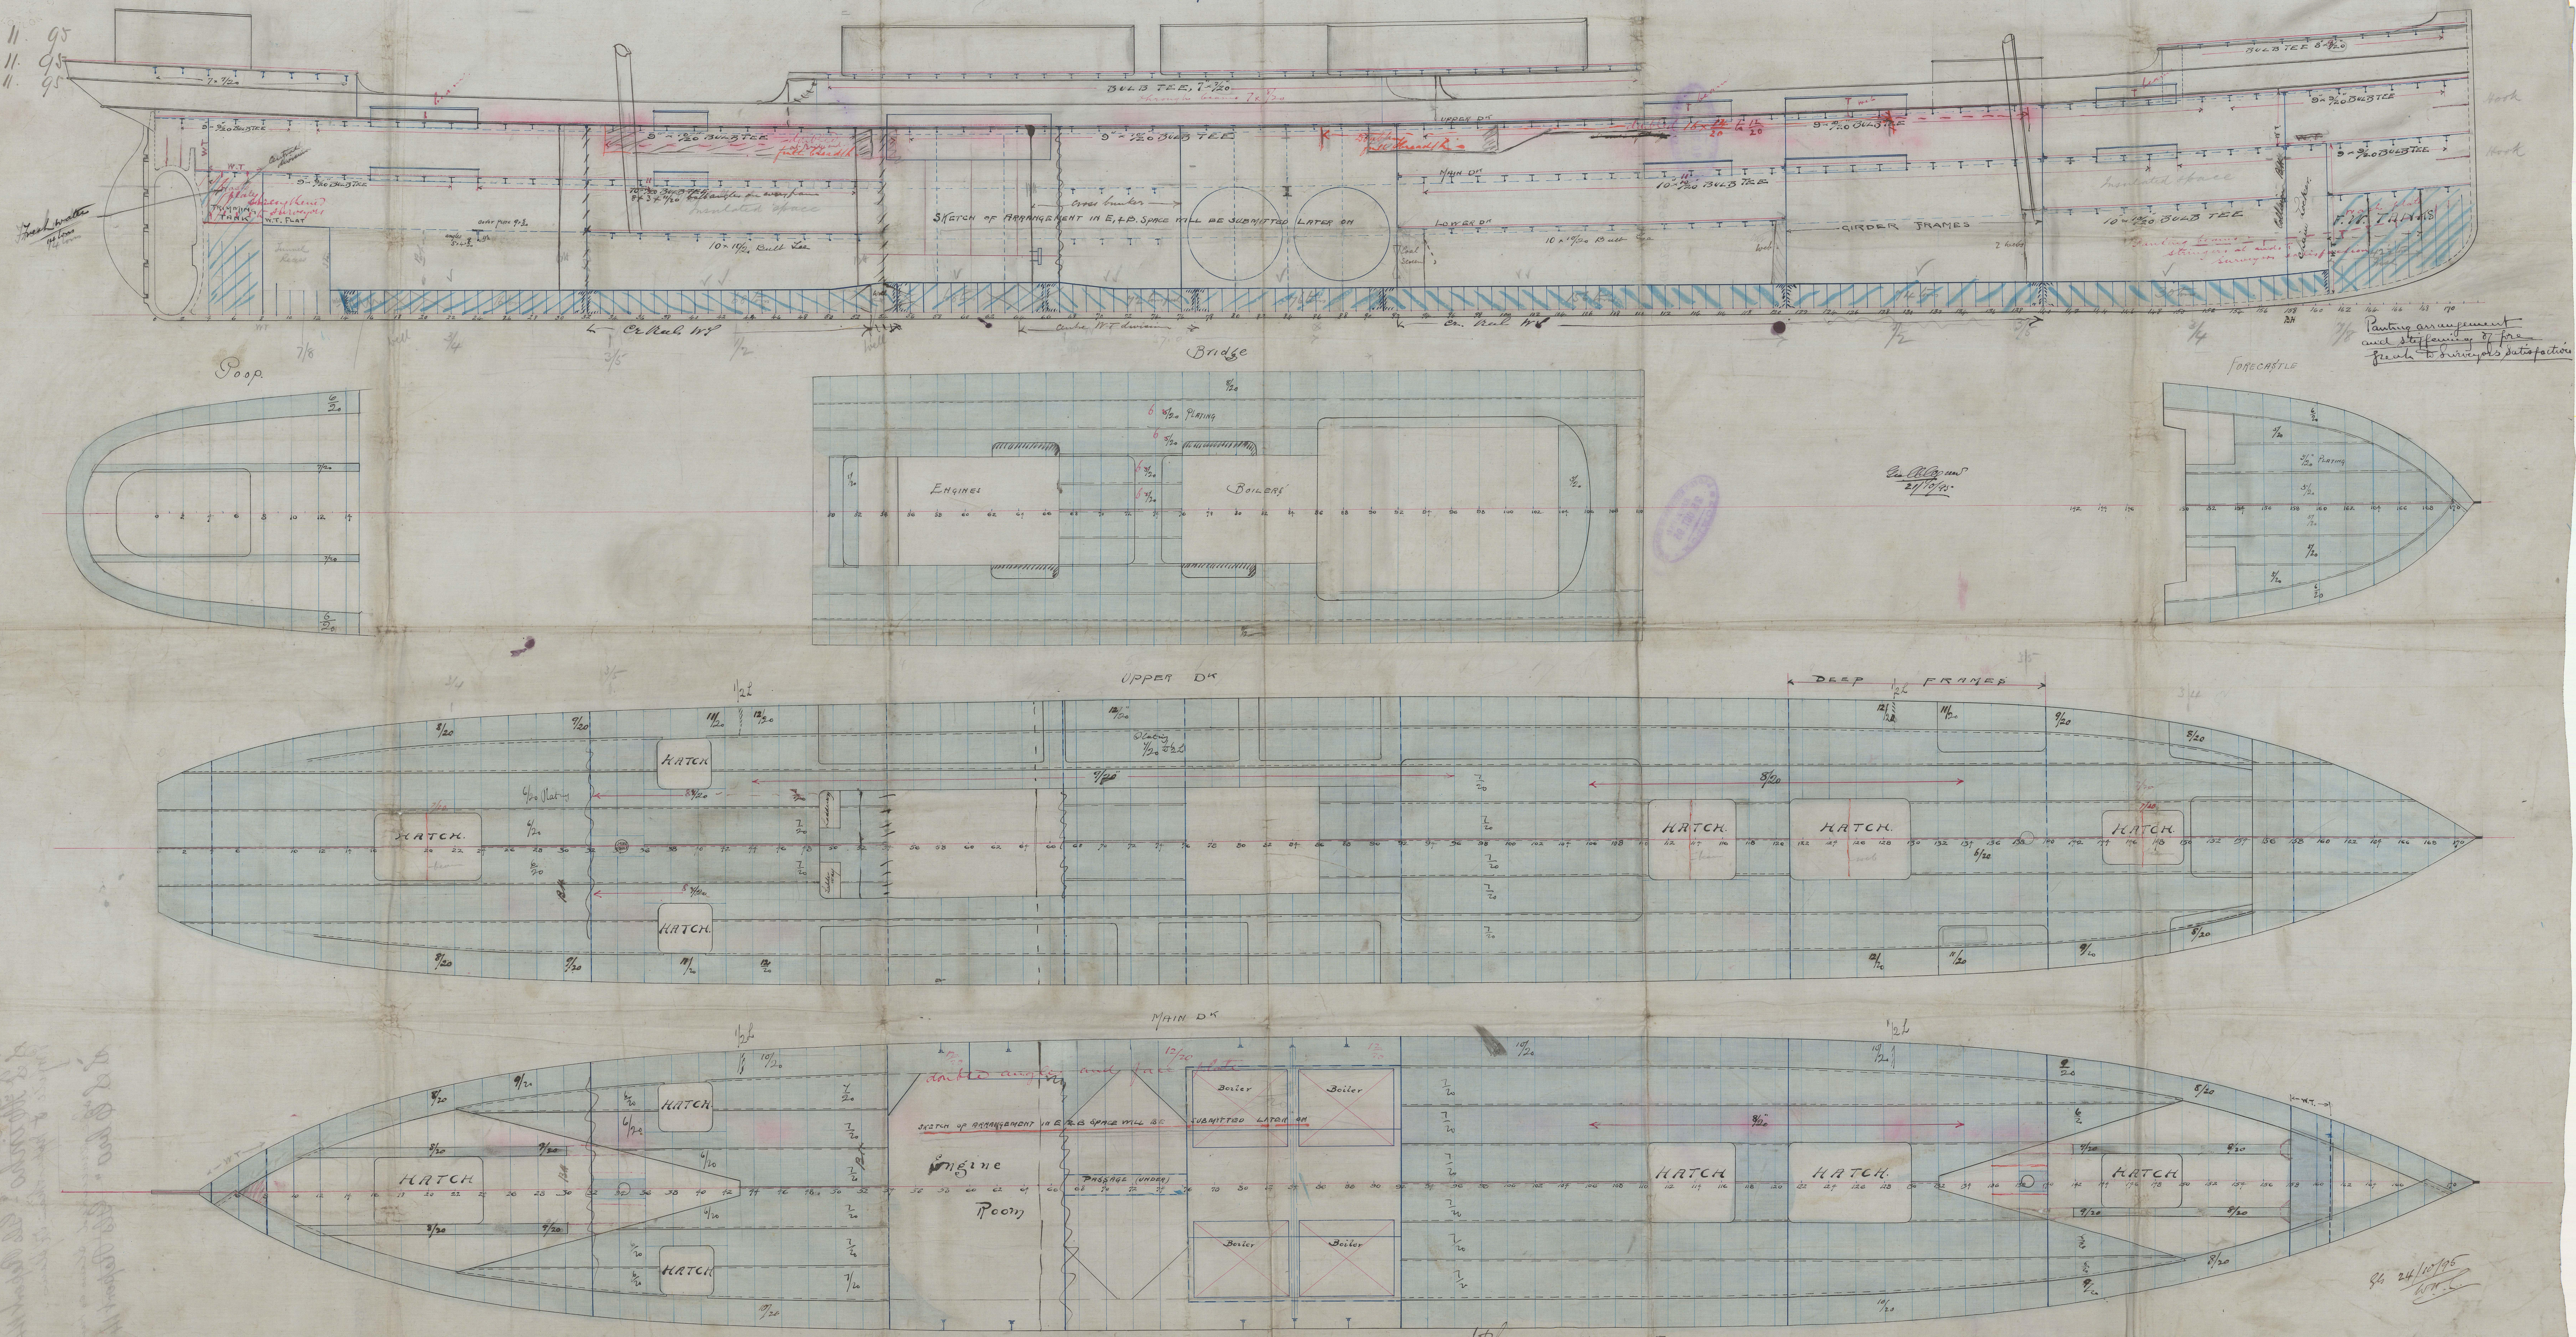


86 24/10/95
10/11/95

Gls. Rpt. 14620


S. La Plata
S. S. Mo inho - Gls Report 14413
Profile & upper main & plans

See amended plans as built.
S. S. Q bro - Gls Report 14850.

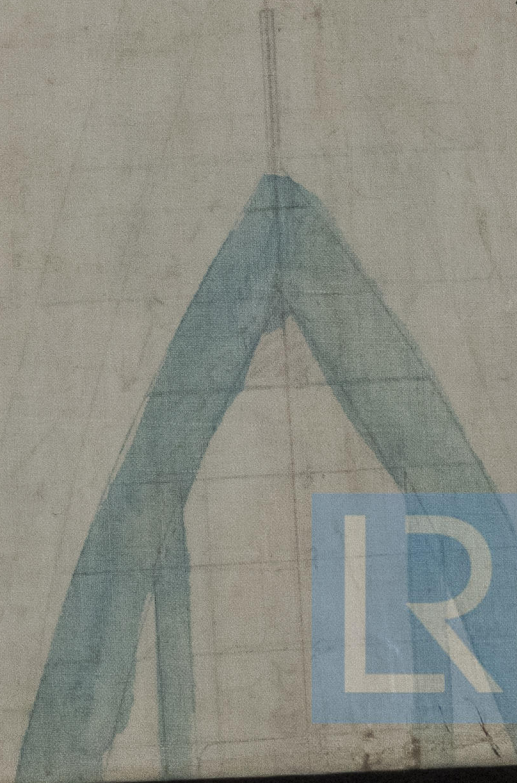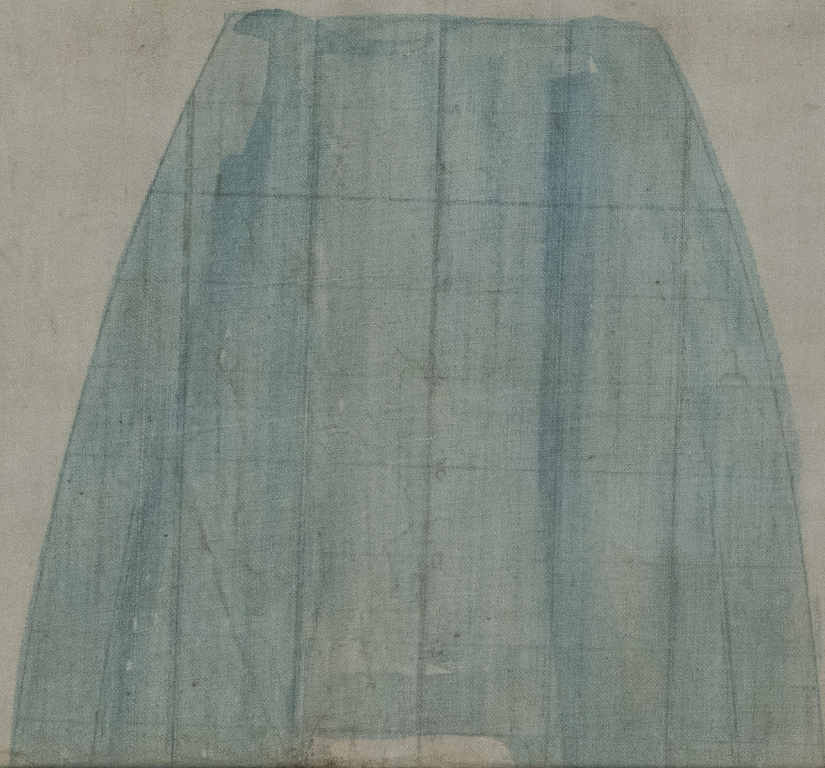

© 2021



Lloyd's Register
GLS256-0052
Foundation

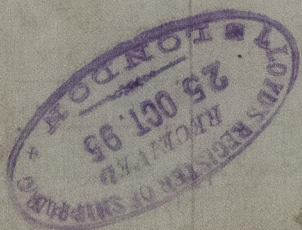

Handwritten notes in the left margin, including "10/10/95" and other illegible scribbles.



GLS256-0052

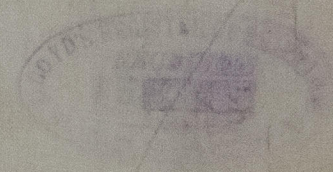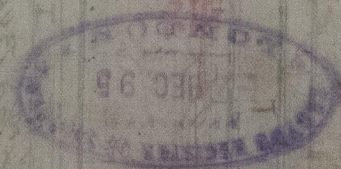

Handwritten notes in the right margin, including "10/10/95" and other illegible scribbles.

