


MAIN DECK.

As Built

SCALE $\frac{1}{4}$ IN = ONE FOOT.

27526

No. 449-50-1

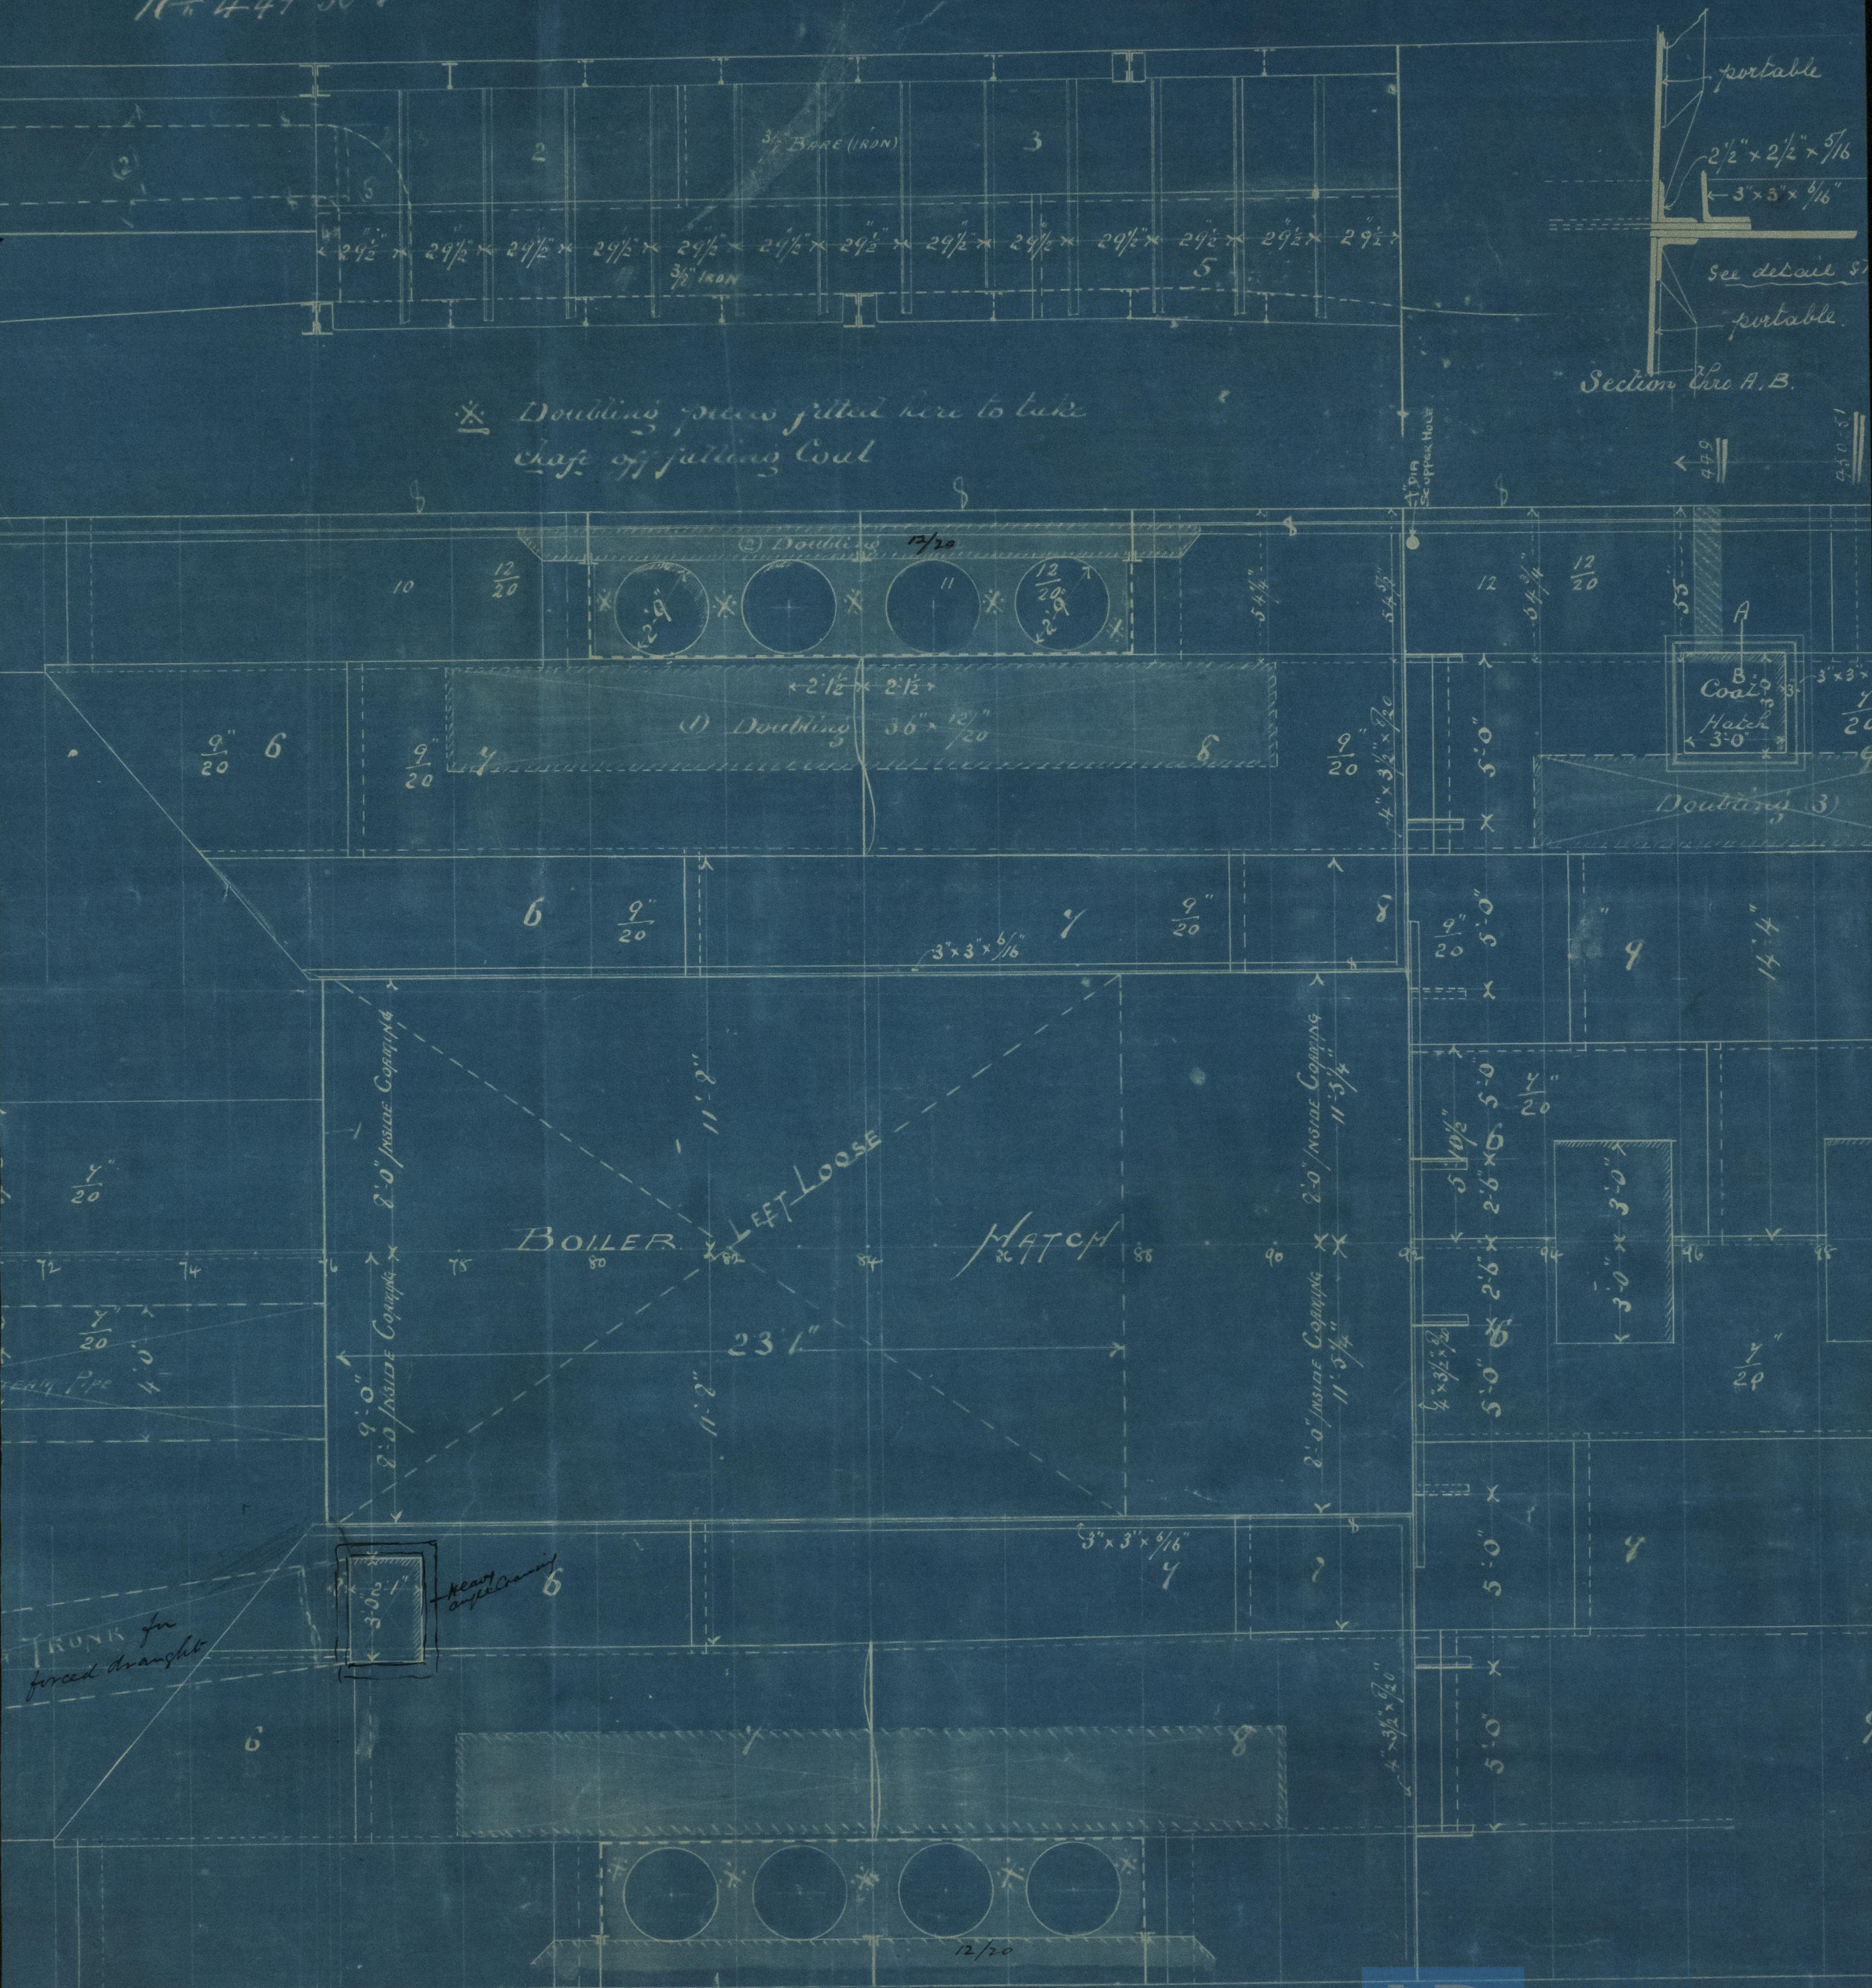

Lloyd's Register
CORPORATION