

Corrections as built shown in blue. J.L.D. 29/9/96

6,000.

Nos 81 & 82 & 84 (AM 19:8:96)

MIDSHIP SECTION

SCALE $\frac{1}{2}'' = 1 \text{ FOOT}$

LENGTH P.P. 445' x 49' 2" MO x 33' 6" MO. DEPTH



BRIDGE DECK.

18" x $\frac{3}{16}$ 3" keel deck, $\frac{1}{2}$ " in houses.

4.3.96
7.3.96
20.3.96
1.4.96
4.5.96
9.5.96
19.8.96

Bridge deck Beams (under 46' long) $9 \times \frac{3}{16}$ on alternate frames.
Bridge stringer plate $4 \frac{1}{2} \times \frac{3}{16}$
angle $3 \frac{1}{2} \times 3 \frac{1}{2} \times \frac{3}{16}$
Tie plates $18 \times \frac{3}{16}$
Short Poop stringer plate $36 \times \frac{3}{16}$; tie plate $15 \times \frac{3}{16}$; Beams built in $9 \times \frac{3}{16}$ on alternate frames.
Forecastle stringer plate $30 \times \frac{3}{16}$; deck plates over $\frac{3}{16}$ thick; beams built angle $9 \times 3 \times \frac{3}{16}$ on every frame.

2" bridge straps
double ends

Side plating of Poop, Bridge and Forecastle $\frac{3}{16}$ double lapped edges.

Beams $12 \times \frac{3}{16}$ built in on alternate frames.
at hatch ends $12 \times \frac{3}{16}$ built and angle $6 \frac{1}{2} \times 4 \frac{1}{2} \times \frac{3}{16}$ angle.
In way of Hatchways and Machinery casing built angle $9 \times 3 \times \frac{3}{16}$ on every frame.
Deck plating $\frac{3}{16}$ reduced to $\frac{3}{16}$.

Stringer Plate $6 \frac{1}{2} \times \frac{3}{16}$ for $\frac{1}{2}$ length to $5 \frac{1}{2} \times \frac{3}{16}$ at ends.
Extra $\frac{3}{16}$ for $\frac{1}{2}$ length.
Angles $5 \times 5 \times \frac{3}{16}$ for $\frac{1}{2}$ length reduced to $\frac{3}{16}$.

7/20 rivets
double straps for $\frac{1}{2}$ L. upper straps $\frac{1}{2} \times \frac{3}{16}$ under $\frac{3}{16}$

UPPER DECK.

11" x $\frac{11}{16}$
Tween deck bulkheads $\frac{6}{16}$

Beams $12 \times \frac{3}{16}$ built in on alternate frames.
at hatch ends $12 \times \frac{3}{16}$ built and angle $6 \frac{1}{2} \times 4 \frac{1}{2} \times \frac{3}{16}$ angle.
In way of Hatchways and Machinery casing built angle $9 \times 3 \times \frac{3}{16}$ or $9 \times 3 \times \frac{3}{16}$ on every frame.
Deck plating $\frac{3}{16}$ reduced to $\frac{3}{16}$ under hatchways.

Stringer plate $6 \frac{1}{2} \times \frac{3}{16}$ for $\frac{1}{2}$ length reduced to $5 \frac{1}{2} \times \frac{3}{16}$
Butts treble riveted for $\frac{1}{2}$ length.
Angles $4 \times 4 \times \frac{3}{16}$ for $\frac{1}{2}$ length reduced to $\frac{3}{16}$.


2" extra for $\frac{1}{2}$ length.
Double straps, treble riveted, under straps 13×20 , inner $\frac{1}{2}$ inch $\frac{3}{16}$.
19/20 for $\frac{1}{2}$ length. 15/20 for $\frac{1}{2}$ length to $10 \frac{1}{2} \times \frac{3}{16}$ at ends.

MAIN DECK.

Hold pillars $6 \times \frac{7}{16}$ or solid $4 \frac{3}{8}$ diam.
Foredeck " $4 \times \frac{6}{16}$ " " 3" "

Quarter pillars on all beams for $\frac{3}{4}$ length

Side stringer plates 26 broad and same thickness as frames.
Angle pieces next shell plating $3 \frac{1}{2} \times 3 \frac{1}{2} \times \frac{3}{16}$ for $\frac{1}{2}$ length reduced to $\frac{3}{16}$
Main stringer angles $6 \frac{1}{2} \times 4 \frac{1}{2} \times \frac{3}{16}$ " " "
Web frames in Machinery space. plate same as side stringer plate.
with double $4 \times 4 \times \frac{3}{16}$ angles on inner edge.

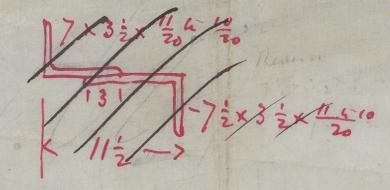

as built
 $11 \frac{1}{2}$ frames
 $6 \frac{1}{2} \times 3 \frac{1}{2} \times \frac{11}{16}$
Keep for $8 \times 3 \frac{1}{2} \times \frac{11}{16}$
J.L.D.

1/2 Girth 54'-2"
1/2 Beam 24'-4"
depth 34'-6"
113'-3"
106'-3"
106.25 x 44.3 = 4706.9

Beams in way of Ballast Tank and steel plated lower decks forward and aft.
of built angle $9 \times 3 \times \frac{3}{16}$ or $9 \times 3 \times \frac{3}{16}$ on every frame.
plated over inside stringer plates with $\frac{3}{16}$ plate.

Rivetting
Longitudinal seams double riveted

Butts of top sides strapped with plates $\frac{3}{16}$ thicker than plates for $\frac{1}{2}$ length and $\frac{3}{16}$ thicker at ends, and treble riveted throughout with back row of rivets spaced 5 to $5 \frac{1}{4}$ diameters apart.
Butts of keel plate riveted as per section 20.
Remainder of shell, built lapped and treble riveted.

Equipment
113.1 x 44.3 = 50140
 $\frac{180}{8} \times \frac{180}{44.3} \times 50140 = 2580$
52720.

Stem. $12 \times 3 \frac{1}{2}$
Stern post. $12 \times 7 \frac{1}{2}$
Rudder. $10 \frac{1}{2}$ diam. $\frac{7}{16}$ less than formula
Frames for $\frac{1}{2}$ length $6 \frac{1}{2} \times 3 \frac{1}{2} \times \frac{3}{16}$ reduced to $\frac{3}{16}$ spaced 30 inches.
Frames in Tank $3 \frac{1}{2} \times 3 \frac{1}{2} \times \frac{3}{16}$ " " "
Reverse outside tank same scantling as frames.
Reverse in Tank same scantling as frames in tank.
Reverse in way of steel plated lower decks forward and aft $4 \times 4 \times \frac{3}{16}$
Bulkheads 8×20 to 7×20 stiffened as required by Rules.

all to upper deck for $\frac{1}{2}$ length.
to main and upper decks forward and aft
alternately to upper deck and Forecastle deck.

Floors $4 \frac{1}{2}$ deep at middle line carried to height of 84" at bilges.
 $\frac{3}{16}$ thick for half length reduced to $\frac{3}{16}$. Floors under Boiler space $\frac{1}{16}$ iron.


Tank top plating. Centre strake $\frac{3}{16}$ reduced to $\frac{3}{16}$
In Engine space $\frac{3}{16}$ at ends, and $20 \times \frac{3}{16}$ elsewhere.
On Boiler space $\frac{3}{16}$ iron.
Remainder inner strakes $\frac{3}{16}$ reduced to $\frac{3}{16}$.
Outer strakes $\frac{3}{16}$.

Vertical angles and fore & aft angles on girders $3 \frac{1}{2} \times 3 \frac{1}{2} \times \frac{3}{16}$ reduced to $\frac{3}{16}$.

(84) $17 \frac{1}{2} \times \frac{11}{16}$
 $\frac{15}{16} \times \frac{12}{16}$
 $\frac{1}{2}$ half length angle straps tapered gradually to ends

Three strakes $\frac{1}{16}$ extra all fore & aft.
2 others 2×20 extra add to $1 \frac{1}{2}$ at ends.

Angles $4 \times 4 \times \frac{3}{16}$ for $\frac{1}{2}$ length reduced to $\frac{3}{16}$ thick.
Plate $\frac{3}{16}$ for $\frac{1}{2}$ length reduced to $\frac{3}{16}$.
Angles $6 \frac{1}{2} \times 4 \frac{1}{2} \times \frac{3}{16}$ for $\frac{1}{2}$ length reduced to $\frac{3}{16}$ thick.

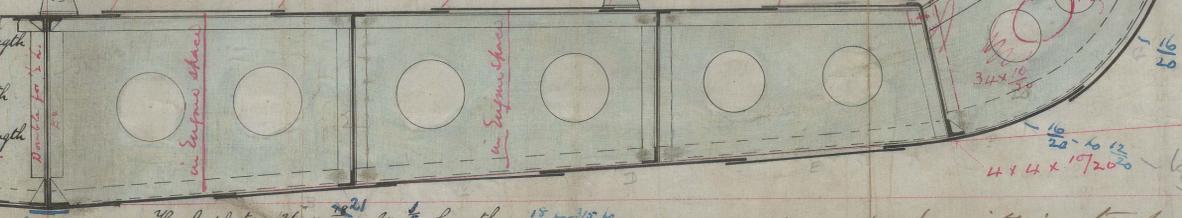

Keel plate $36 \times \frac{3}{16}$ for $\frac{1}{2}$ length to $15 \frac{1}{2} \times \frac{3}{16}$ at ends.
Reduced to $\frac{3}{16}$ for $\frac{1}{2}$ length $11 \times 1 \frac{1}{2}$.
Starboard strake $36 \times \frac{3}{16}$ for $\frac{1}{2}$ length reduced to $\frac{3}{16}$.

Shell plating entirely airtight tank added $\frac{1}{16}$.

J.L.D. 4/3/96



G15261-0020

S.S. "Kawachi Maru" Glasgow Report 15722
 S.S. "Sanuki Maru" — do — 15296.
 S.S. "Iamba Maru" — do — 15557.

RECEIVED
 MAR. 96

LOYD REGISTER OF SHIPPING
 RECEIVED
 15 AUG. 96

LOYD REGISTER OF SHIPPING
 RECEIVED
 18 MAR. 1896

LOYD REGISTER OF SHIPPING
 RECEIVED
 18 JUN 1897

Robert Clarke & Co
 81 x 82

0300-12575



© 2021
 Lloyd's Register
 Foundation