



As built

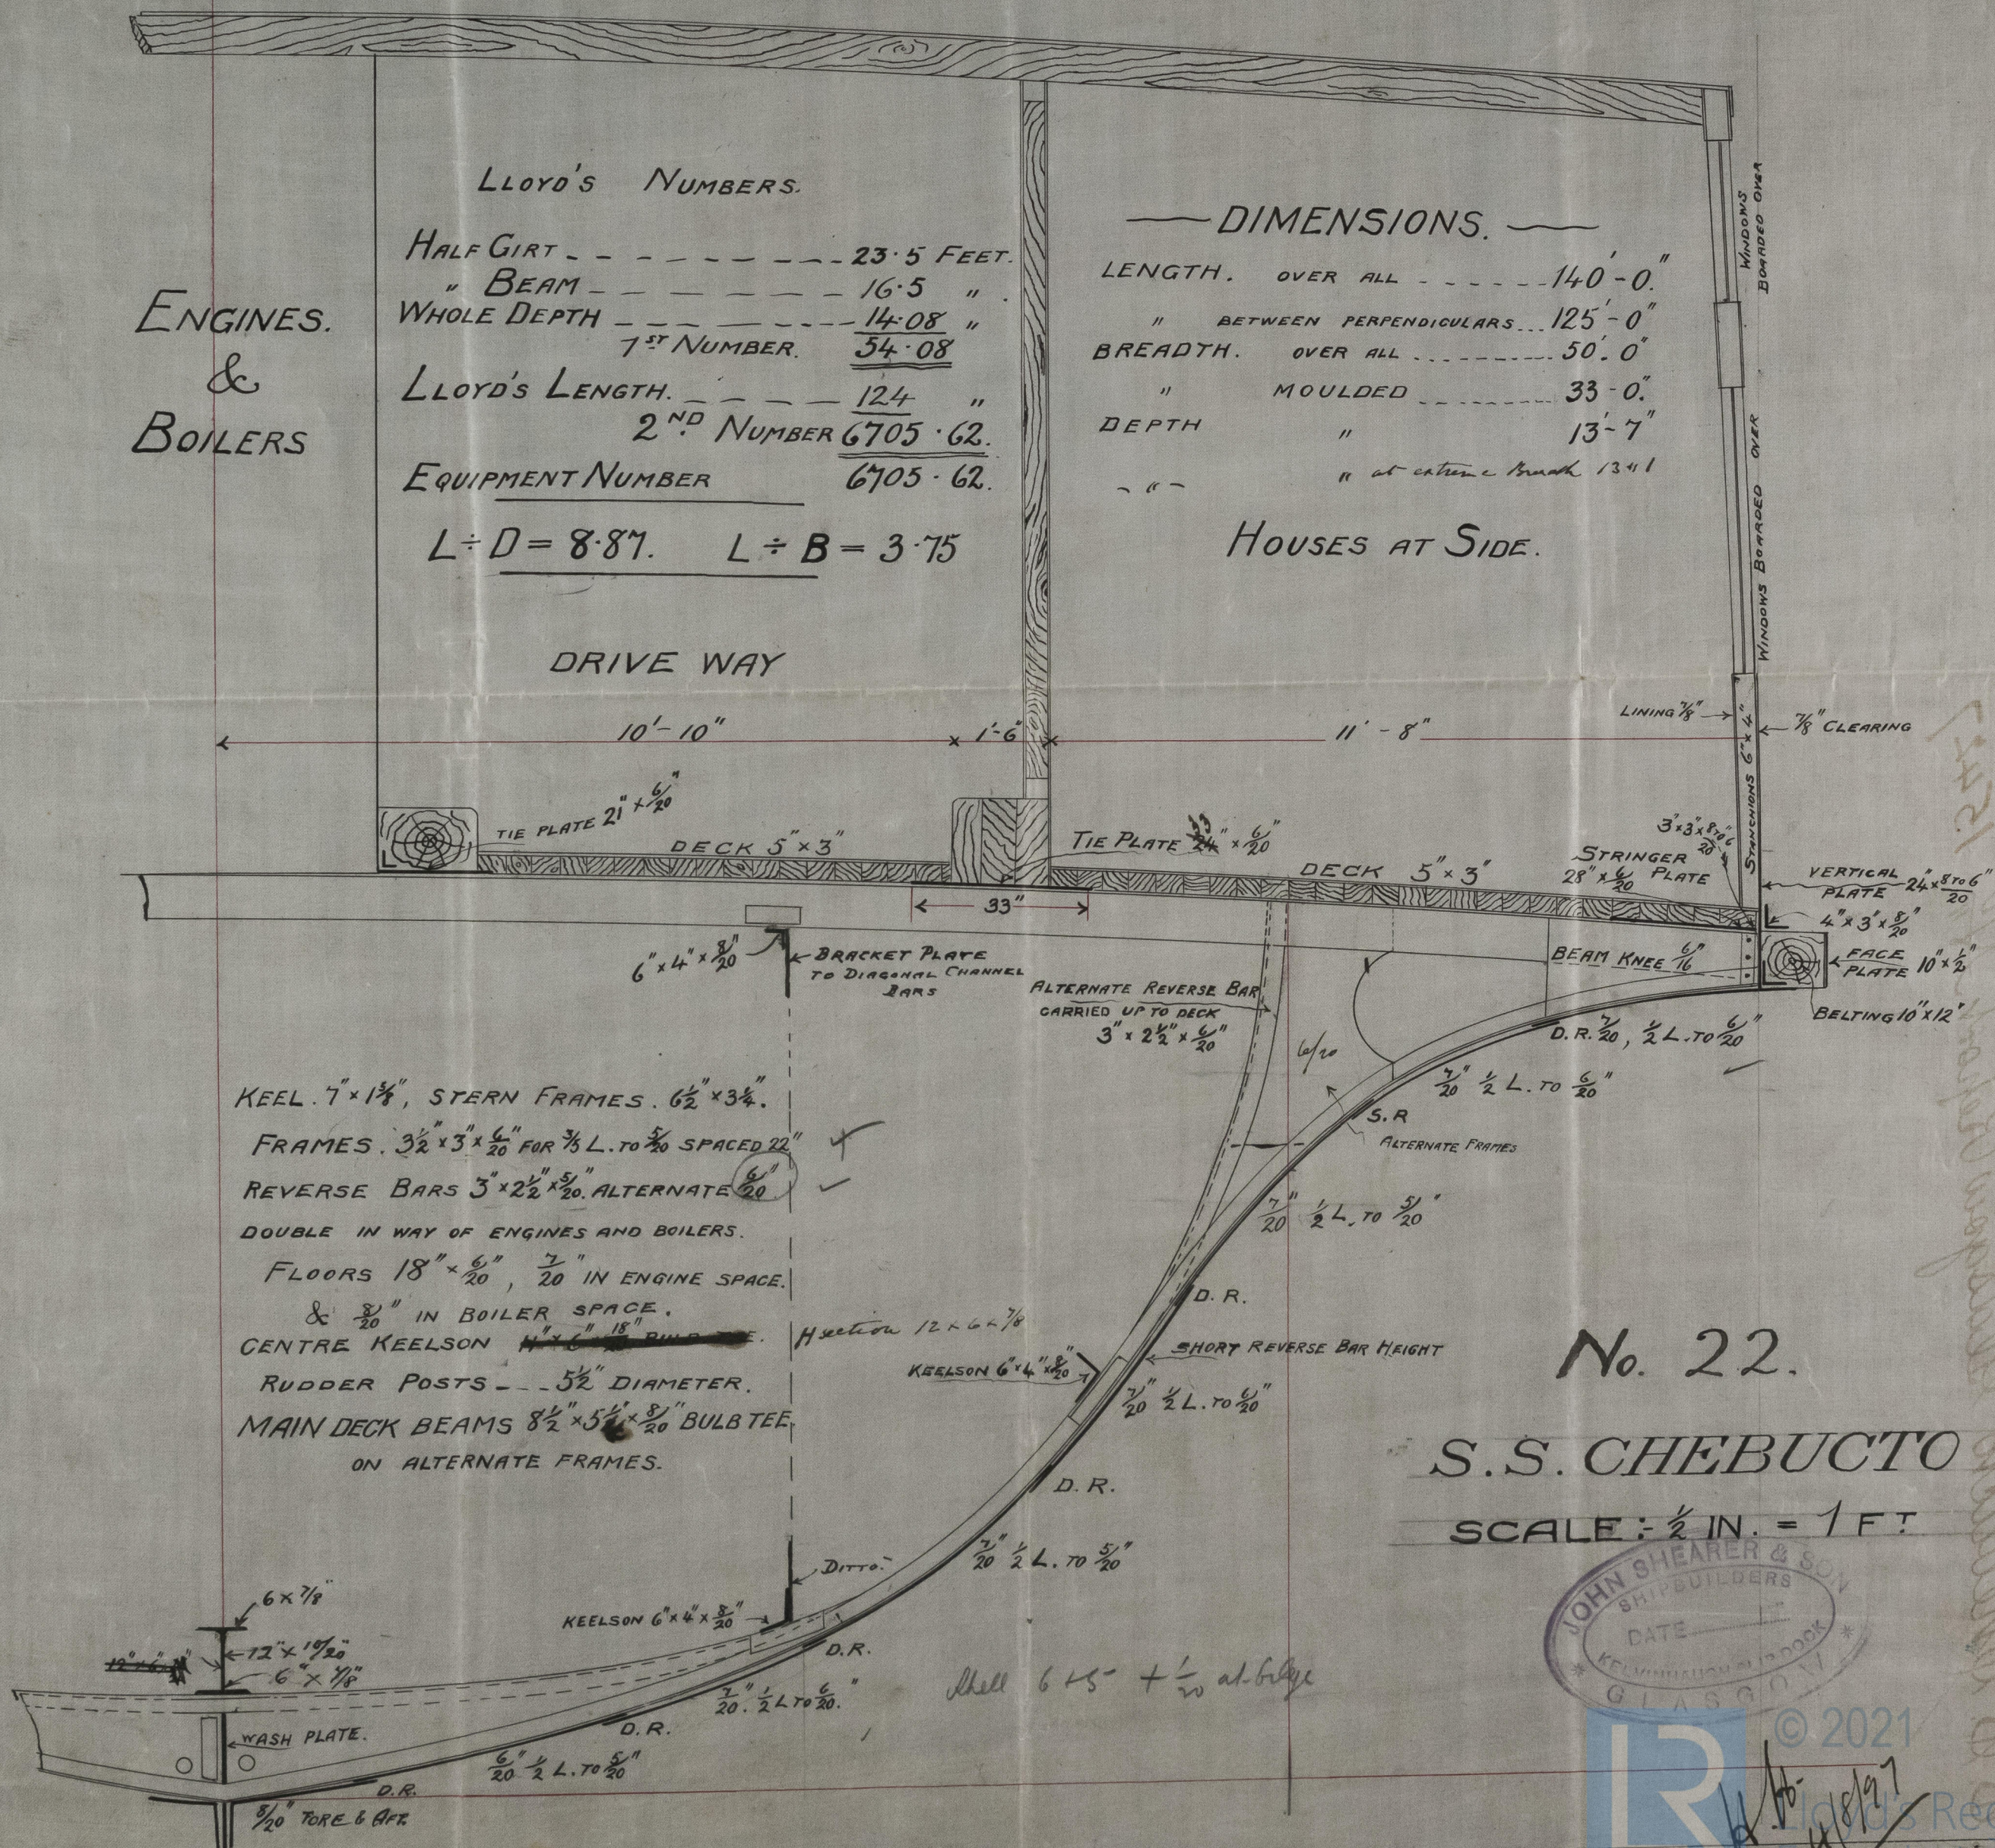

No. 22.

S.S. CHEBUCTO

SCALE: $\frac{1}{2}$ IN. = 1 FT.

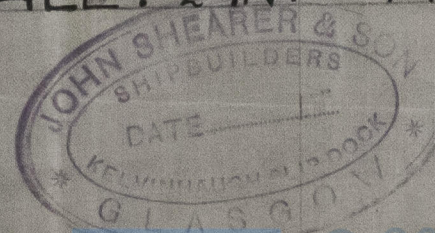

4/8/97

S. S. Chelucko "Glasgow Report No 15427"



REMAINTS WERES LEFT TO NOTICES, PINSQIM
 FOR
 1.A 001 22A 10 0T <—

Handwritten signature