

Nov

Steel S. S. "Assyrian Monarch" Report No. 4928.

Iron 28153

N^o 224

SECTION OF PROPOSED "SHELTER DECK" FOR CATTLE

SCALE: $\frac{1}{2}$ = ONE F.T.



2 WINCHES ON TOP-DECK

Deck to be efficiently strengthened to
the satisfaction of the Surveyors in any
of which -

Hatchways to be fitted over each
hatchway of Main Deck.

Bulwarks ~~to be~~ made to unship
opposite the Hatchways, or to go on
hinges to open outwards

BOLLARDS & C
- ON TOP-DECK

Stanchions and Rails to be made
to unship opposite the Hatchways

angles $3\frac{1}{2} \times 3\frac{2}{16}$

$$3 + \frac{6}{16}$$

Lee 9" x $\frac{5}{16}$

The Beams to be
Planks 8 in x 27 in x 17

$$-\frac{1}{4}$$

11 6

 $2\frac{1}{2}$

engle $2\frac{1}{2} \times 2\frac{1}{2} \times \frac{5}{16}$

Angle $3\frac{1}{2} \times 3 \times \frac{6}{11}$

Stringer 24" x 6/16

$$\frac{6}{16}$$

Beams alternately: of Butt $6\frac{1}{2} \times \frac{6}{16}$ with double angles $2\frac{1}{2} \times 2\frac{1}{2} \times \frac{5}{16}$
and angle $5 \times 2\frac{1}{2} \times \frac{6}{16}$.

Frames, alternately $5\frac{1}{2} \times 3\frac{1}{2} \times \frac{7}{16}$ and $3\frac{1}{2} \times 2\frac{1}{2} \times \frac{6}{16}$ - Spaced 14" apart - But in way of the Rigging to be $5\frac{1}{2} \times 3\frac{1}{2} \times \frac{7}{16}$

Pillar: $2\frac{1}{4}$ diam.

adjustable Stanchions to be fitted for
tripping portable Bull head. For
use & without the

Ventilators to be fitted along N. pt.

卷六

Scuttles to be fitted opposite the
Scuttles in the Saloon House.

Strong Doors opening outwards to be fitted in the Sides, opposite the Hatchways.

Freeing Ports in Bulwarks even 16 ft.

 $\frac{6}{16}$

23/4 ~~AN~~ Pitch Pine. dick.

+

6" SCUPPERS Straight through

"CARGO DECK SKIDS" TO BE MADE
TO FIT EITHER DECK.

1872 July

1120NS45-0058

© 2021

Lloyd's Register
Foundation


W 141
Drawing No. 5
No. 5

Steel & Copper Plate
Jan 28 1883

No. 554

SECTION OF PROPOSED "SHELTER DECK" FOR CATTLE

SCALE: 1/4" = ONE FT.

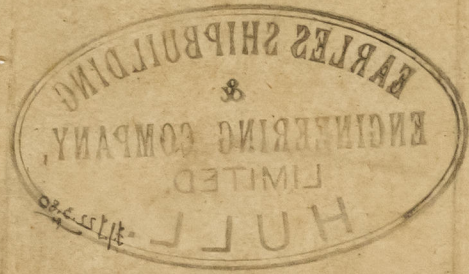

2" x 4" x 1/2" angle
to support of the hatchway

2" x 4" x 1/2" angle
to support of the hatchway
to be opposite the hatchway
to be opposite the hatchway

IRONS 43-0058

No. 5

to be fitted opposite the hatchway
to be fitted opposite the hatchway
"CARGO DECK SKIDS" TO BE MADE
TO FIT EITHER DECK.

18/11/80
J. H. H.