


Bridge deck Plan
S.S. Wilcannia 1999
 as built J.L.

P^t Chateau

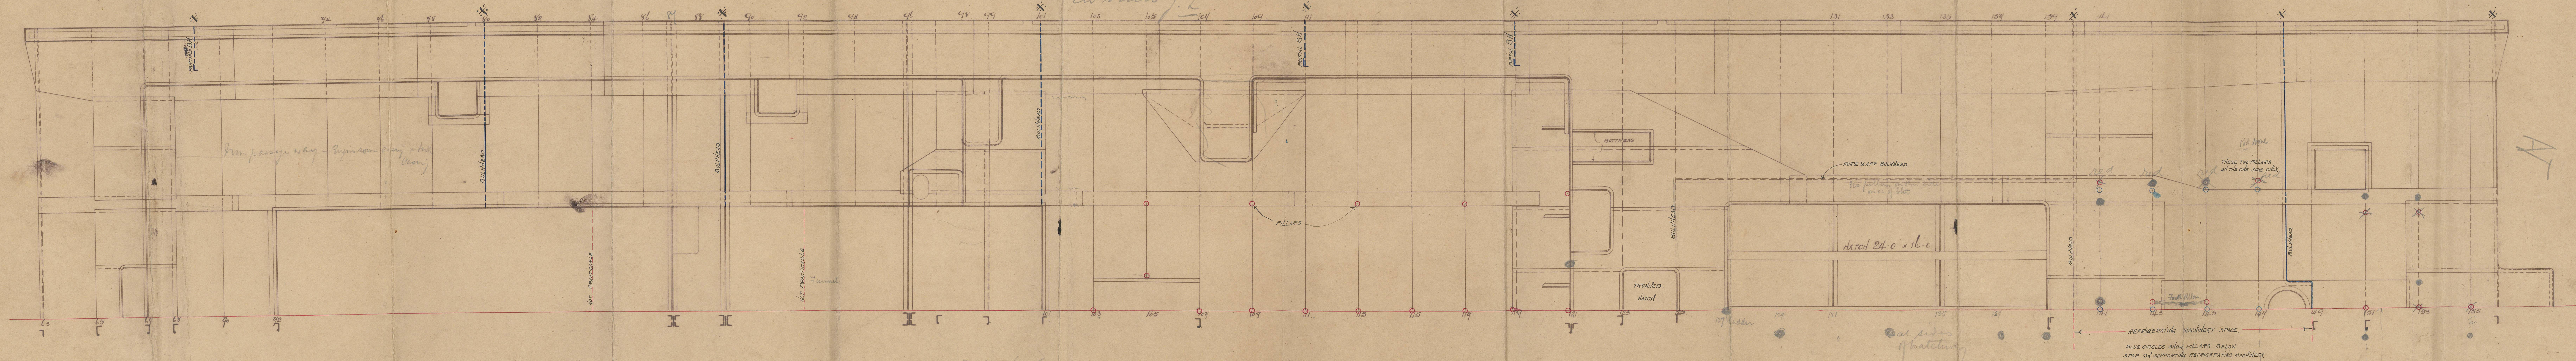

SLD 19756.

Is. Wilcannia

As built

1 inch a' carbon 1st & 2nd

Sur 17 - 16 - face down


17

16



1.00

Conduct d'air
at 1000

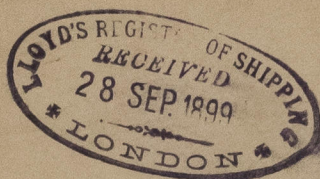

© 2021

Lloyd's Register
Foundation

SLD1018 - 0231