


S.S. N^o 525

*L. J. Huxford
Sunderland Report No 17/62*

Scale $\frac{1}{8}$ " = one foot.

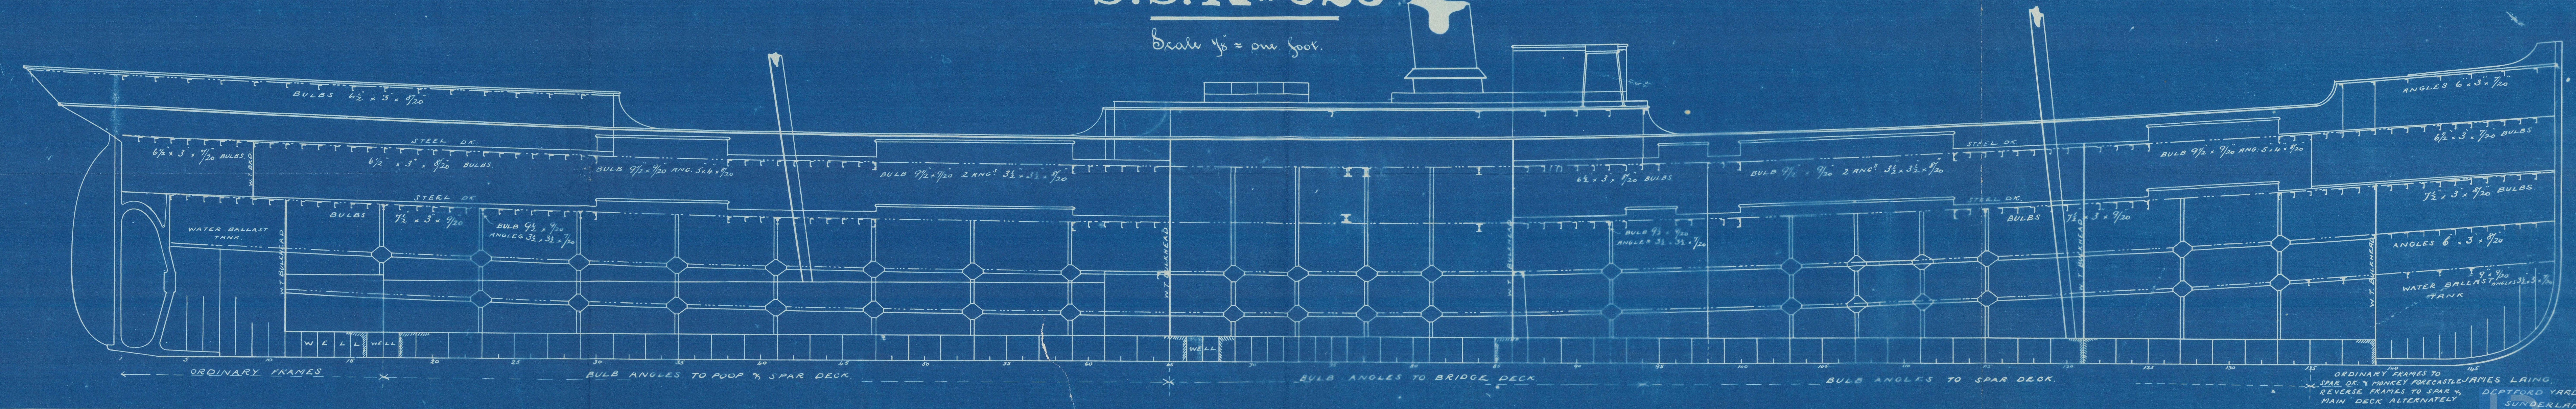

SLD988-0181

J. Laing
No 525-
Profile Plan
as Built
S. L. Umfrell
Sunderland Report No 17162



© 2021

Lloyd's Register

SLD 988-0181