

# Merchship Section

S.S. No 525

Class 100 A 1 at Lloyd's Spar Decked

Scale 1/2 inch = to 1 foot

## Numbers

1/2 Birth --- 34.08

1/2 Breadth --- 20.00

Depth --- 18.00

72.08 x 298.33


= 21503

## Proportions

11.93 Depths in length to Spar dk

16.57 Depths in length to Main dk

7.45 Breadths in length

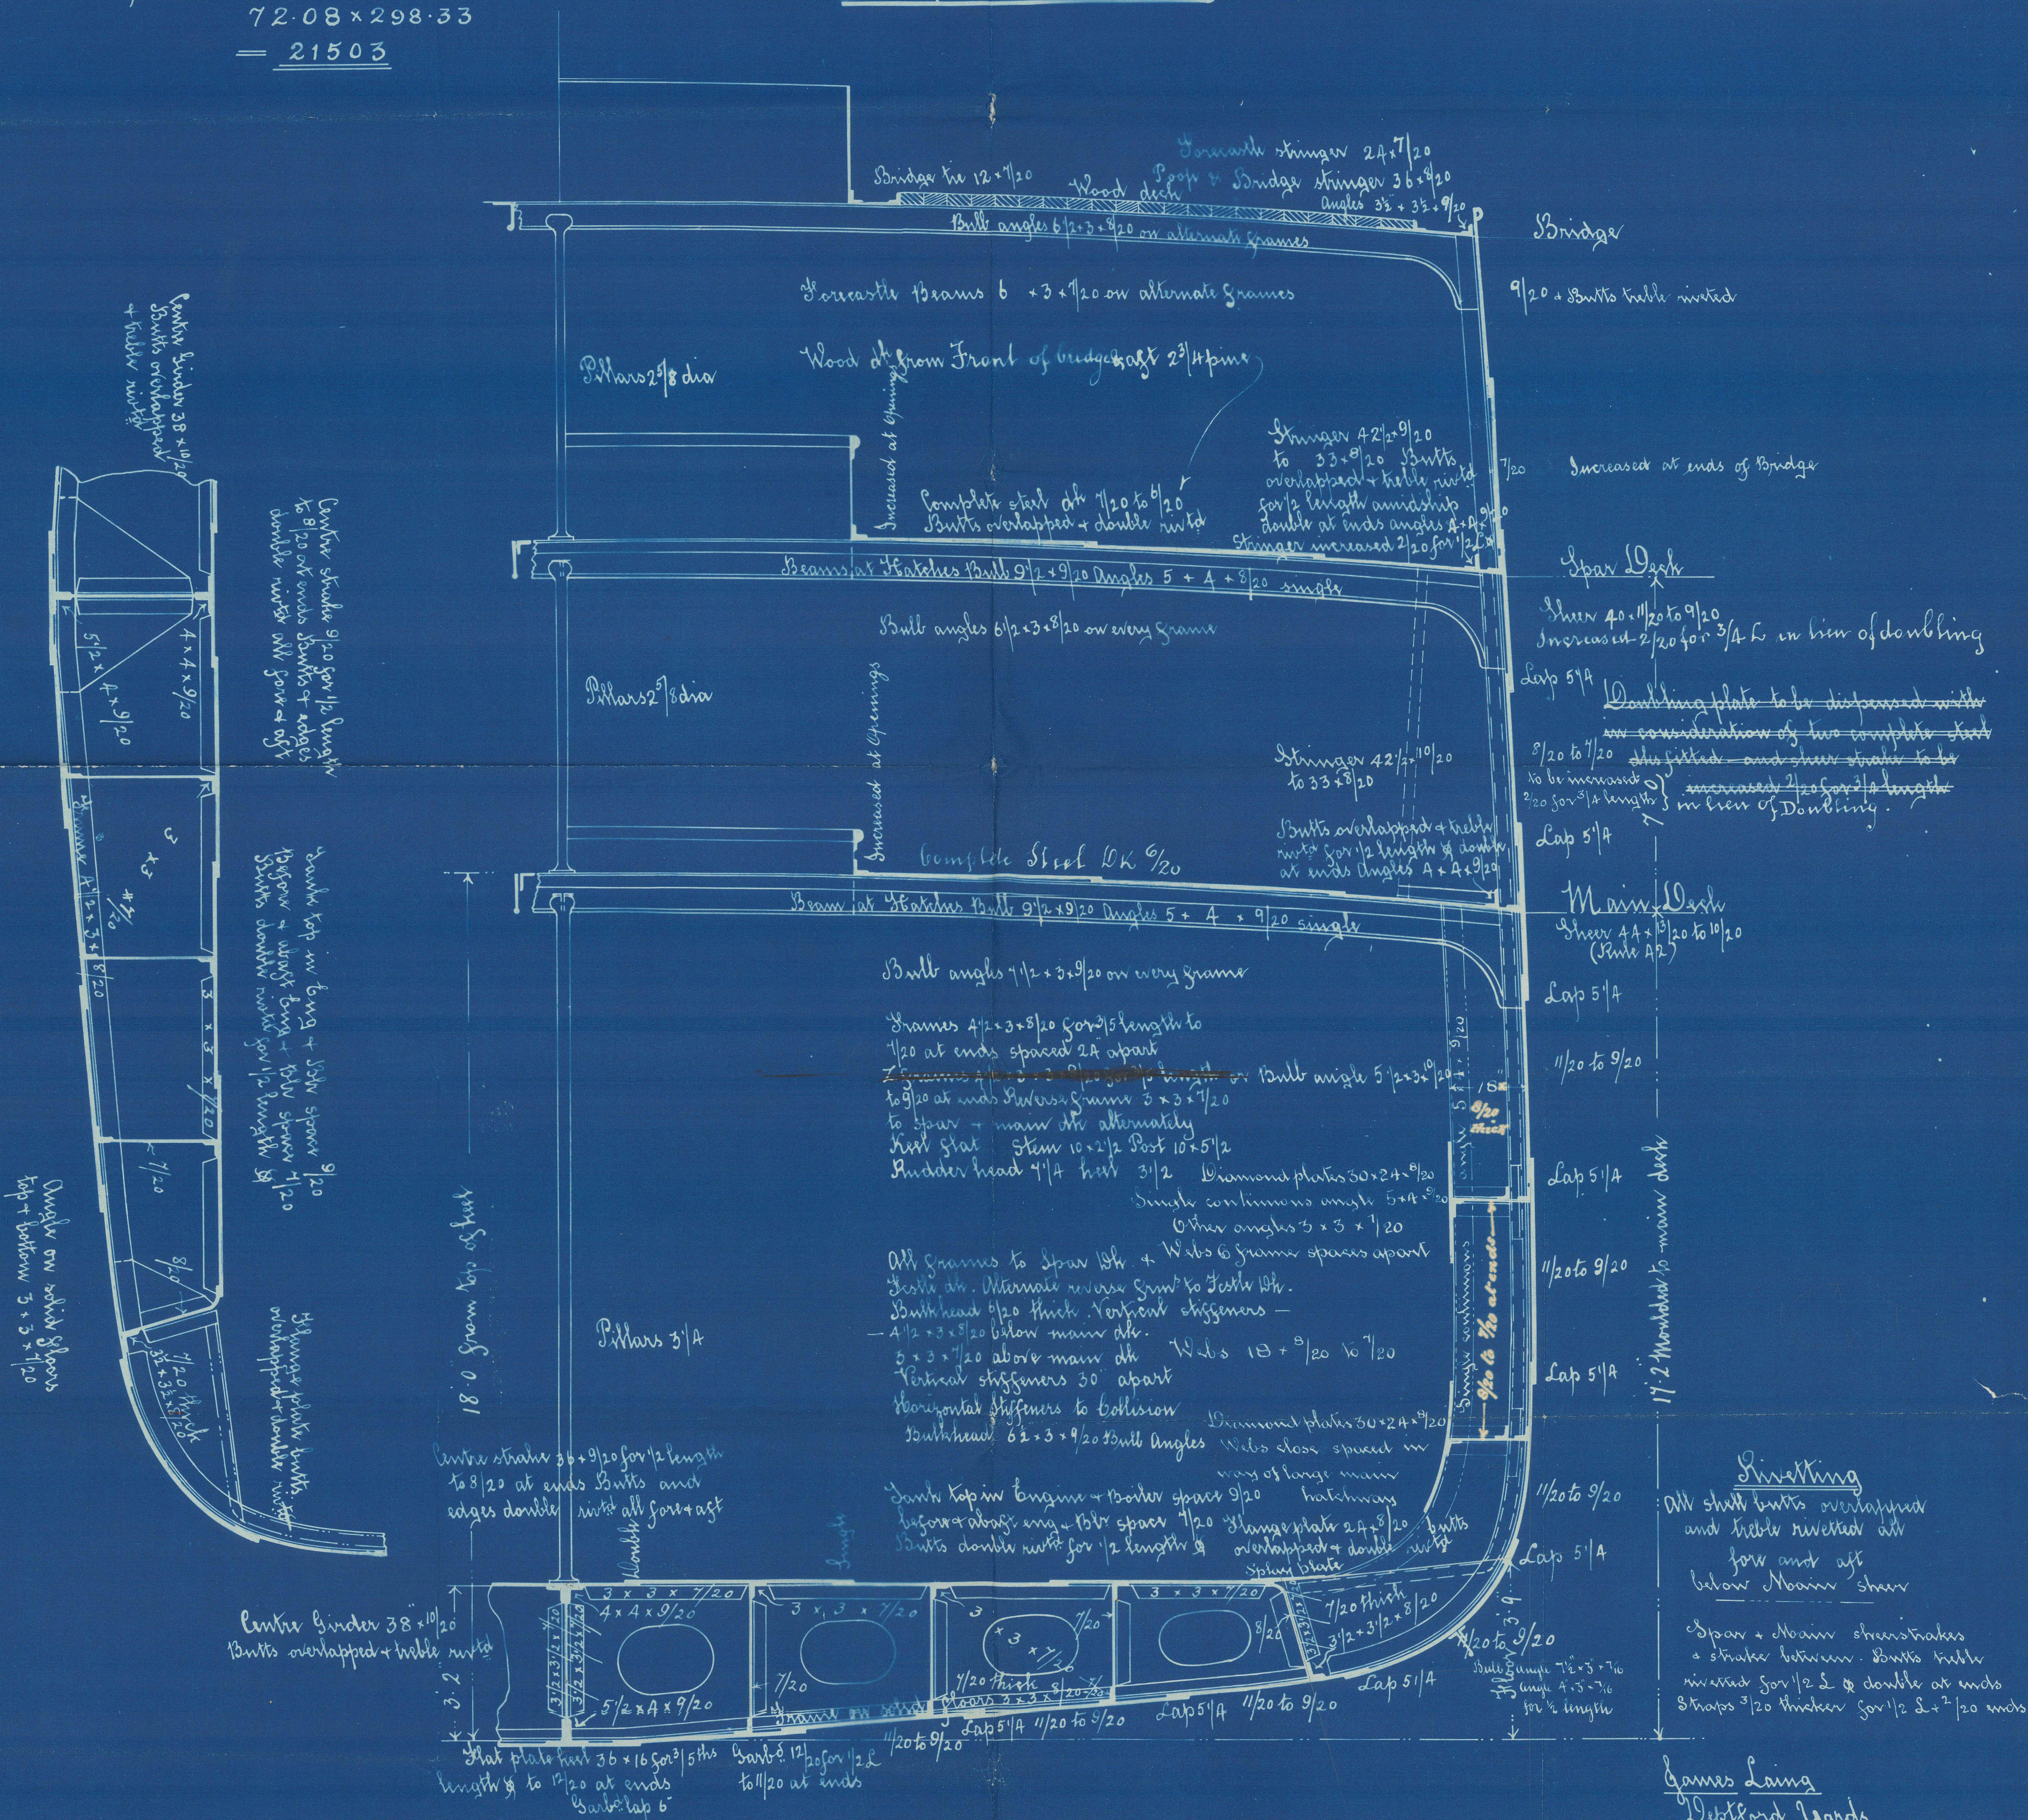

## Riveting

All shell butts overlapped and triple riveted all fore and aft below main sheer

Spar + Main sheerstake + stake between. Butts triple riveted for 1/2 L & double at ends. Straps 3/20 thicker for 1/2 L & 2/20 ends

James Linn  
Deftford Yards  
Sunderland



J. Larrig

5-25

Mid Section  
as Built

S. S. Unfuli  
Sunderland Report  
No 17162.

---



© 2021

Lloyd's Register  
Foundation

SLD988-0183