



1. 11. 05
18. 12. 05
27. 12. 05
14. 8. 06
15. 8. 06
21. 9. 06
15. 10. 06
2. 11. 06
7. 11. 06

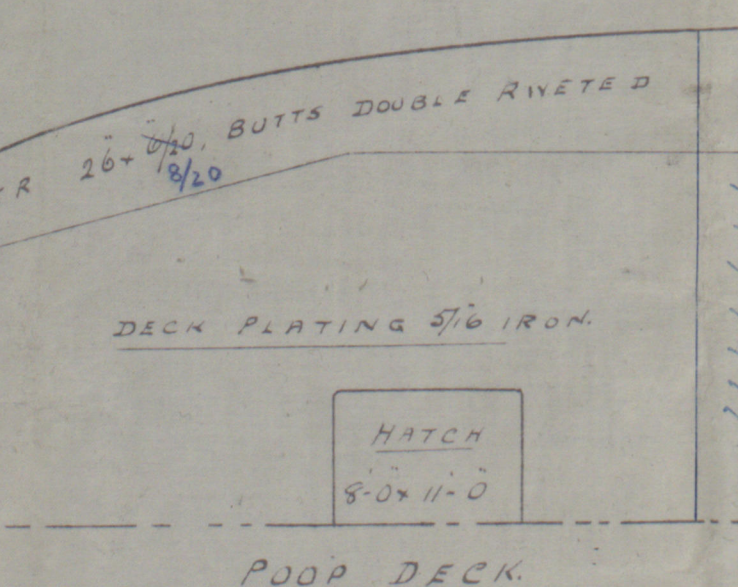

PROFILE DECK & STRINGER PLANS
OF SPAR DECK STEAMER.
DIMENSIONS. 376.0 B.P. x 52.0 M.P. x 28.0 M.P.
1/8" SCALE.

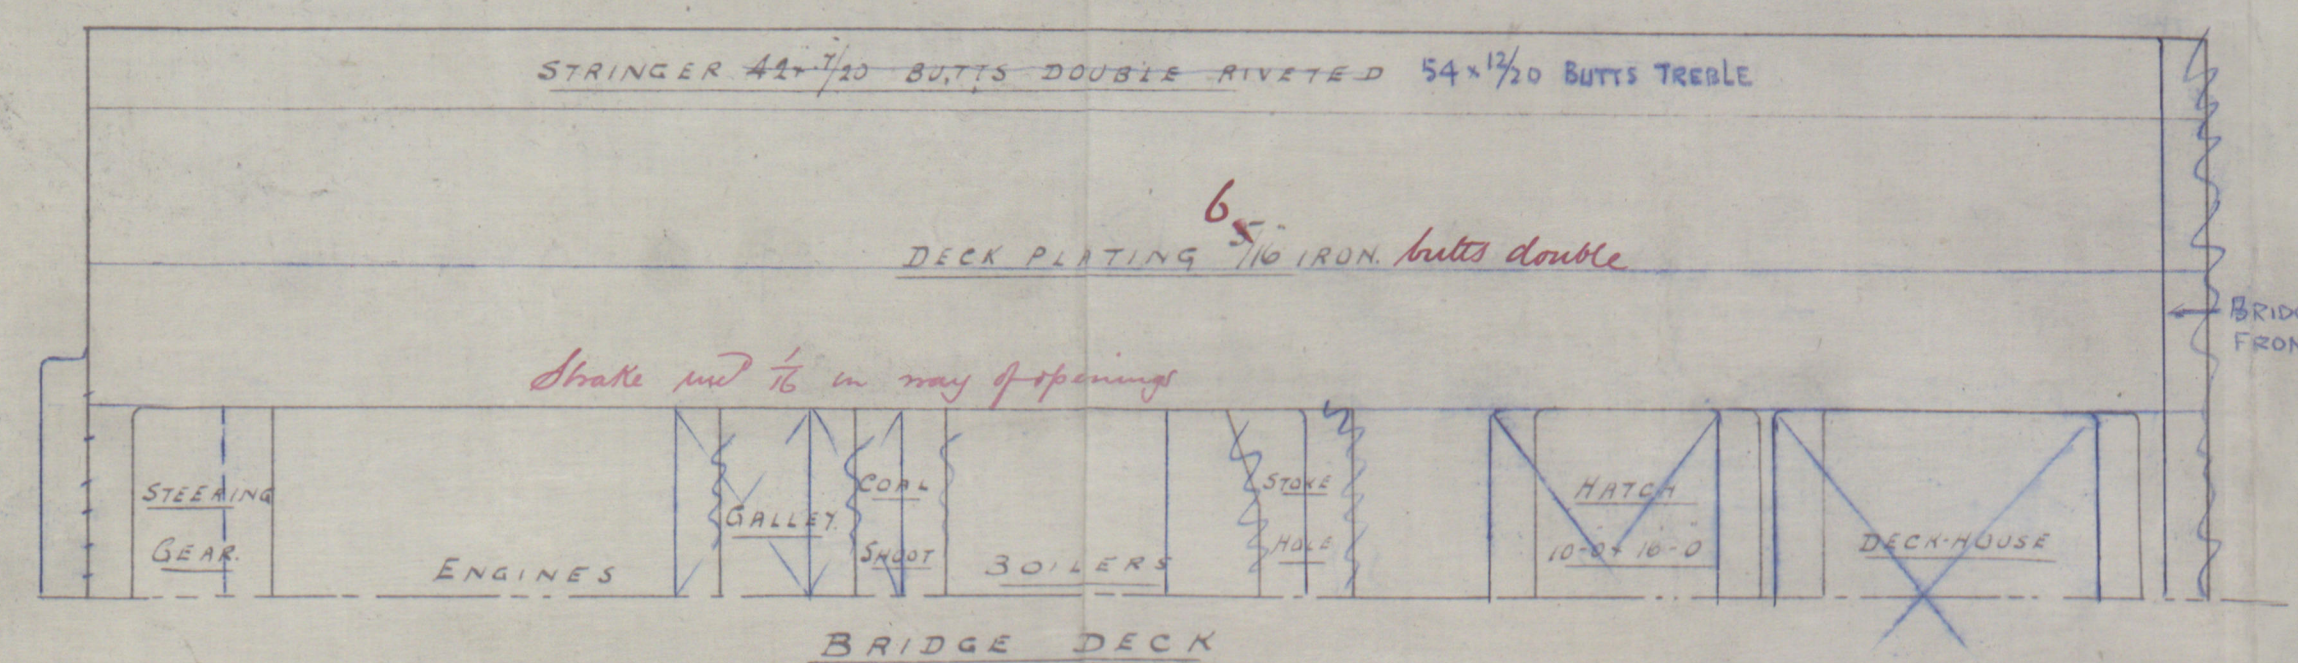

N. B.
For arrangement of vessel
as built - see revised Profile Plan
W.L.B.

R. CRAIG & SONS LTD.
SHIPBUILDERS & REPAIRERS
THE DOCKYARD
MIDDLESBROUGH

C.B.
1. 11. 03
21. 12. 03

211.212218

WLG.
23/10/05

© 2018 Lloyd's

K. Braggs & Sons Ltd

S. S. No 211-12-18





Profile & Deck Plans.

Fitzclarence 211

Mdb Report No 4993.

No 212. sp Fitzpatrick

Mdb report No

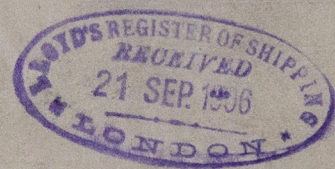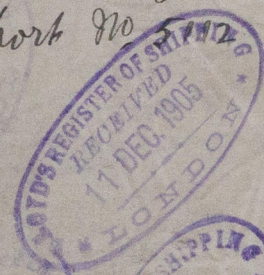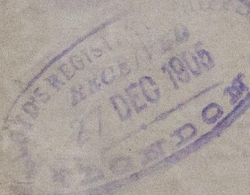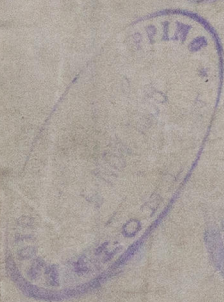

© 2019

Lloyd's Register
Foundation

W100-0054