
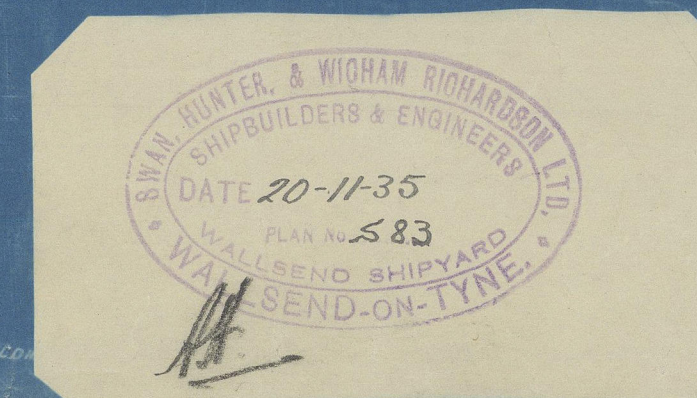
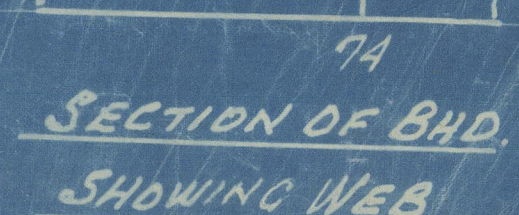
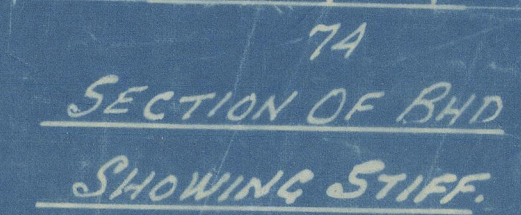
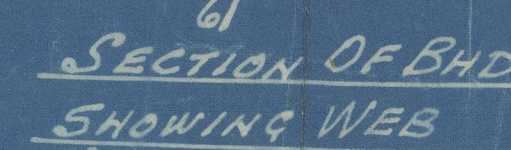
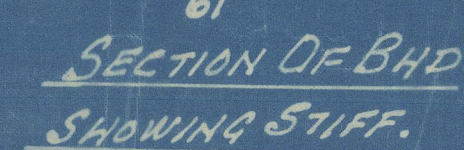


WELDED CONSTRUCTION ^{3x4x}

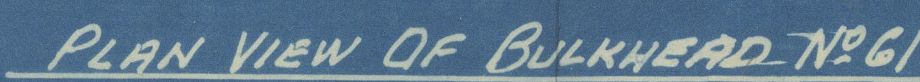

(27)

(EW)

Swan Hunter's No 1513

Deep tank
as built

SS "HOPESTAR"

NEWCASTLE ON TYNE.

Report No. 93528.



© 2020

Lloyd's Register
Foundation

W1014-0167