

# T. S. S. LEITRIM. MIDSHIP SECTION.

DIMENSIONS - 470'-0" x 59'-9" x 31'-4" MLD.

SCALE 1/2" = 1 FOOT.

TO CLASS 100 A1 LLOYDS.

NUMERALS	
BREADTH	59.75
DEPTH (59.57-8)	51.37
LENGTH	470
1/2	11.94
3/4	9.93

RULE EQUIPMENT	
NUMERAL	91.00 x 470
SHELTER	470 x 8 x 3/4
BRIDGE	108 x 8 x 3/4
FOUR	488 x 8 x 3/4
HOUSES	128 x 7.75 x 3/4
1/2	580 x 7.75 x 3/4
3/4	207 x 7.75 x 3/4
25	25 x 7.75 x 3/4
470.00	
2 BOWER ANCHORS	8 WEIGHTS EACH STOCKLESS
1 STREAM	23 1/2
1 KEDGE	11
500 FATHOMS	2 1/2
HANGERS & WARPS	TO OWNERS REQUIREMENTS

P 51' x 72' QUAD RV  
FOUR 44" DOUBLE RV

O 57' x 63' QUAD RV  
FOUR 44" DOUBLE RV

N 49' x 86' QUAD RV  
OR DOUBLE STRIPS TREBLE RV  
QUAD TO TREBLE AT ENDS.  
68" IN BRIDGE QUAD RV  
DBL. BRIDGE ENDS.

M 59 1/2' x 78' 48" QUAD RV  
QUAD TO TREBLE AT ENDS  
70" IN BRIDGE QUAD RV

L 72' x 70' 48" QUAD RV  
TREBLE AT ENDS

K 69 1/2' x 70' 48" QUAD RV  
TREBLE AT ENDS

J 72' x 70' 48" QUAD RV  
TREBLE AT ENDS

H 72 1/2' x 70' 48" QUAD RV  
TREBLE AT ENDS

G 72' x 70' 48" QUAD RV  
TREBLE AT ENDS

F 72' x 70' 48" QUAD RV  
TREBLE AT ENDS


E 80' x 70' 48" QUAD RV  
TREBLE AT ENDS

D 70 1/2' x 70' 48" QUAD RV  
TREBLE AT ENDS

C 80' x 70' 48" QUAD RV  
TREBLE AT ENDS

B 70 1/2' x 70' 48" QUAD RV  
TREBLE AT ENDS

A 70 1/2' x 70' 48" QUAD RV  
TREBLE AT ENDS

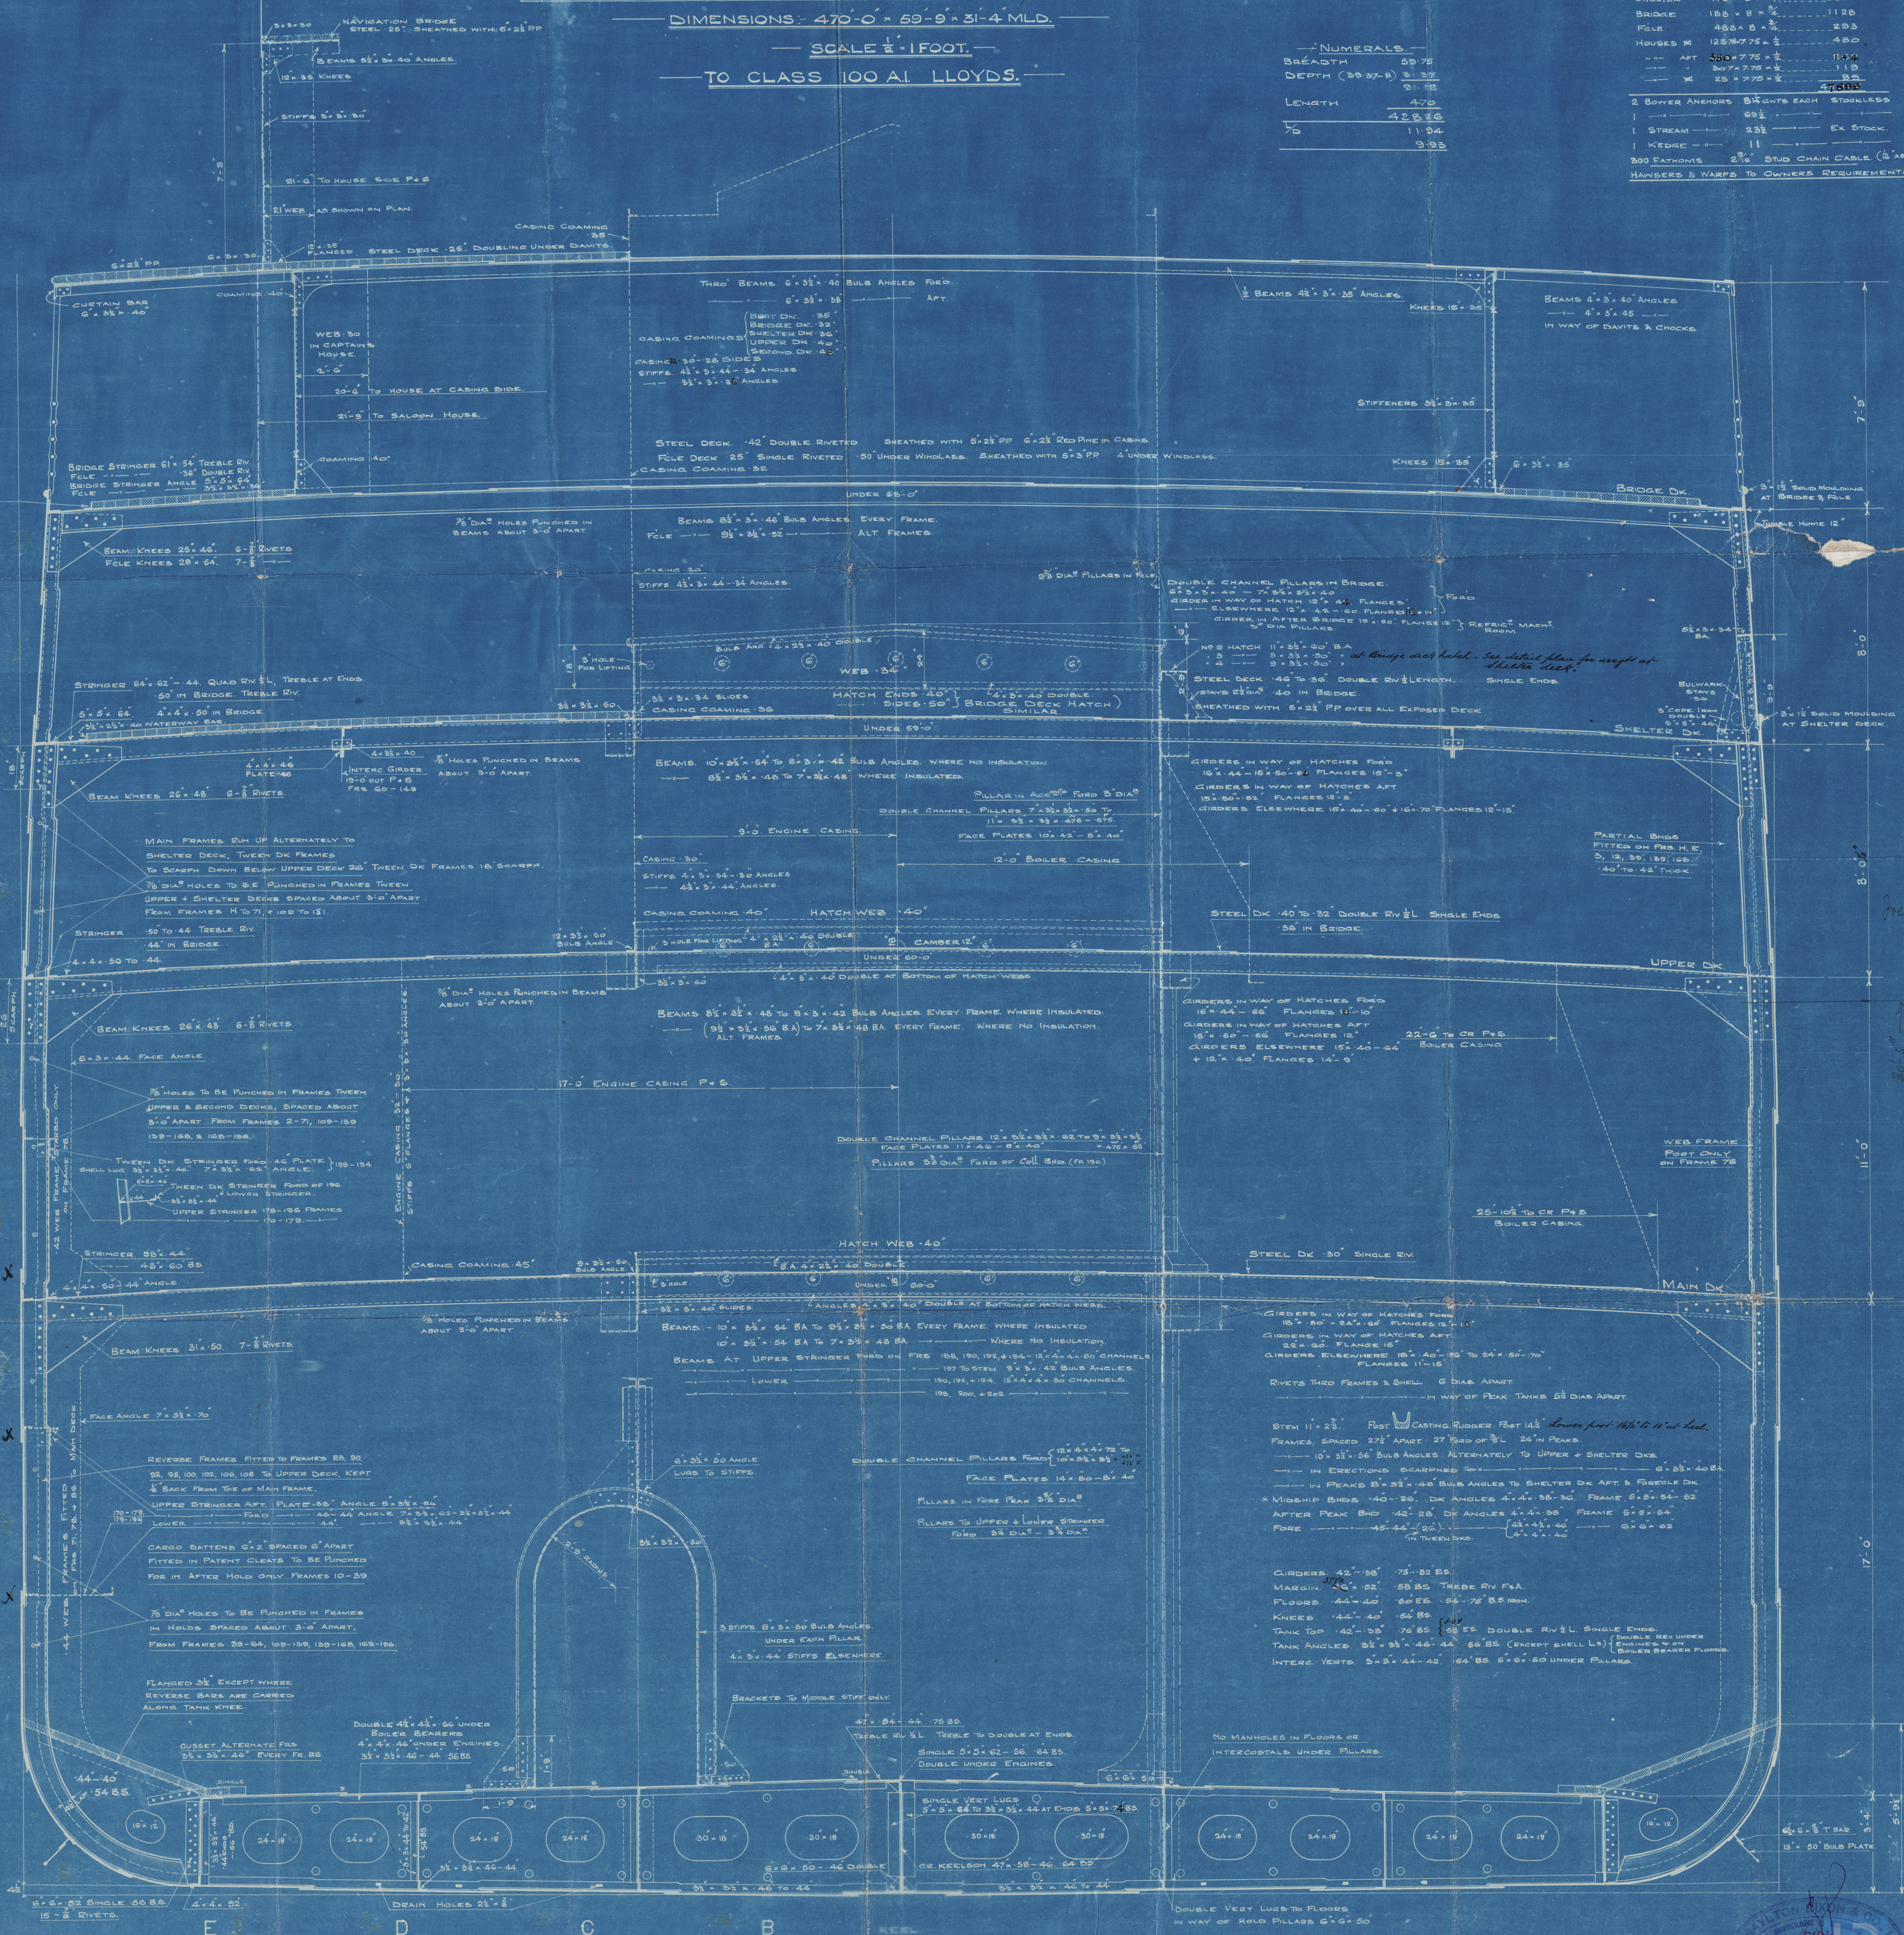

8" shells riveted landings  
in fore & aft bodies  
as per profile.

Interstrut  
at 3"



Nº 588

W1020-0180

Messrs. Sir. Raydon Dixon & Co<sup>s</sup>

No 588

"Harbada"


T. S. S. LEITRIM

Harbada

MIDSHIP SECTION

(as built)

Middleborough Report No. 9209.

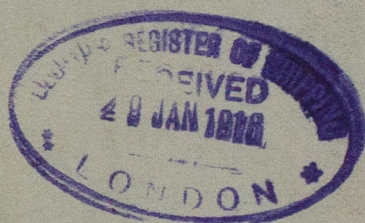

RETAIN



© 2020

Lloyd's Register  
Foundation