


- S.S N° 258 -

- PROFILE & DECK PLAN -



- LENGTH B.P. 356'-3" BREADTH EX. 48'-9" DEPTH MLD. 25'-11" -

- SCALE 1/4" = 1 FOOT -

- ARRANGEMENT OF SHELL PLATING IN WAY -  
- OF SHORT WELL AFT -

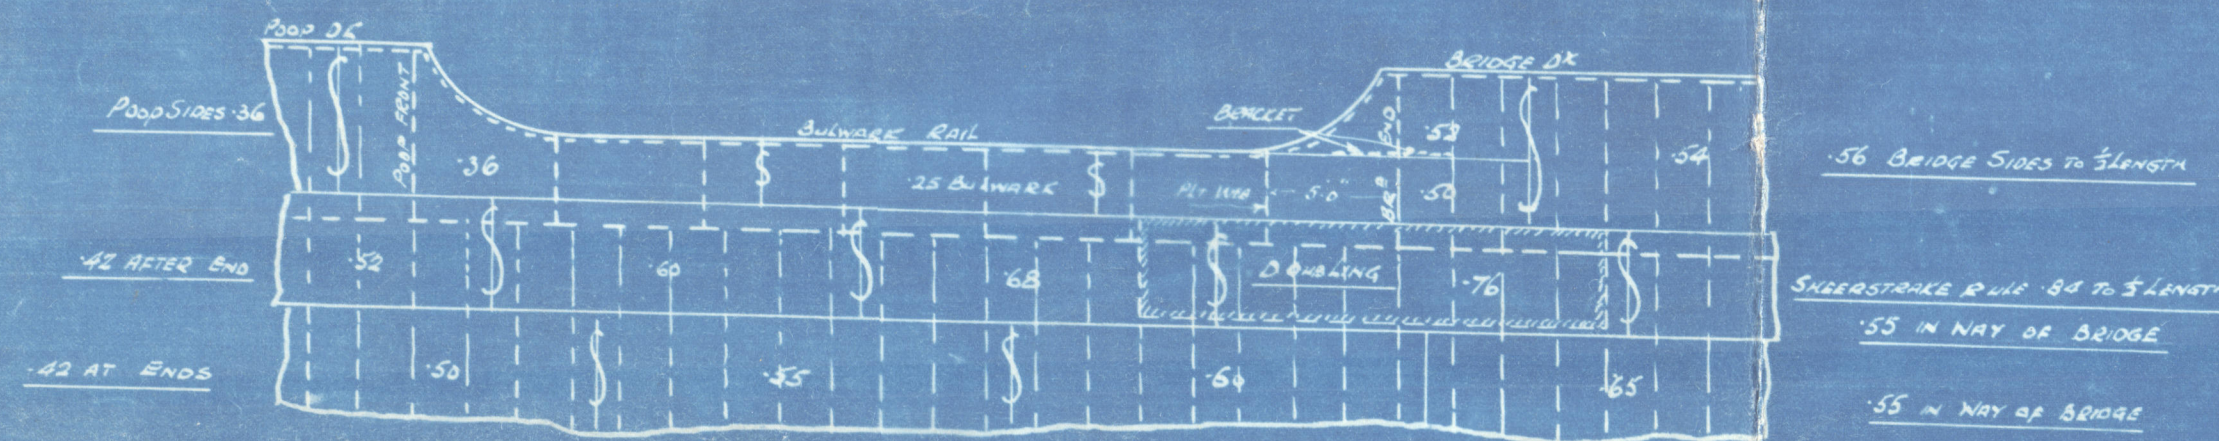

- ARRANGEMENT OF SHELL PLATING IN WAY -  
- OF SHORT WELL FORWARD -

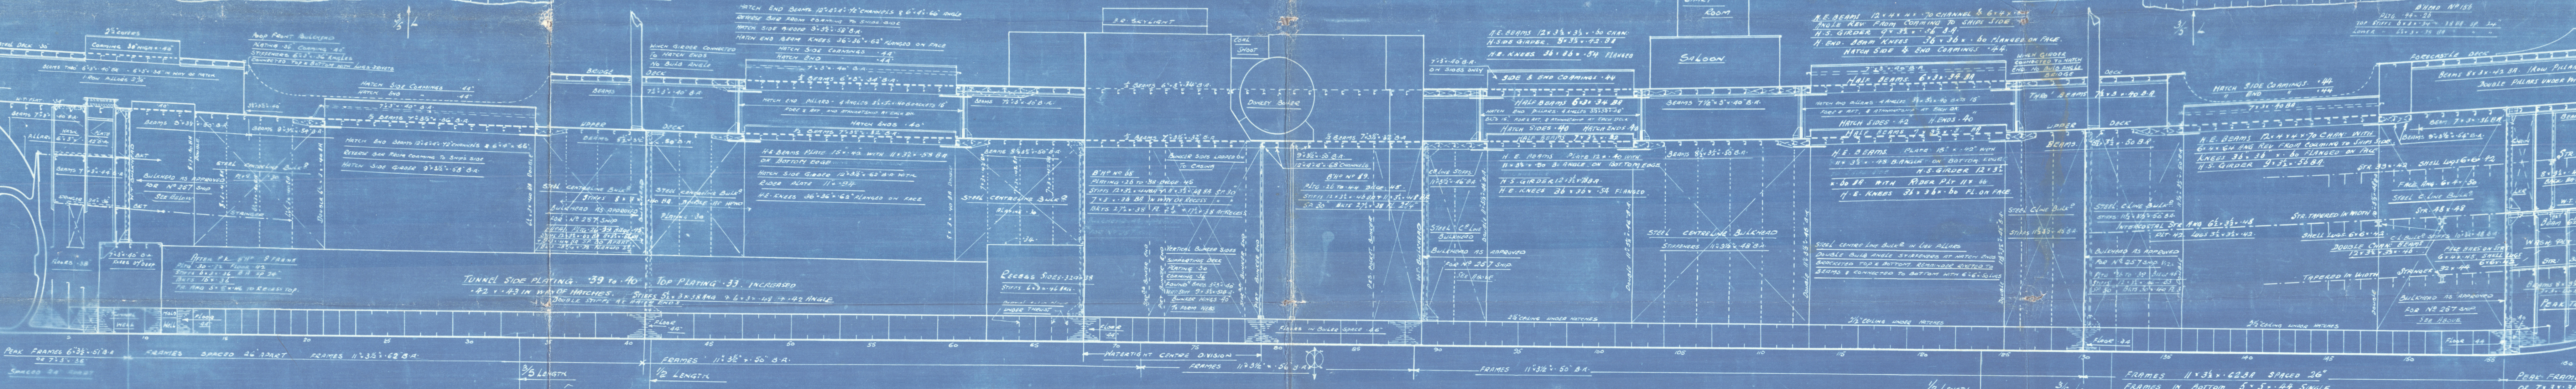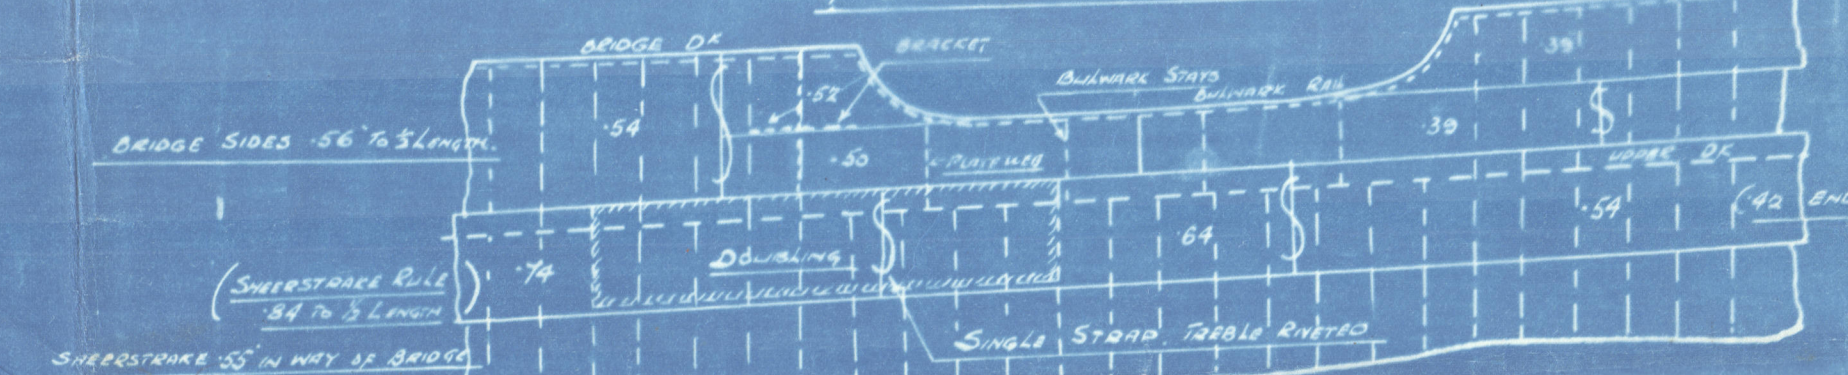

- POOP DECK -  
Shell side plating 36, butts single, riveted seams single riveted.

- BRIDGE DECK -

- FORECASTLE DECK -  
PLAN No 1818  
SHIP No 258  
DATE 1/1/21  
JOHN BLUNTER & CO LIMITED  
SUNDERLAND



SUNDERLAND

S/S "CYDONIA"

Messrs John Blumer & Co<sup>s</sup>

Yard N<sup>o</sup> 258

PROFILE + DECK PLANS

(As Built)

SUNDERLAND RPT. NO. 29353.