


MIDSHIP SECTION.

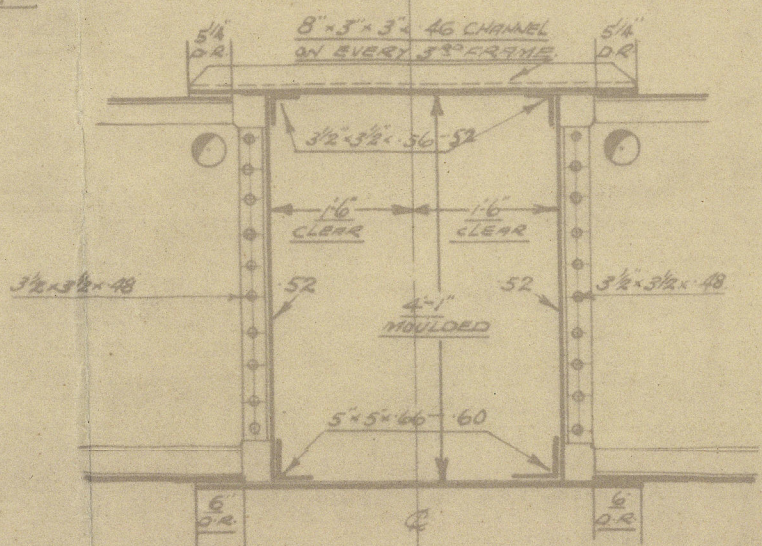

BUILDERS. No 15.

Plyds Register

© 2020

W1027-0026

Lloyd's Register
Foundations

Blythwood SBC

No 18

Pacific Enterprises

RETAIN

MIDSHIP SECTION

AS BUILT

W1027-0026

GLASGOW REPORT No 47351

Lower Deck Beam 10"

103



© 2020

Lloyd's Register
Foundation