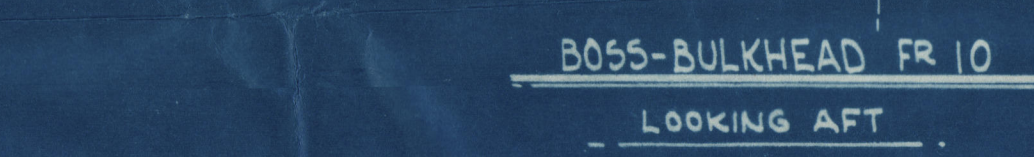
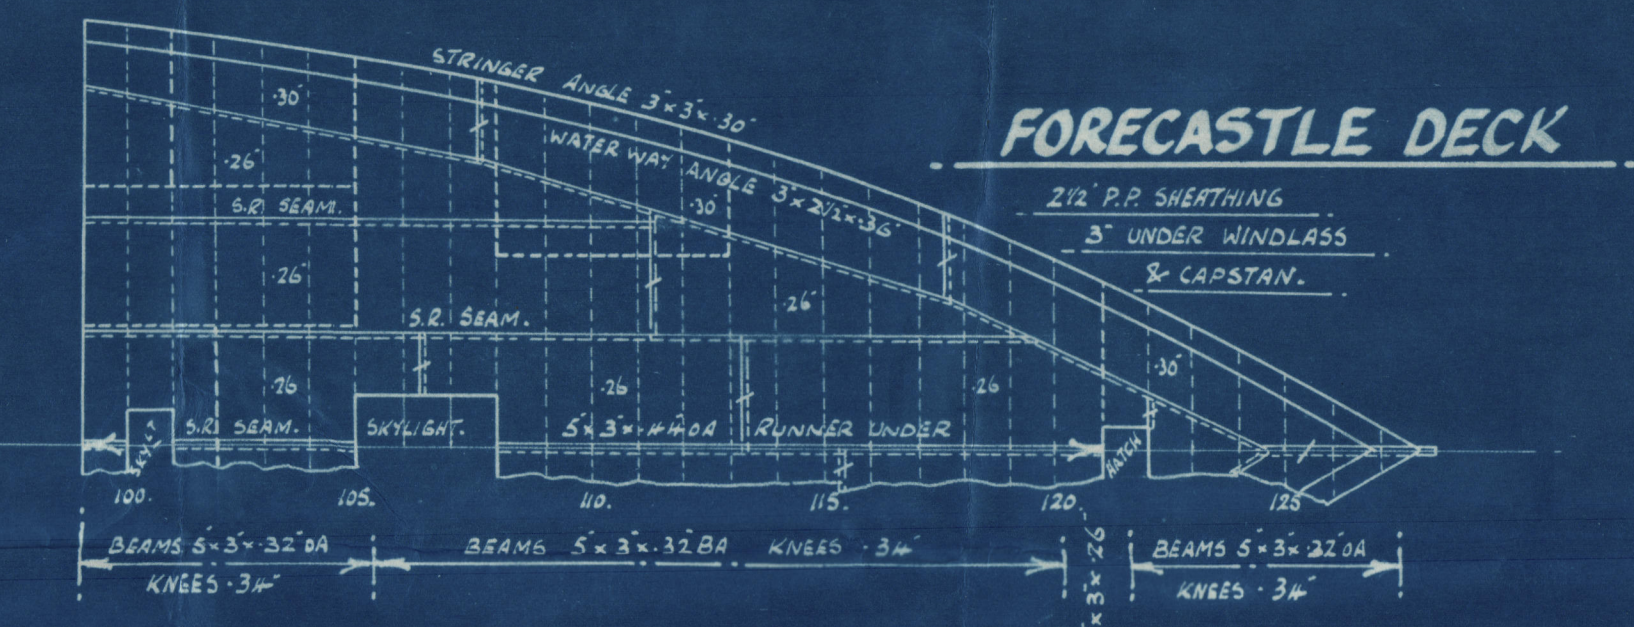


SUMMER MAXIMUM MEAN DRAFT 12'-9"

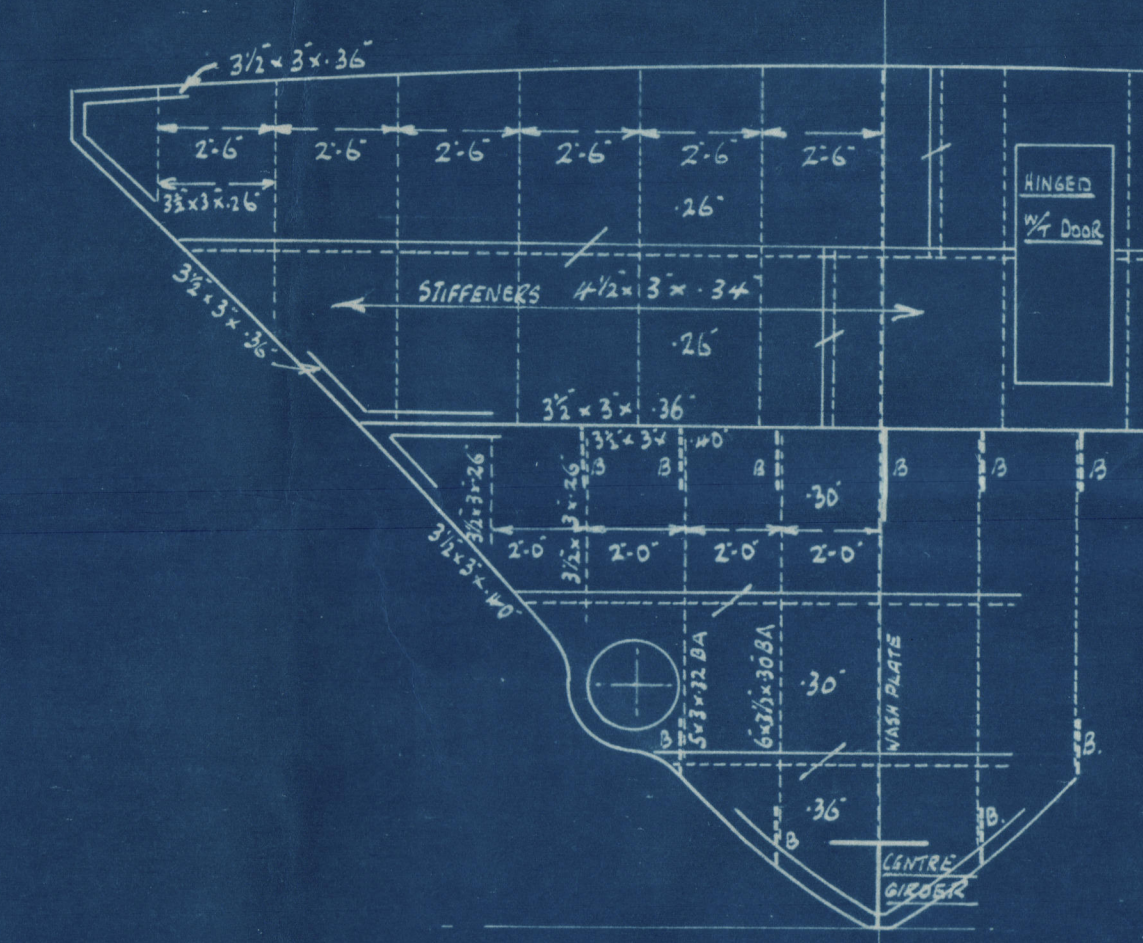
DATE 25/2/33

$$\underline{d = 14.71}$$

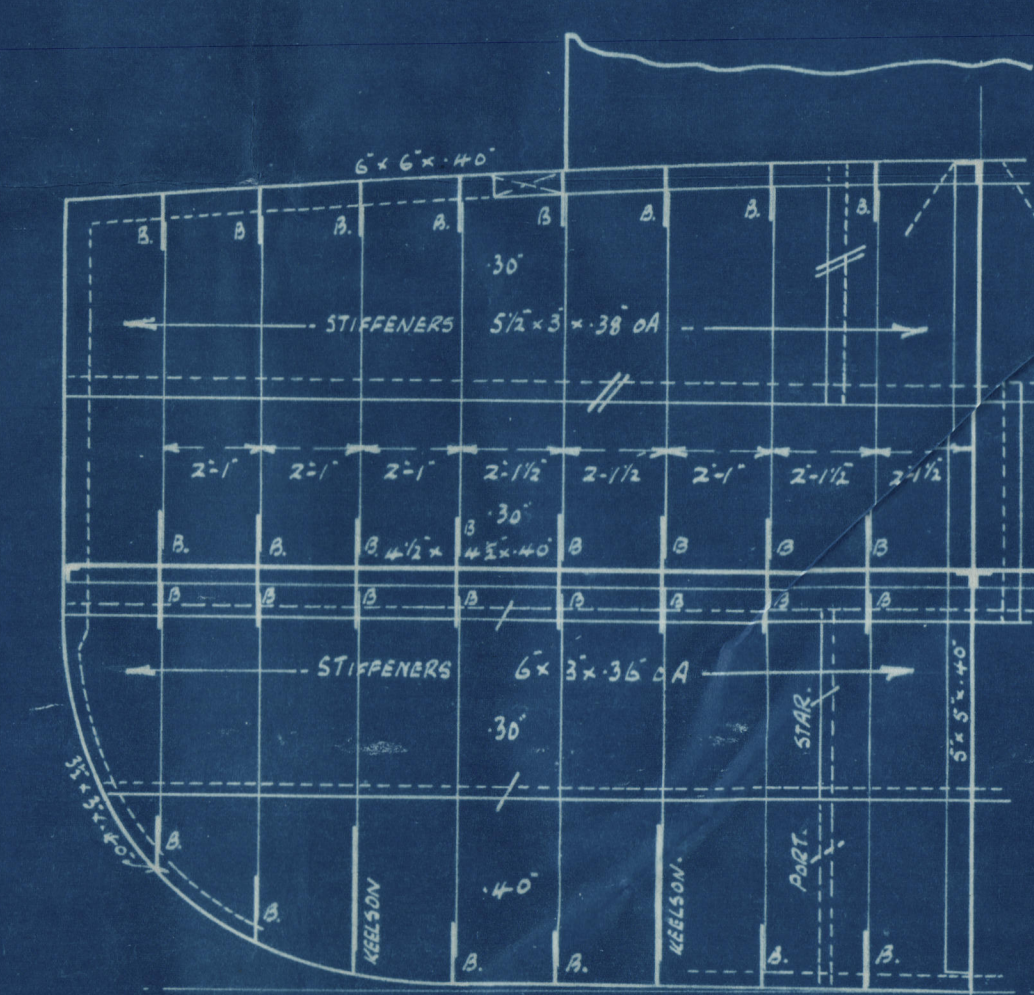
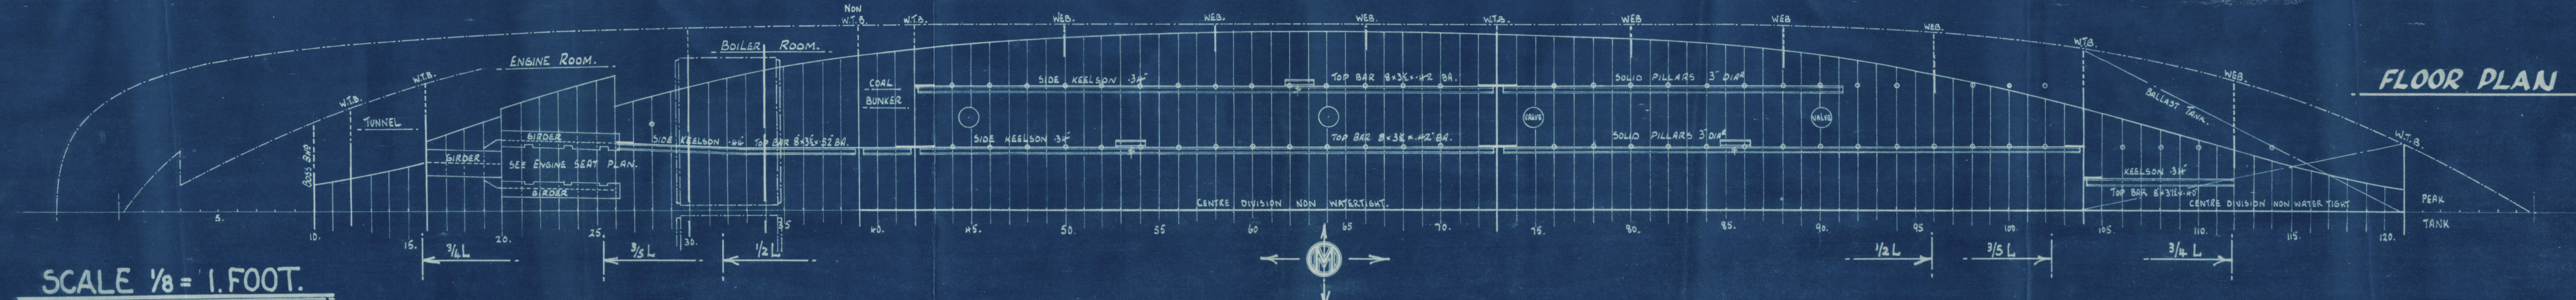
CENTRE DIVISION WATERTIGHT IN SLUDGE TANKS. — NON-WATERTIGHT BELOW LOWER DECK



W.T. BULKHEAD FR 16.  
LOOKING AFT.

[illegible]

NON.W.T. BUNKER BULKHEAD FB 39.  
- LOOKING AFT. -

[illegible][illegible][illegible]

W.T. BULKHEAD FB 73.  
LOOKING AFT.

W.T BULKHEAD FR 104  
LOOKING AFT

W.T. BULKHEAD FB 121.  
LOOKING AFT

SCALE  $\frac{1}{8} = 1$ . FOOT.

**BULKHEADS — SCALE  $\frac{1}{4}'' = 1$  FOOT.**

W103-0240



T. S. S. MANCINIUM

Grk 19522.

FERGUSON BROS

Nº 305

PROFILE & DECKS

&

W. T. BULKHEADS

AS BUILT

GRNK 1<sup>ST</sup> ENTRY REPORT

Nº 19522



© 2021

Lloyd's Register

W103-0240