

STANDARD STEAMER TYPE C


MIDSHIP SECTION.

SCALE 1/2-1 FOOT.

DIMENSIONS 331.0 BP x 46.6 M-P x 25.6 M-P

CLASS 100 A1 LLOYDS

	POOP	FOLE
SIDE PLATING	36	38
STRINGER PLATE	32 x 32	32 x 32
ANGLE	3 x 3 x 32	3 x 3 x 32
DECK PLATING	25	30
BEAMS	7 x 3 x 36 BA	8 x 3 x 44 BA
BEAM KNEES	20 x 40	20 x 40
PILLARS	2 3/4	2 3/4

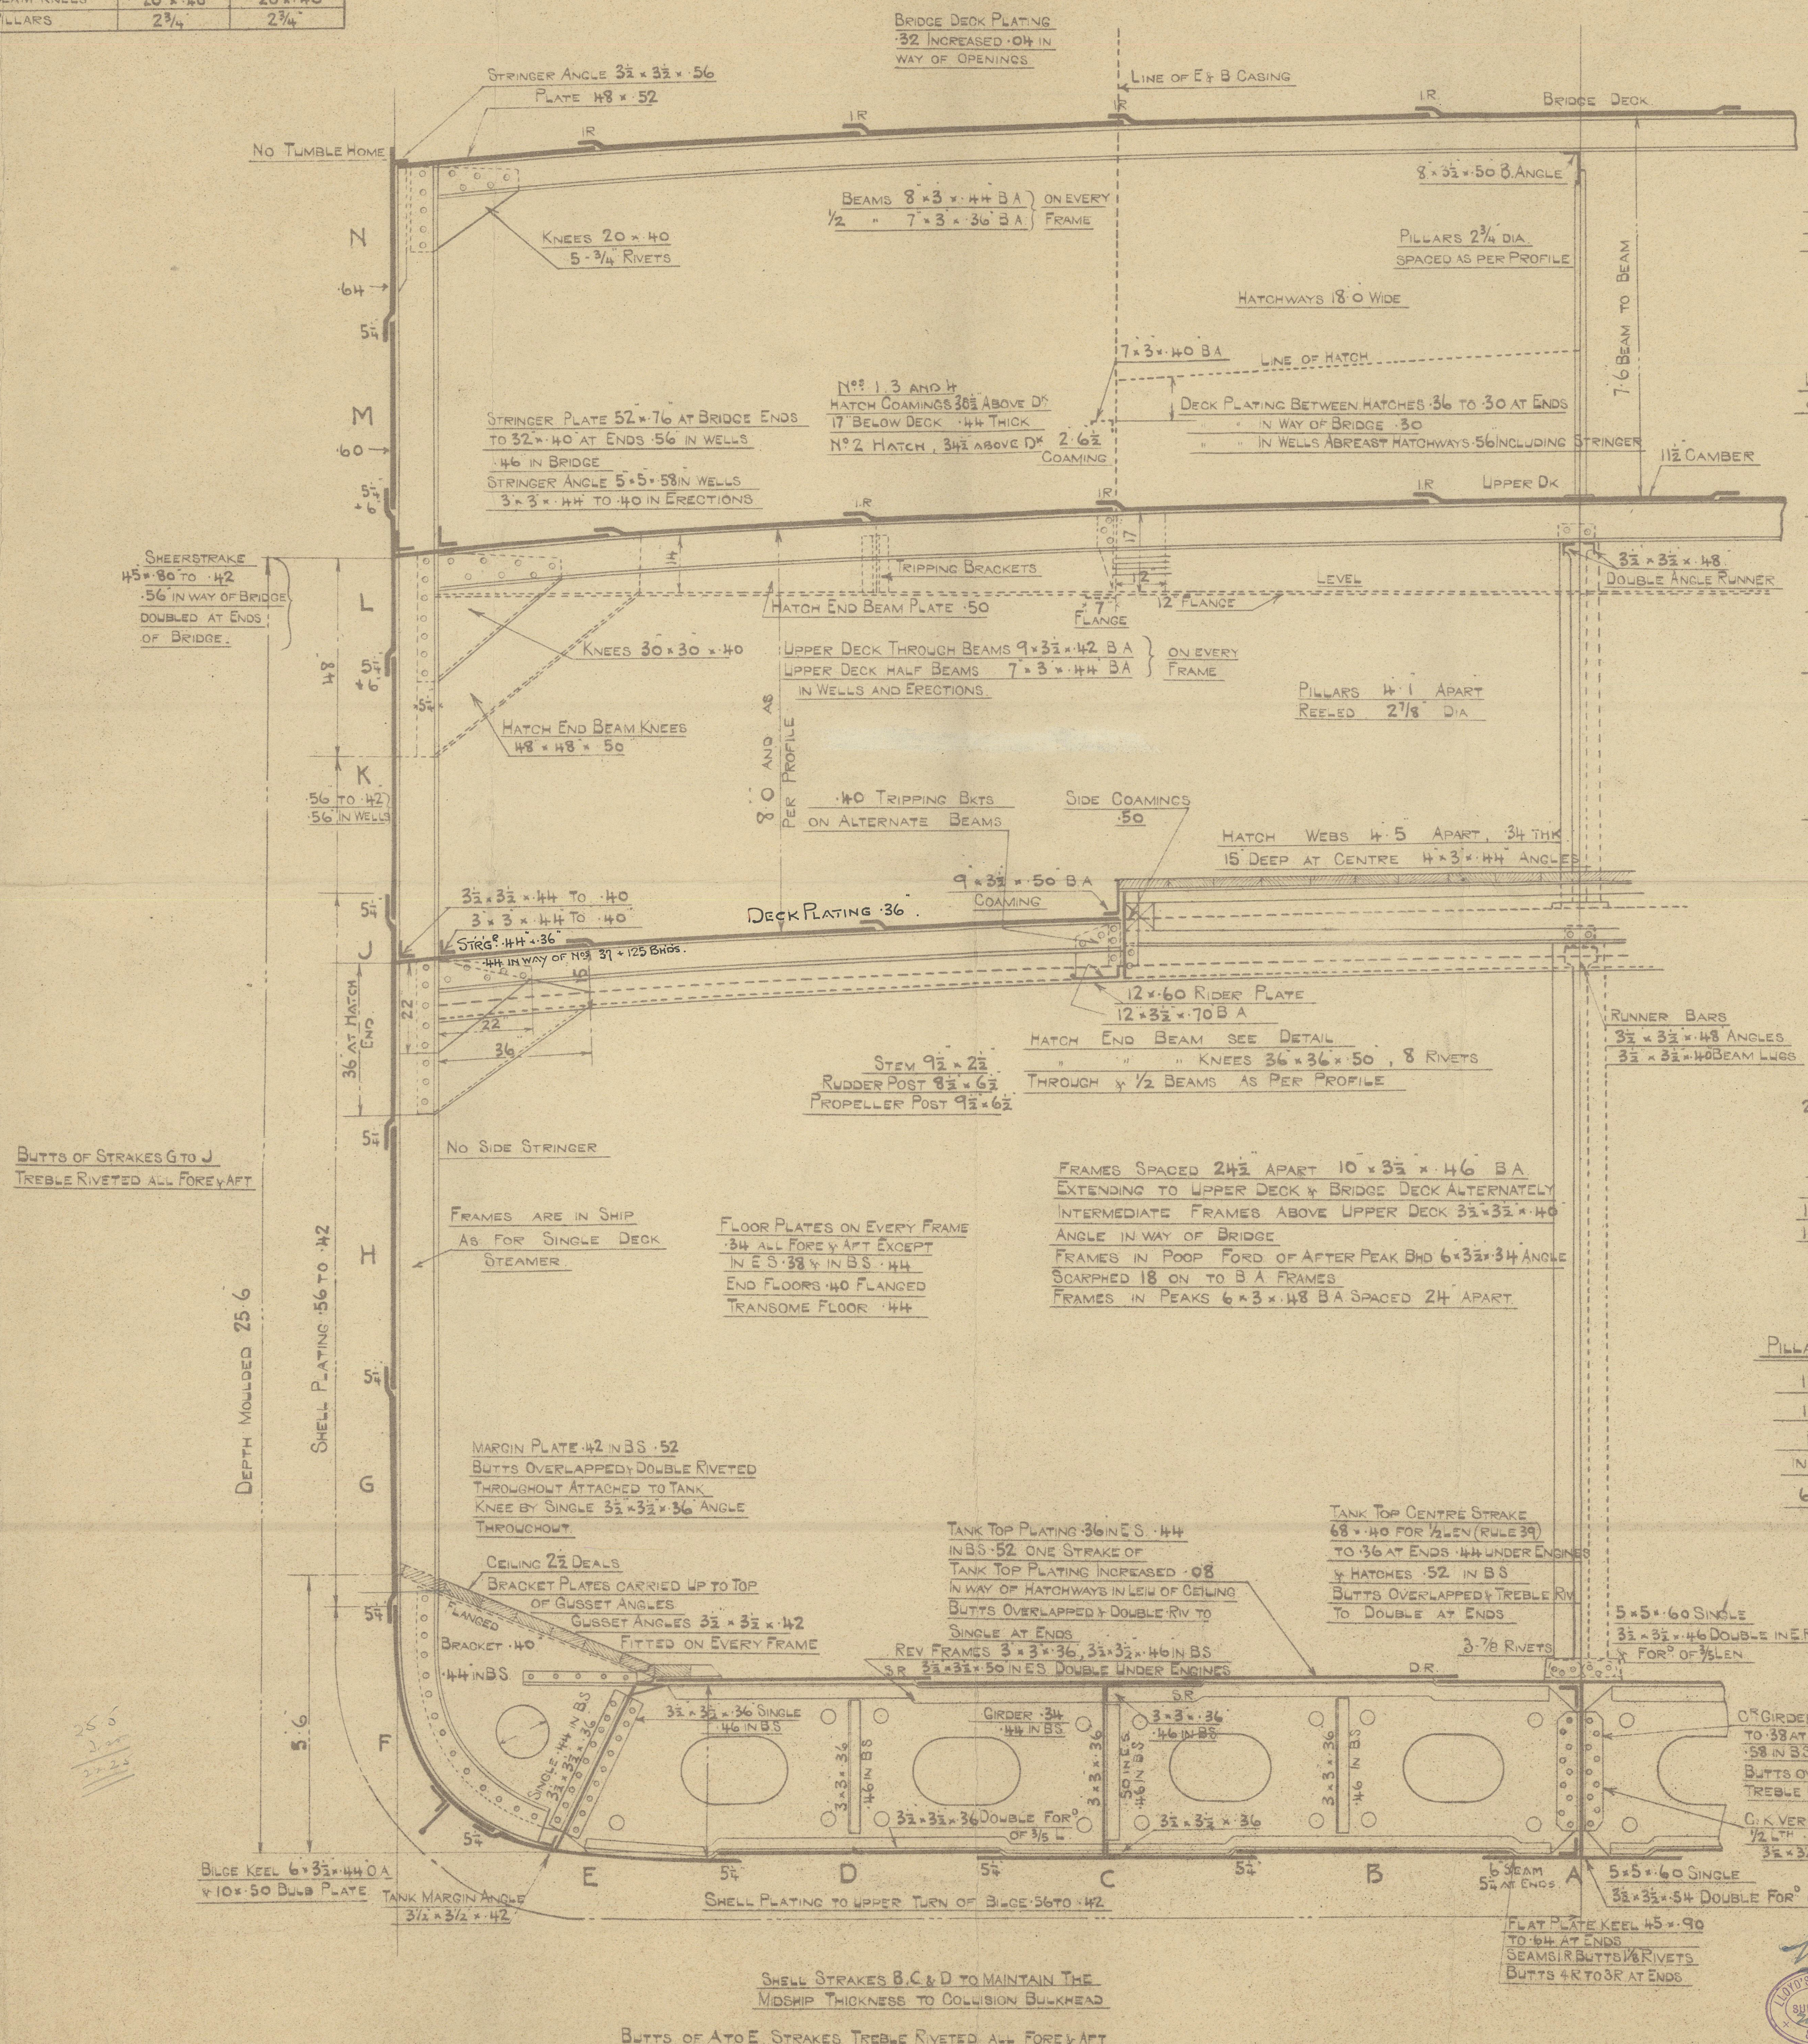

LLOYDS NUMERALS

MOULDED BREADTH (B)	= 46.5
DEPTH (D)	= 25.5
B x D	= 72.0
LENGTH (L)	= 331.0
L x (B x D)	= 23832.0

PROPORTIONS

LENGTHS TO DEPTH	4 D = 12.98
L WITH INCREASED BRACKETS	= 21.75

SHEER FOR	8'6"	1/8 LEN FOR	4'8"
AFT	4'3"	1/8 "	AFT = 2'14"

EQUIPMENT NUMERALS

L x (B x D)	= 331 x (46.5 + 25.5) = 23832.00
-------------	----------------------------------

ERECTIONS

POOP	32.92
BRIDGE	98.00
FOLE	28.58
159.50 x 7.5 x .75	= 897.19

CASINGS & HOUSES

ENGINE CASING 29'48" x 7'5" = 103.11

SALOON HOUSE 26'54" x 7'5" x .75 = 149.29.252.40

EQUIPMENT N°

= 24981.59

EQUIPMENT

2 BOWER ANCHORS STOCKLESS	45 CWTs
1 " "	38
1 STREAM ANCHOR EX STOCK	12
1 KEDGE	5 1/2
270 FATHOMS 1 1/2" STUD CHAIN CABLE	
90 " 4 1/4" STEEL WIRE HAWSER	
100 " 4" STEEL WIRE HAWSER	
1.90 " 7" HAWSER & 1.90 FATHOMS 2 1/2" STEEL WIRE	
1.90 " 6 " 1.90 " 2 1/4 "	

PILLARS 4'1" APART REELED

14 TO 16 FT	4 3/4" DIA
16 " 18 "	5 "
18 " 20 "	5 1/4 "
IN WAY OF TUNNEL	
6 TO 8 FT.	3 1/2" DIA

8034
539
21.11.19



SUNDERLAND

S.S. "SYRIAN PRINCE"

J.L. THOMPSON'S NO 539

MIDSHIP SECTION

(AS BUILT)

SLO. RPT. NO 27674

RETAIN



© 2020

Lloyd's Register
Foundation

W1047-0225