

YARD No. 397

HULL SECTIONS.

SCALE : 1/2" = 1'-0"

DIMENSIONS : 195'-0" B.P. x 36'-0" x 17'-0" MLD.

APPROVED BY LLOYDS 22-12-49

RIVETING.
BUTTS OF SHEERSTAKE STRAPPED AND T.R. FOR 4 L & TO D.R. AT ENDS.
BUTTS OF KEEL PLATE WELDED OR T.R. ALL FORE AND AFT.
REMAINDER OF SHELL BUTTS LAPPED AND D.R. ALL FORE & AFT.
BUTTS OF DECK STRINGER PLATE LAPPED AND D.R. IN WAY OF HOPPER.
BUTTS OF DECK PLATING LAPPED AND D.R. TO S.R.
SHELL SEAMS ALL D.R.
DECK PLATING SEAMS ALL S.R.
BUTTS OF HOPPER PLATING LAPPED AND D.R.
SEAMS OF HOPPER PLATING LAPPED AND S.R.

TO CLASS LLOYDS 100 A.I. "HOPPER BARGE."

$L \times (B + D) = 10,335$
FORECASTLE 24' x 7' x 75" = 126
DECKHOUSE 55' x 7' x 50" = 213
BOAT DECK SALOON 10' x 5' x 75" = 41
EQUIPMENT NUMERAL = 10,715


EQUIPMENT
3 - BOWER ANCHORS; 2 @ 23 1/4" CWTs STOCKLESS AND ONE @ 20 1/4 CWTs STOCKLESS (OWNERS REQUIRE)
1 - STREAM ANCHOR 6 CWTs EX STOCK
210 - FATHOMS 1 7/8" WROT IRON STUD LINK CHAIN CABLE
IN 15 FATHOM LENGTHS COMPLETE WITH END AND JOINING SHACKLES.
60 - FATHOMS 3 1/2" CIRC. STEEL WIRE ROPE ON REEL FOR STREAM ANCHOR
90 - FATHOMS 3 1/4" CIRC. STEEL WIRE TOWLINE ON REEL.
90 - FATHOMS 6" CIRC. HAWSER.
90 - FATHOMS 5" CIRC. WARP.
1 - COIL 12 THREAD HEAVING LINE.

NUMERALS


L = 195.00, B = 36.00, D = 17.00.

d = 14.75


STEM = 6" x 15 1/8" : STERNPOST 5 1/2" x 4 1/2"

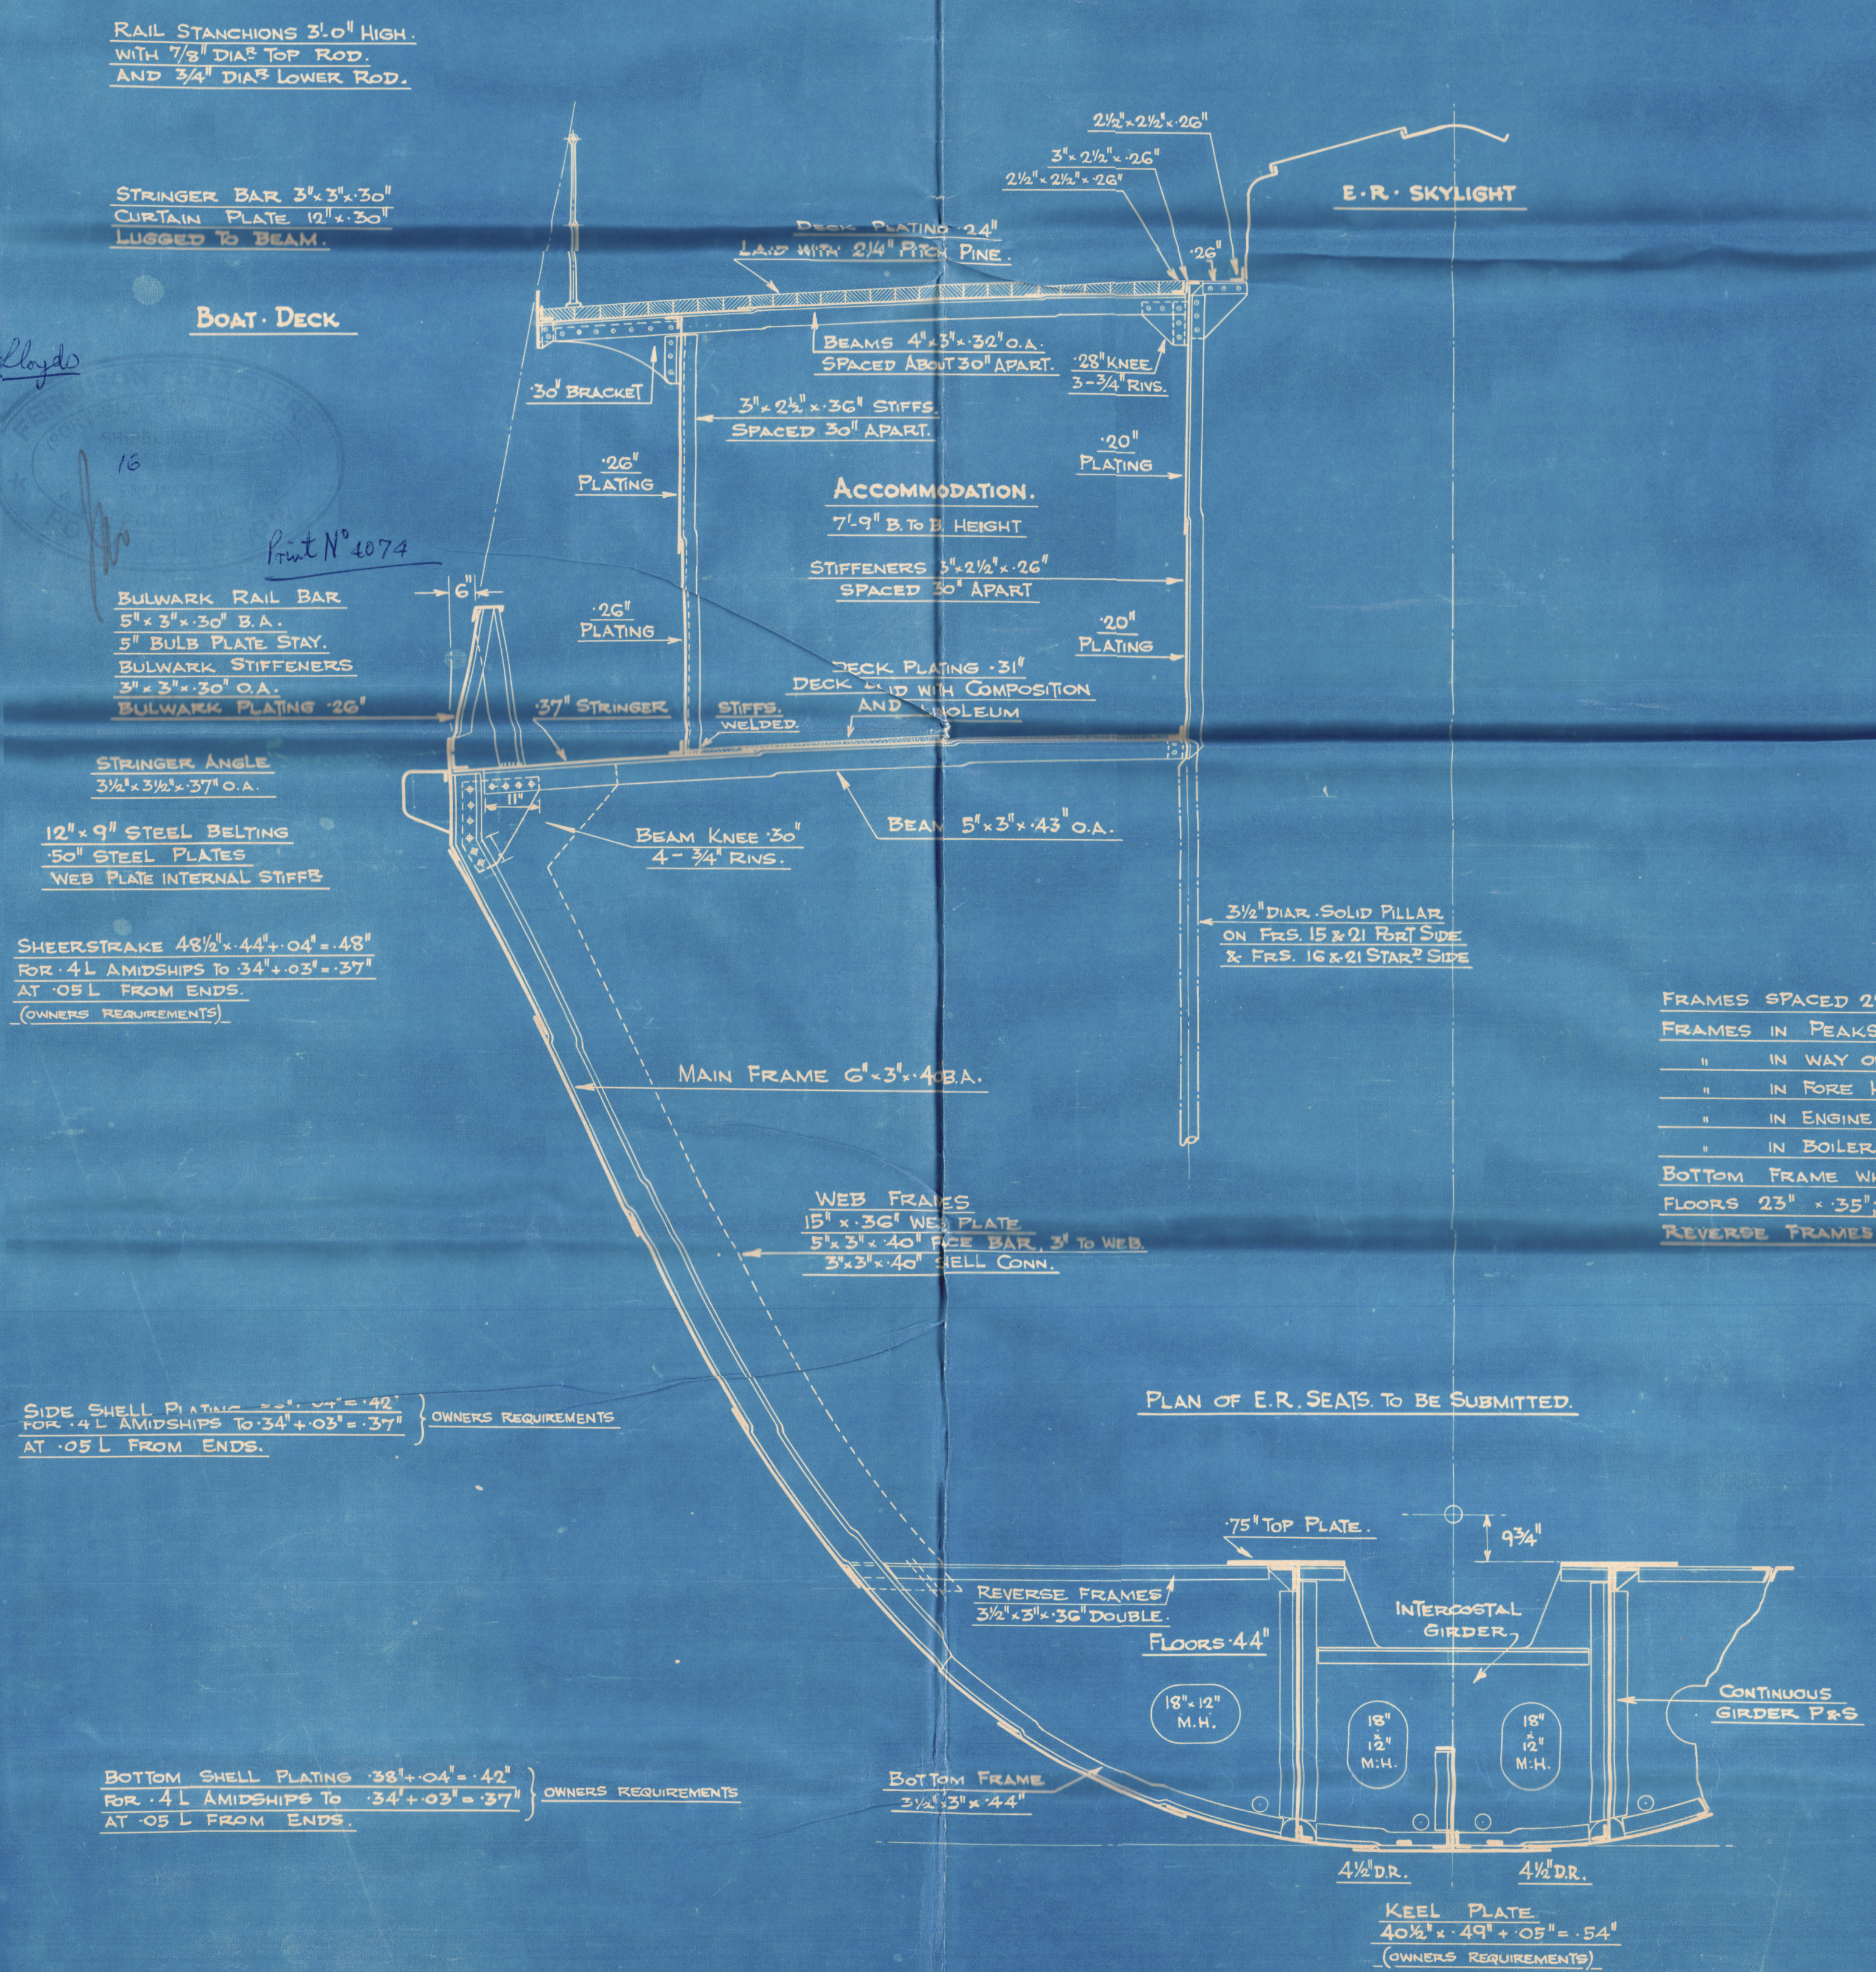

SECTION THRO' ENGINE ROOM.

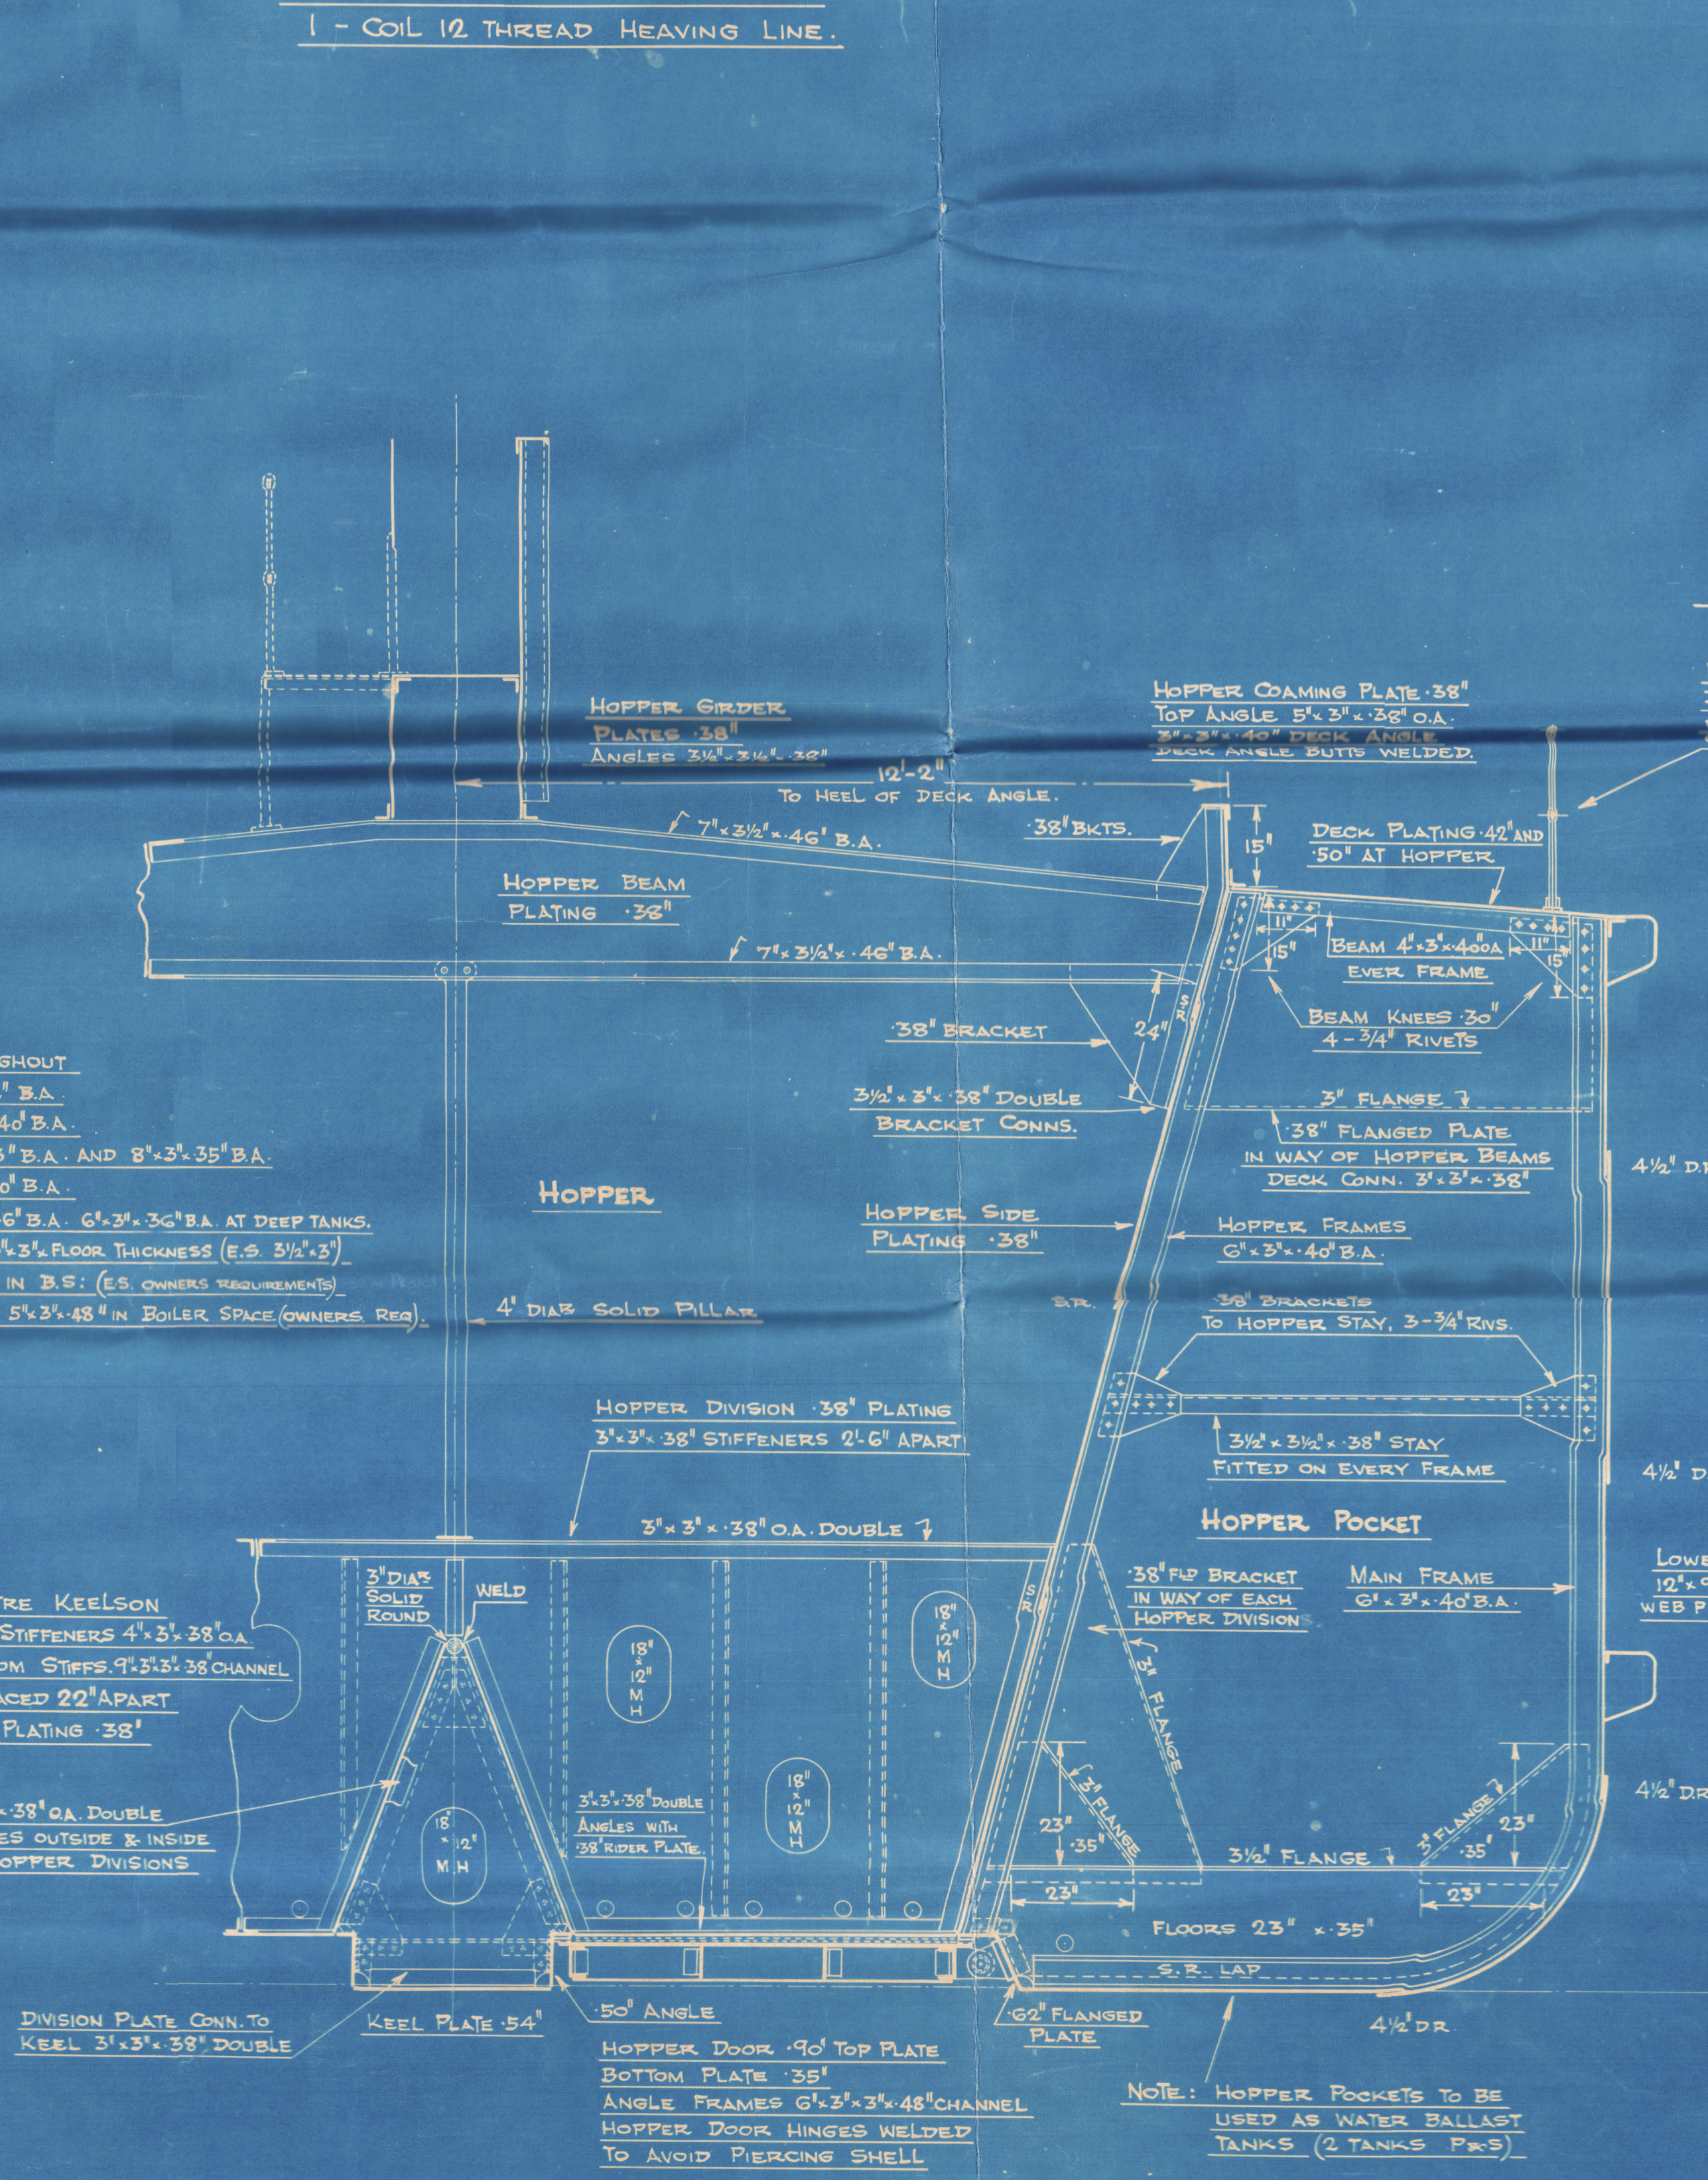

SECTION THRO' HOPPER.

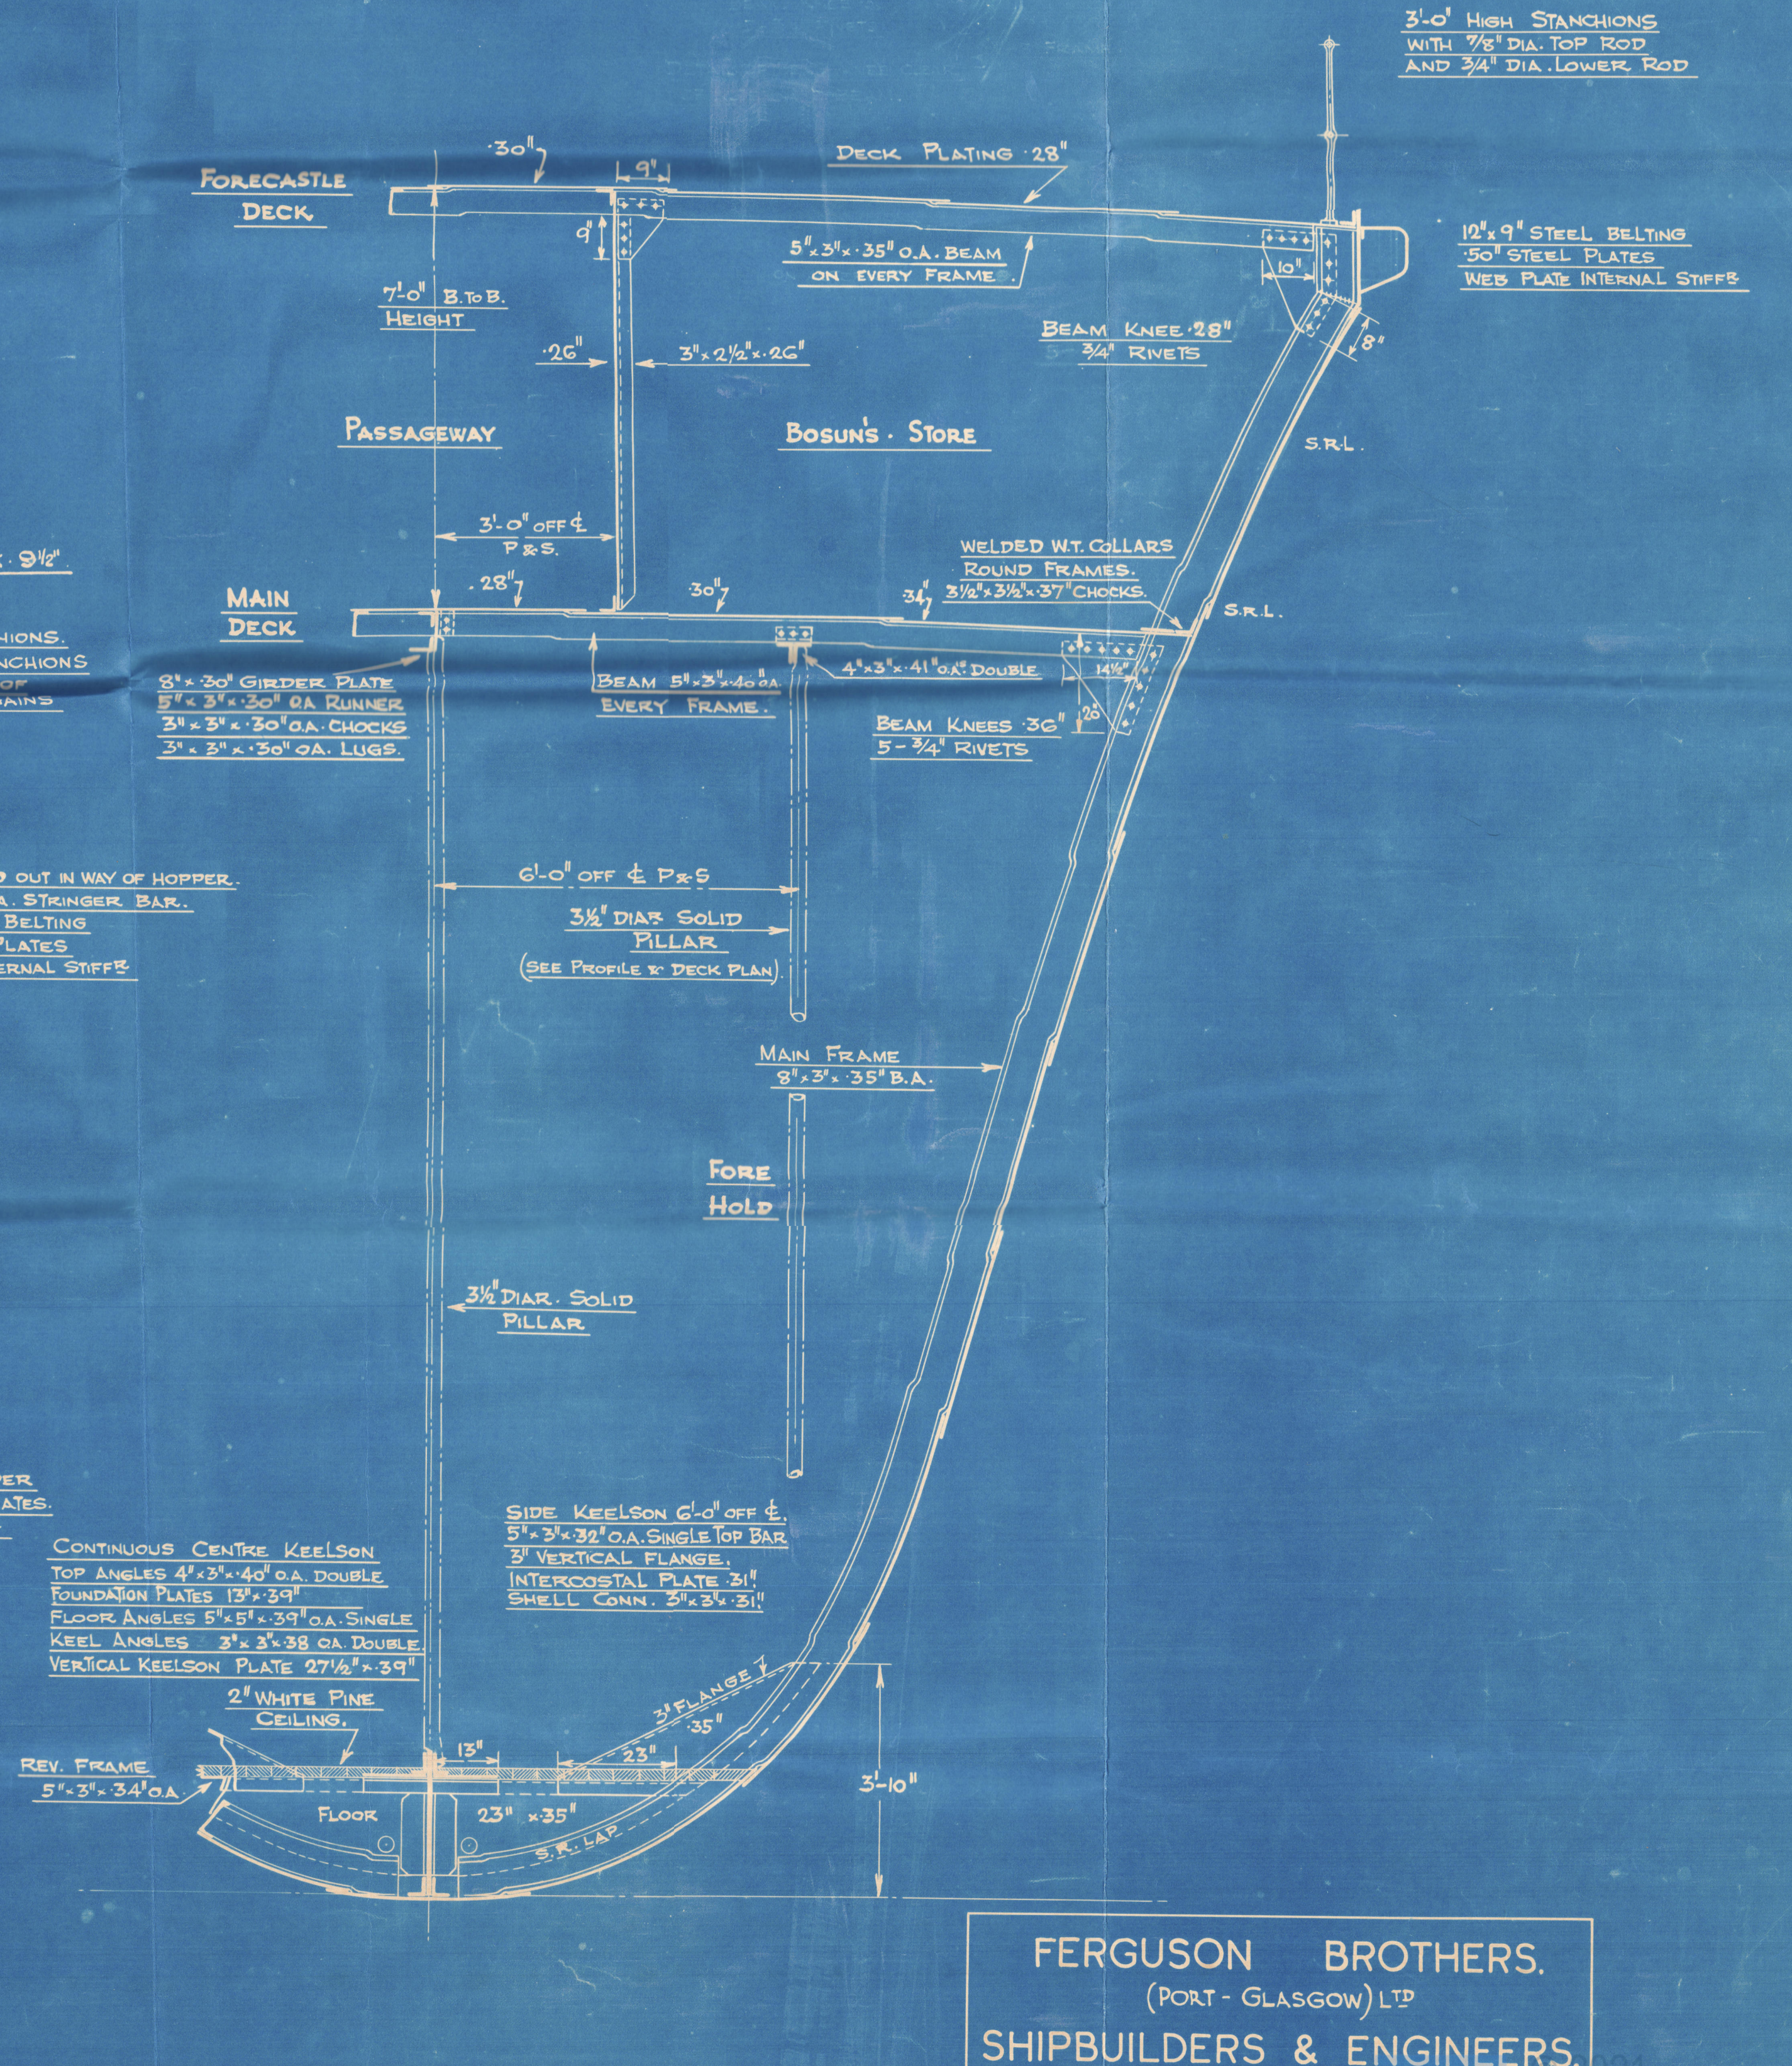

SECTION THRO' FORE HOLD.

FERGUSON BROTHERS.
(PORT - GLASGOW) LTD
SHIPBUILDERS & ENGINEERS.
DRAWN BY: [Signature] DATE: 5-12-49 CHECKED BY: [Signature]
DRAWING NO. 1 / 397

Ferguson Bros (P.G) Ltd

Land N° 397

J. P. WEBB *

Hull Sections

"as fitted"

Grunock & Co Report N° 24460

RECORDS DEPT.
LONDON

2

~~PLANS TRANSFERRED~~
~~TO SISTER VESSEL~~

~~1000-0801M~~
© 2021
LLOYD'S REGISTER
FOUNDATION