


# S.S. BUCKLEIGH.

## Midship Section.

### S.S. No 256 AS FITTED.

Scale 1/2" = 1 Foot.

POOP 37'25" BRIDGE 117'5" FORECASTLE 39'75"

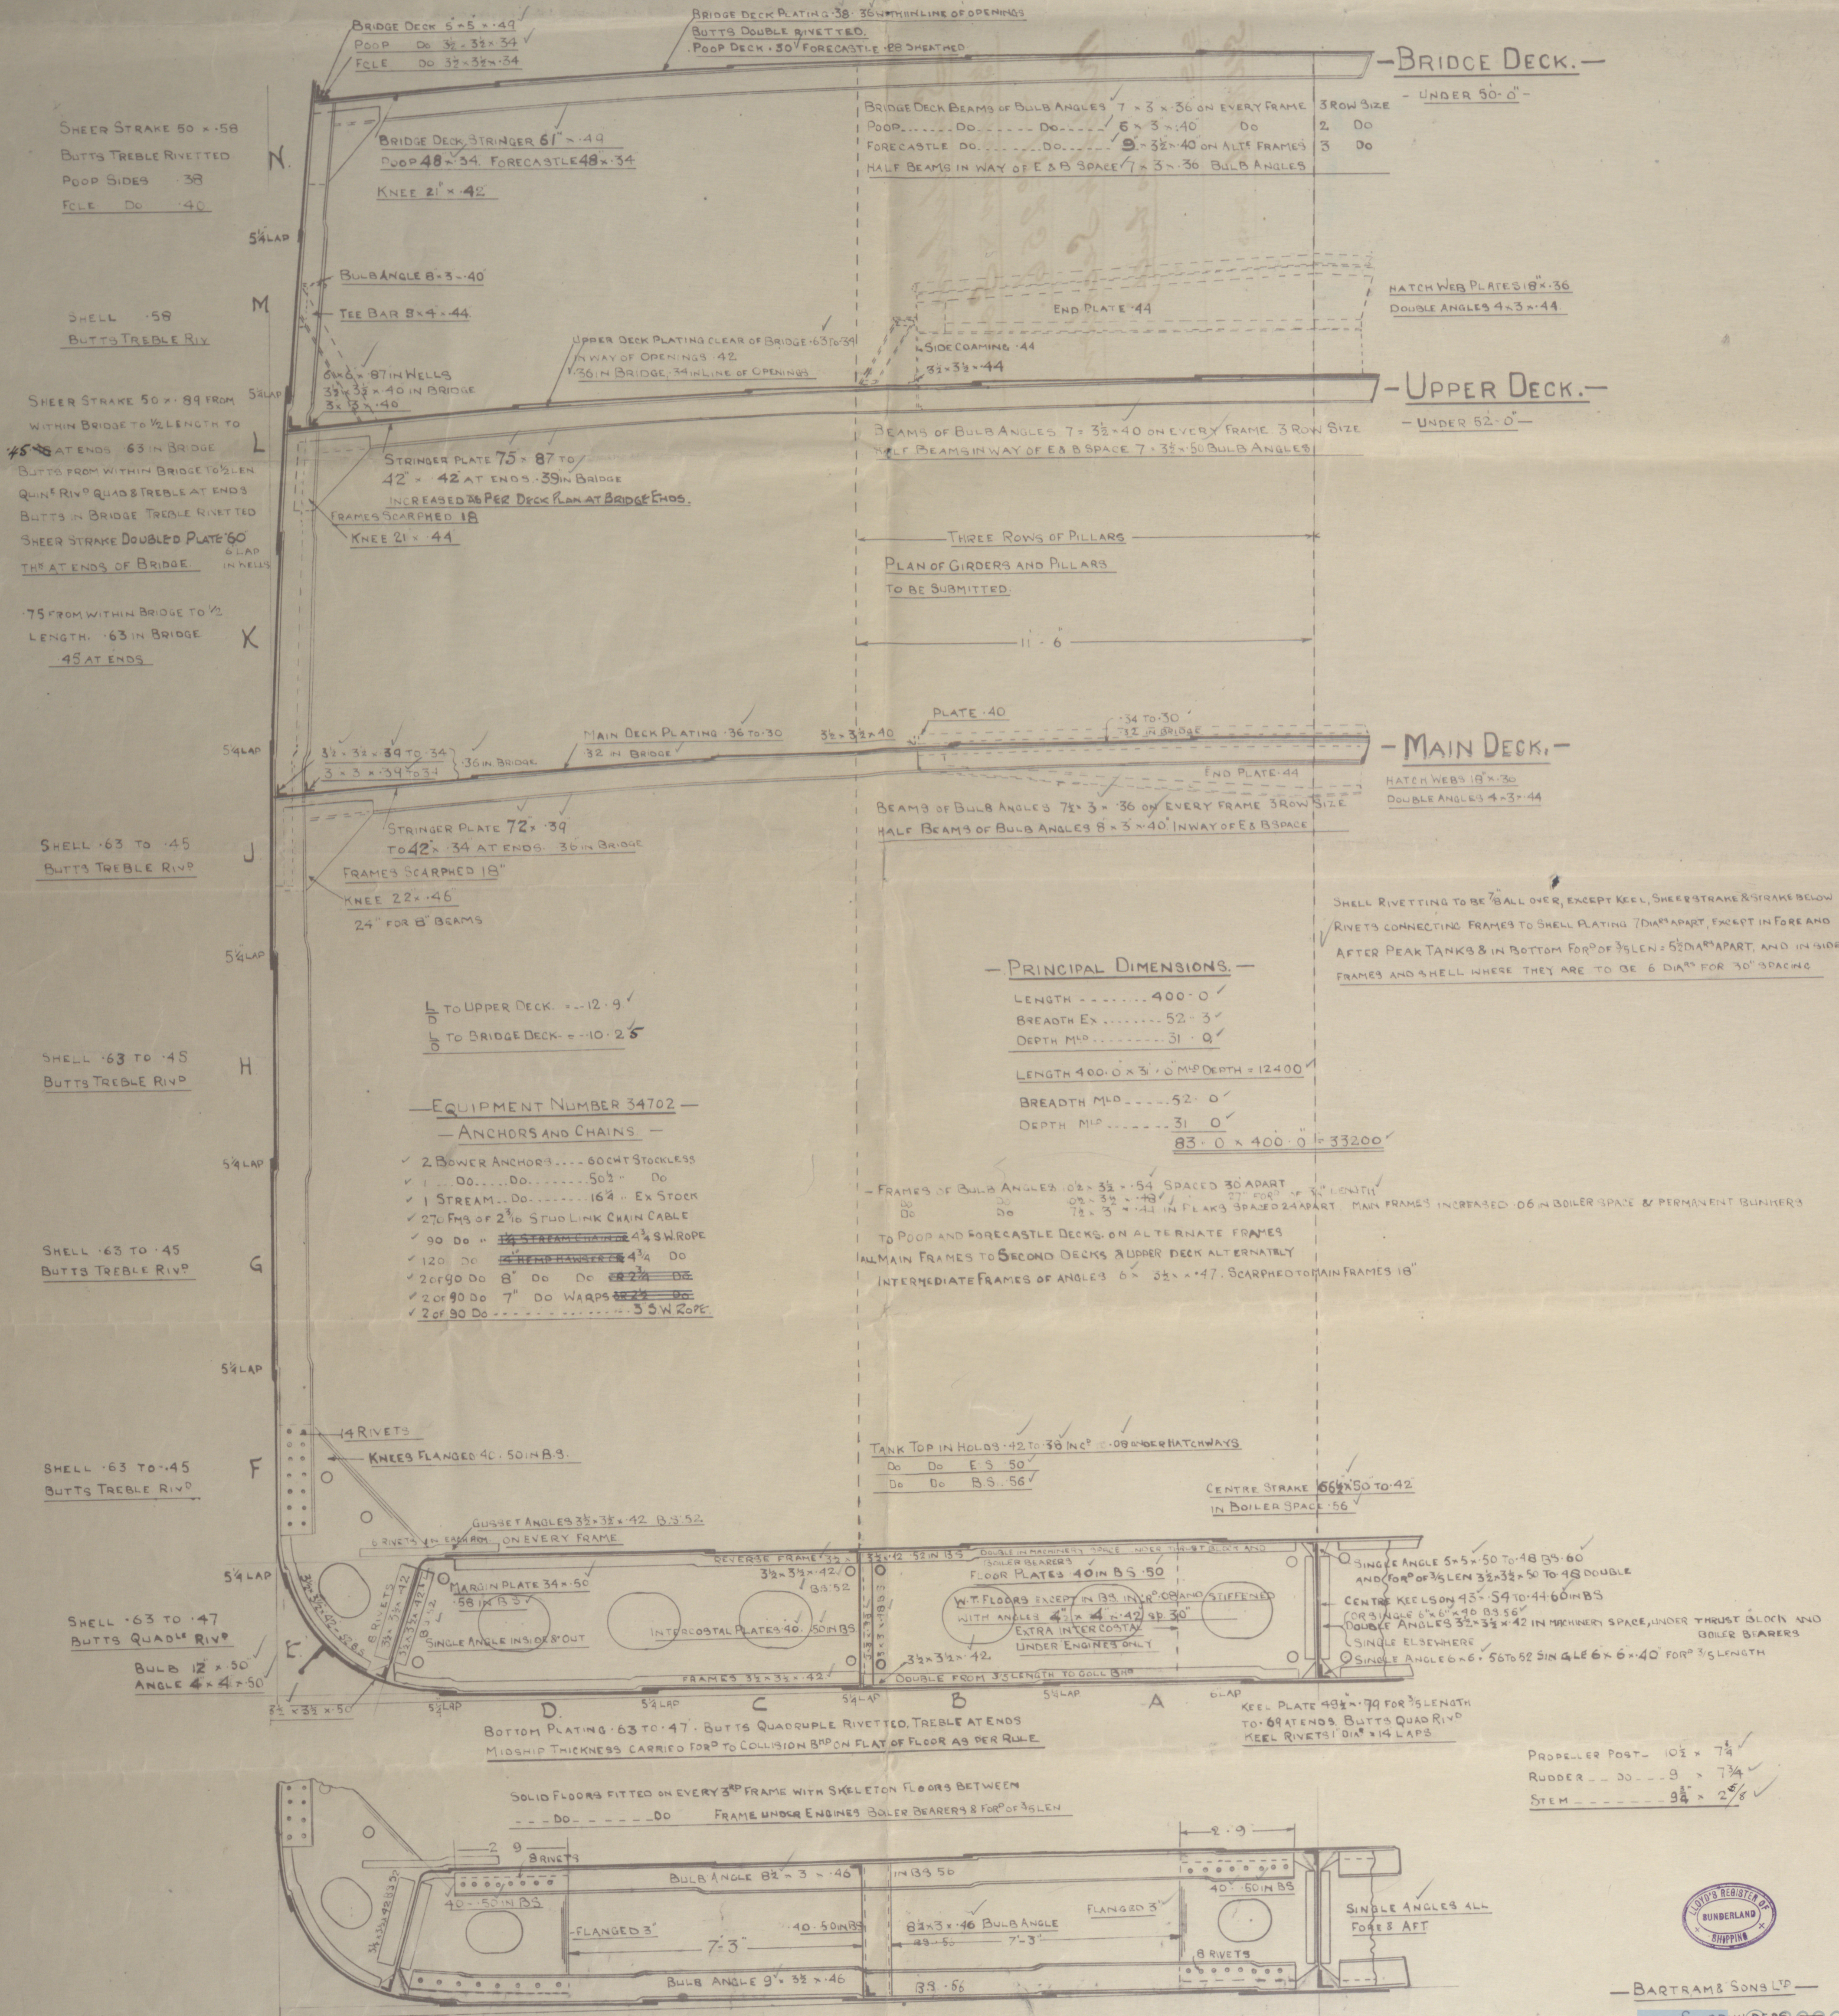

BARTRAM & SONS LTD



Sunderland.

Bartram & Sons.

- No 256 -

Midship Section.

(- as built)

S.S. "BUCKLEIGH".

Std Rpt No. 28983.

RETAIN

RETAIN



© 2020

Lloyd's Register  
Foundation

W1084-0103