


NO. 57
UPPER DECK PLAN
SCALE 1/4" = 1 FT.

NO. 57
UPPER DECK PLAN
SCALE 1/4" TO 1 FT.



MATSUO
DRAWING & ENGINE WORKS
NAGASAKI
DRAWN BY
CHECKED BY
DATE

Decks
N^o 57
as built
S.S. Loyo Mame N^o 2
Repl. N^o 1143
Nagasaki

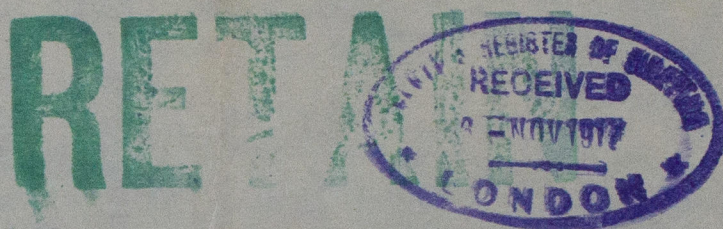

RETA



© 2020

W1096-0087 Register
Foundation