
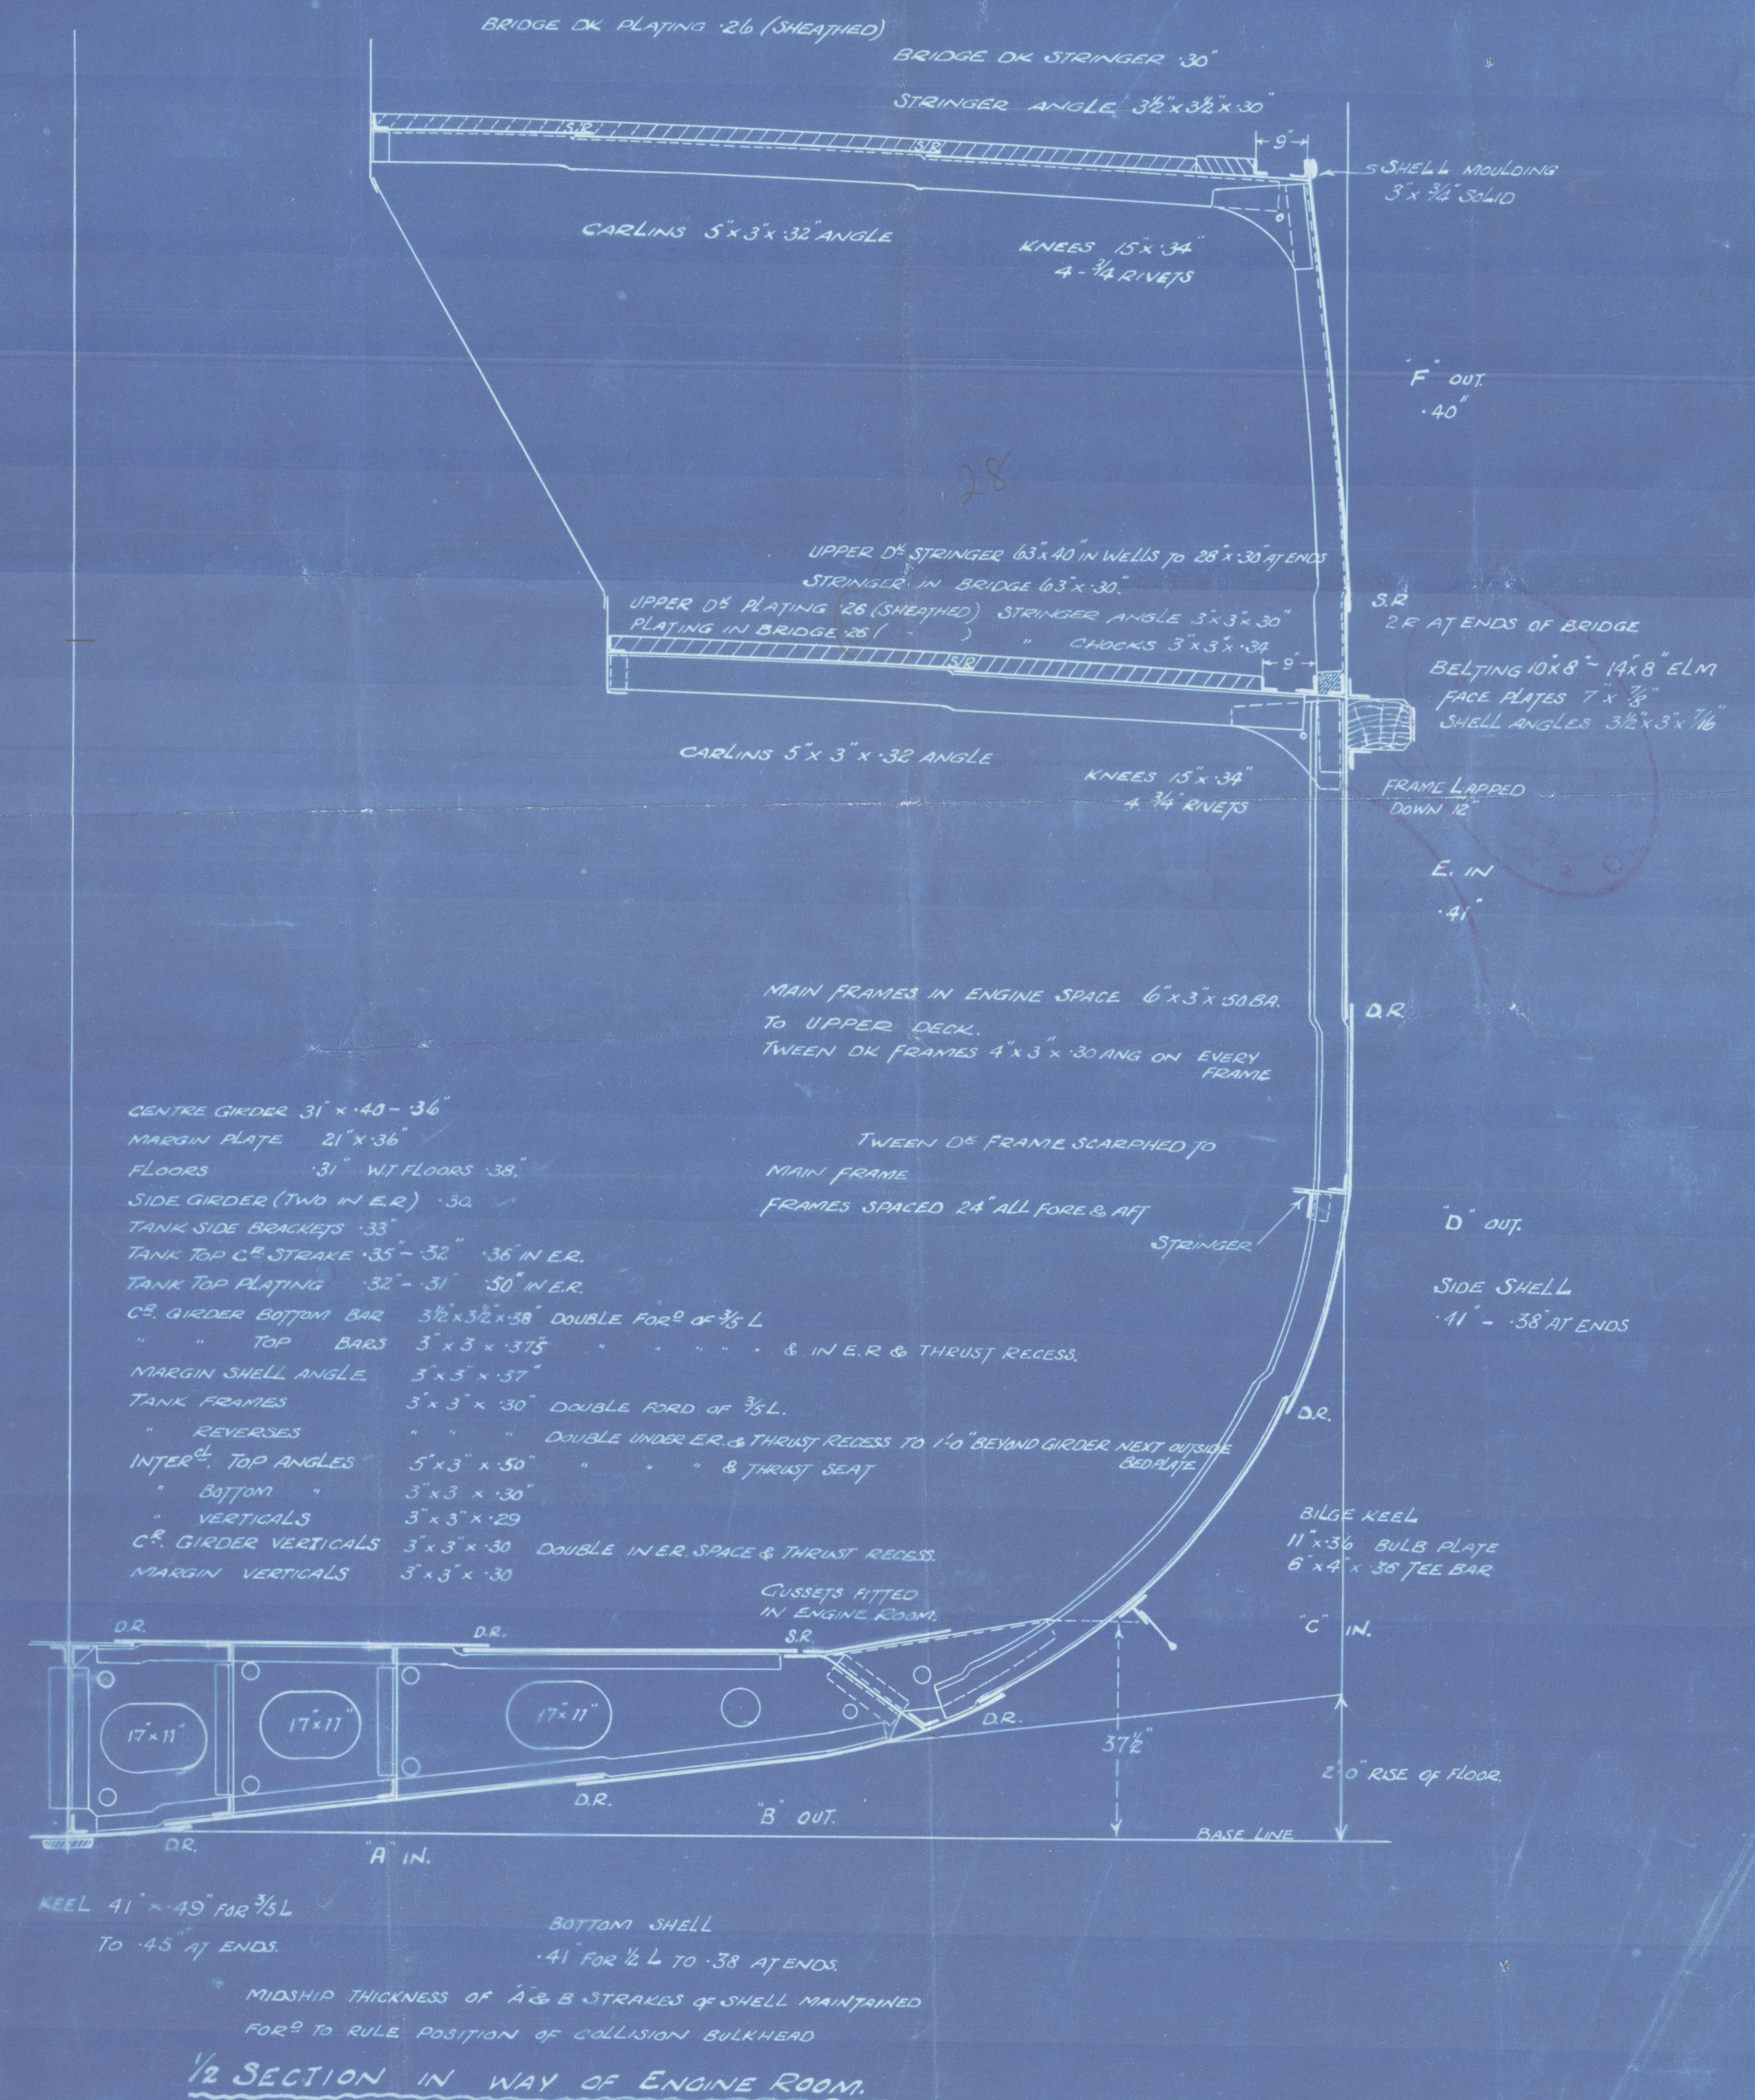
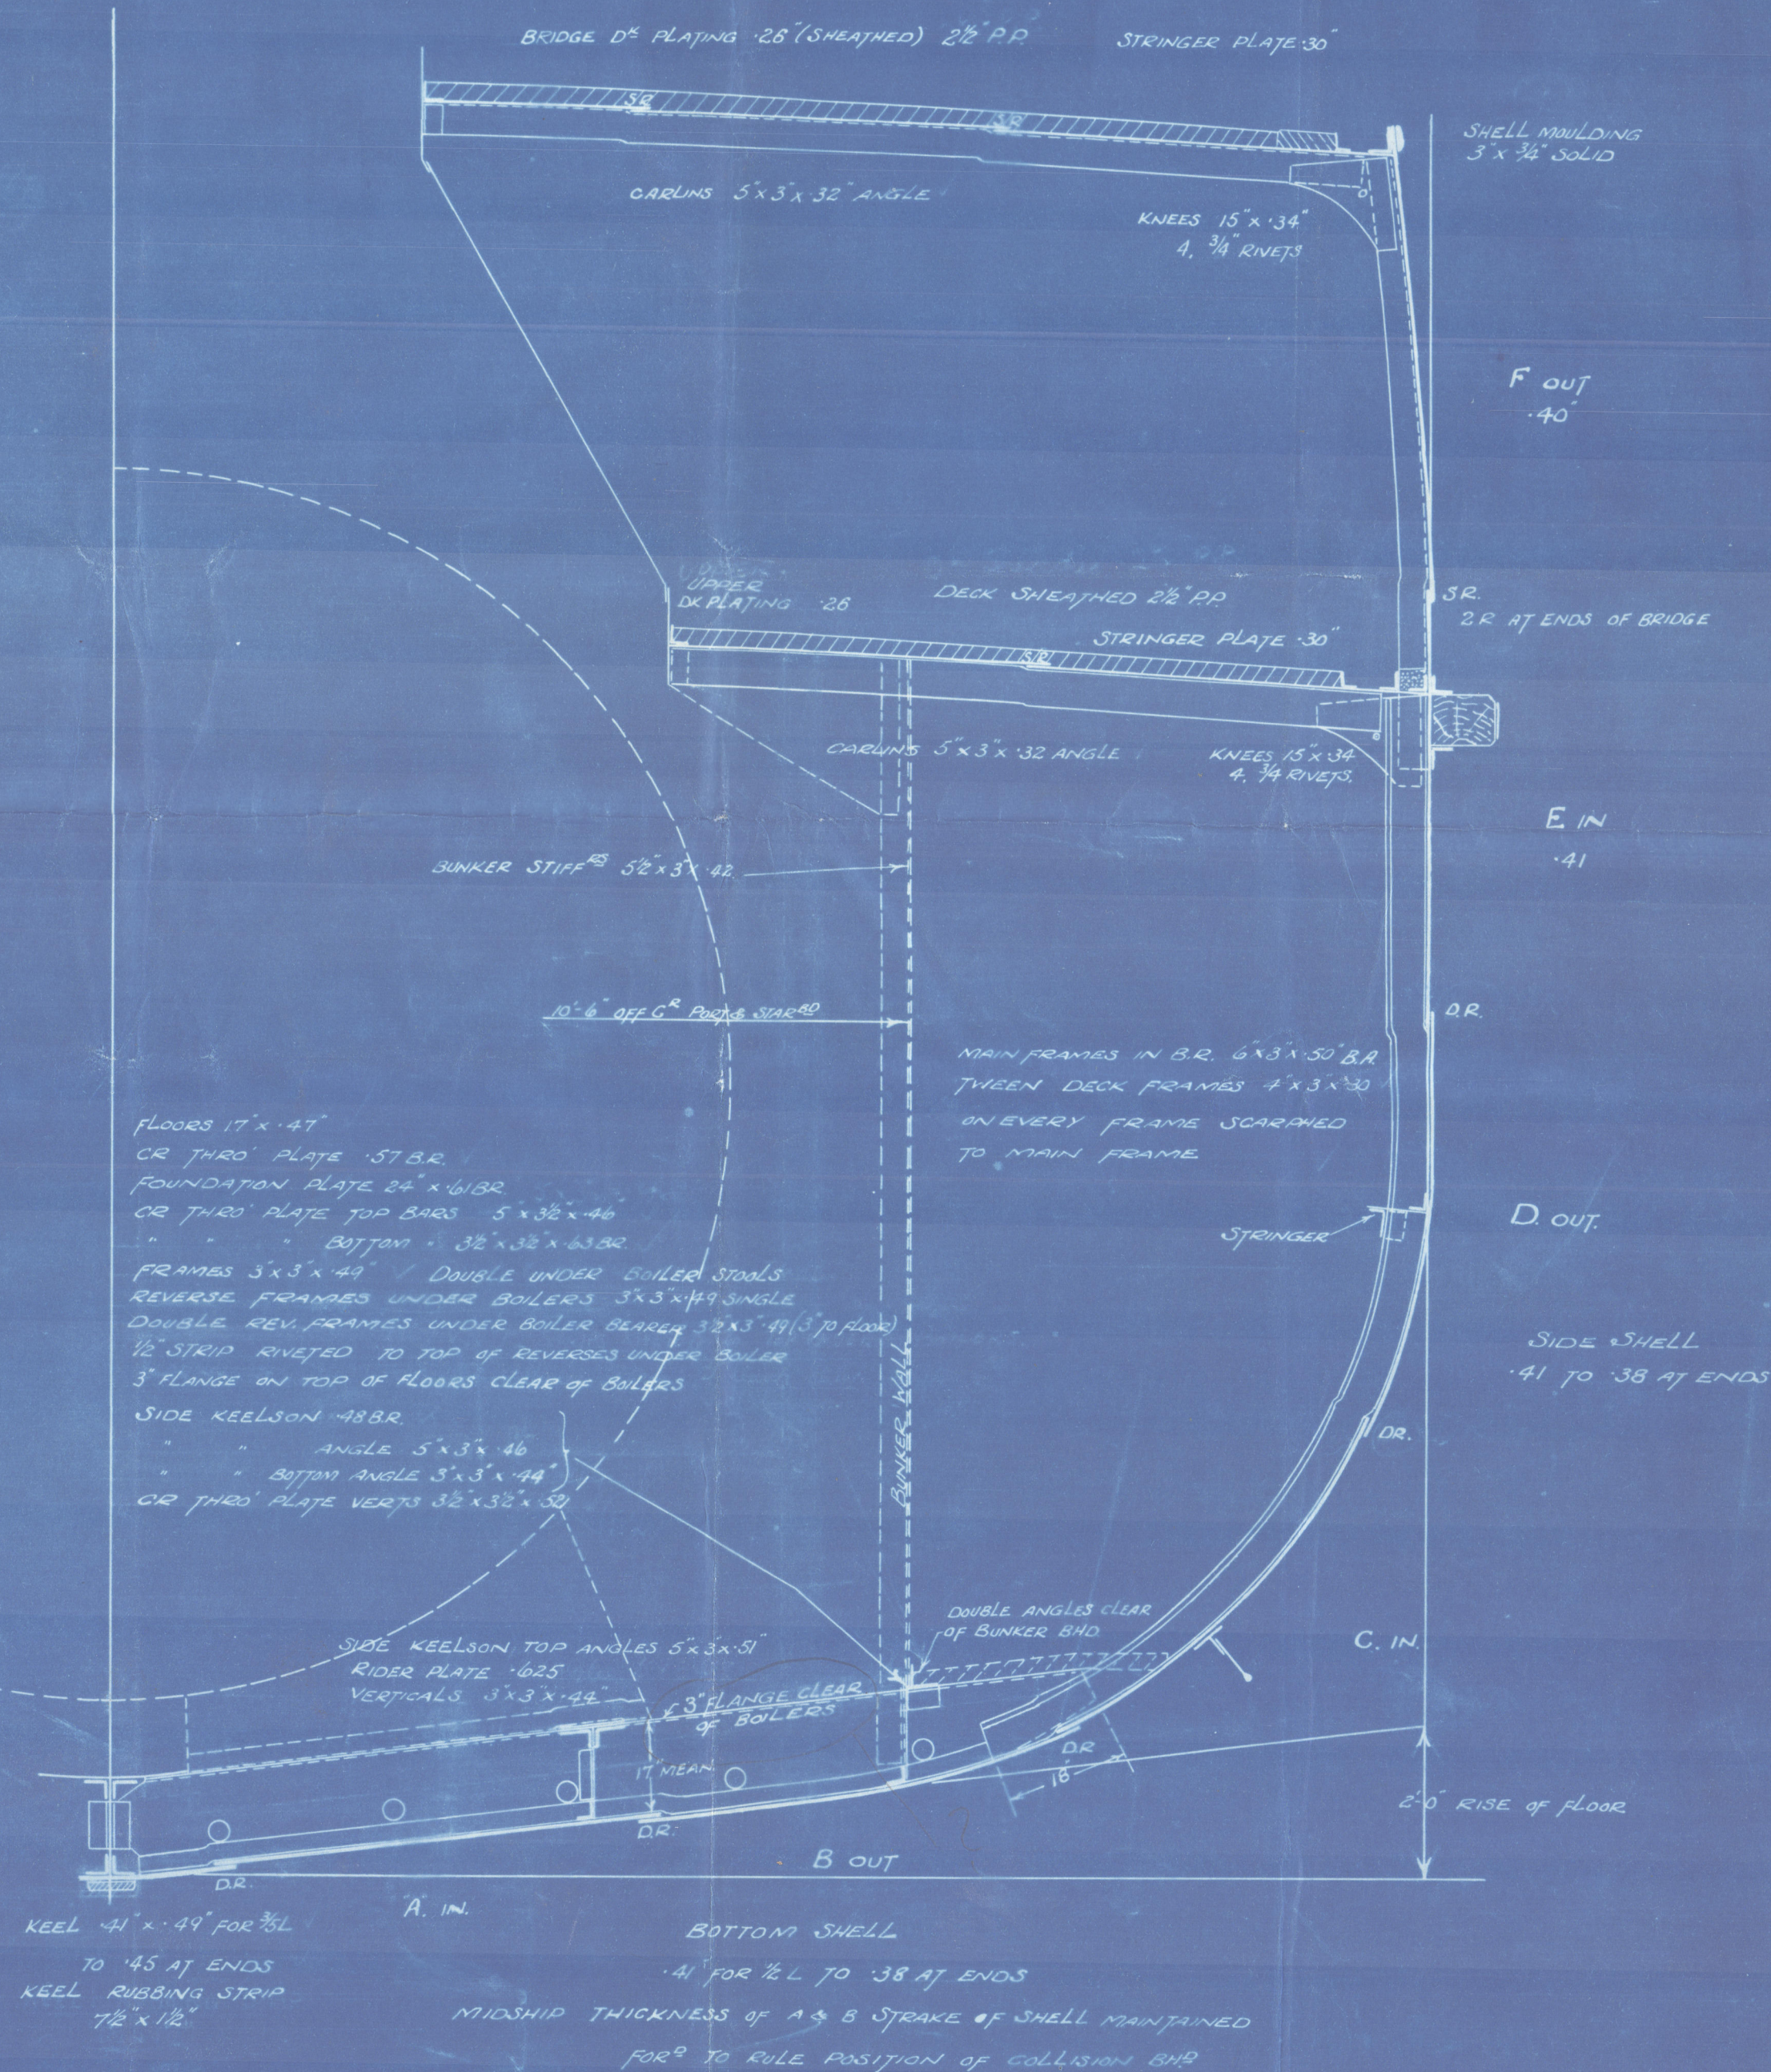


MIDSHIP SECTION

SS. DALRIADA

SCALE. $\frac{1}{2}$ " = ONE FOOT.

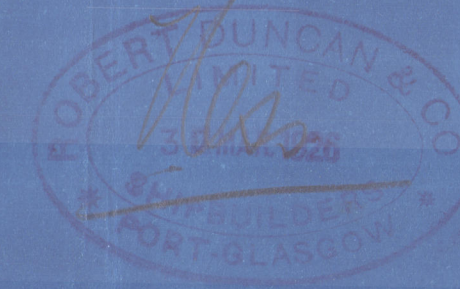

R. DUNCAN & Co

Nº 371

S. S. DALRIADA

MIDSHIP SECTION

As BUILT

RETAIN

Sub. Report L^d 18534.

RETAIN



© 2020

Lloyd's Register
Foundation

W1104-0363