

S.S. N° 194.

# PROFILE.

SCALE 1/8" = 1 FOOT.


AMENDED PLAN. (TN 11397).

CLOSED SHELTER DECK TYPE.

NOTE BA FRAMES CARRIED TO SHELTER  
DECK SHOWN THUS: \*

DIMENSIONS.

LENGTH O.P.	370'-0"
BREADTH M.L.	51'-1"
DEPTH M.L. TO UPPER DECK	26'-3"
" " SHELTER DECK	34'-9"

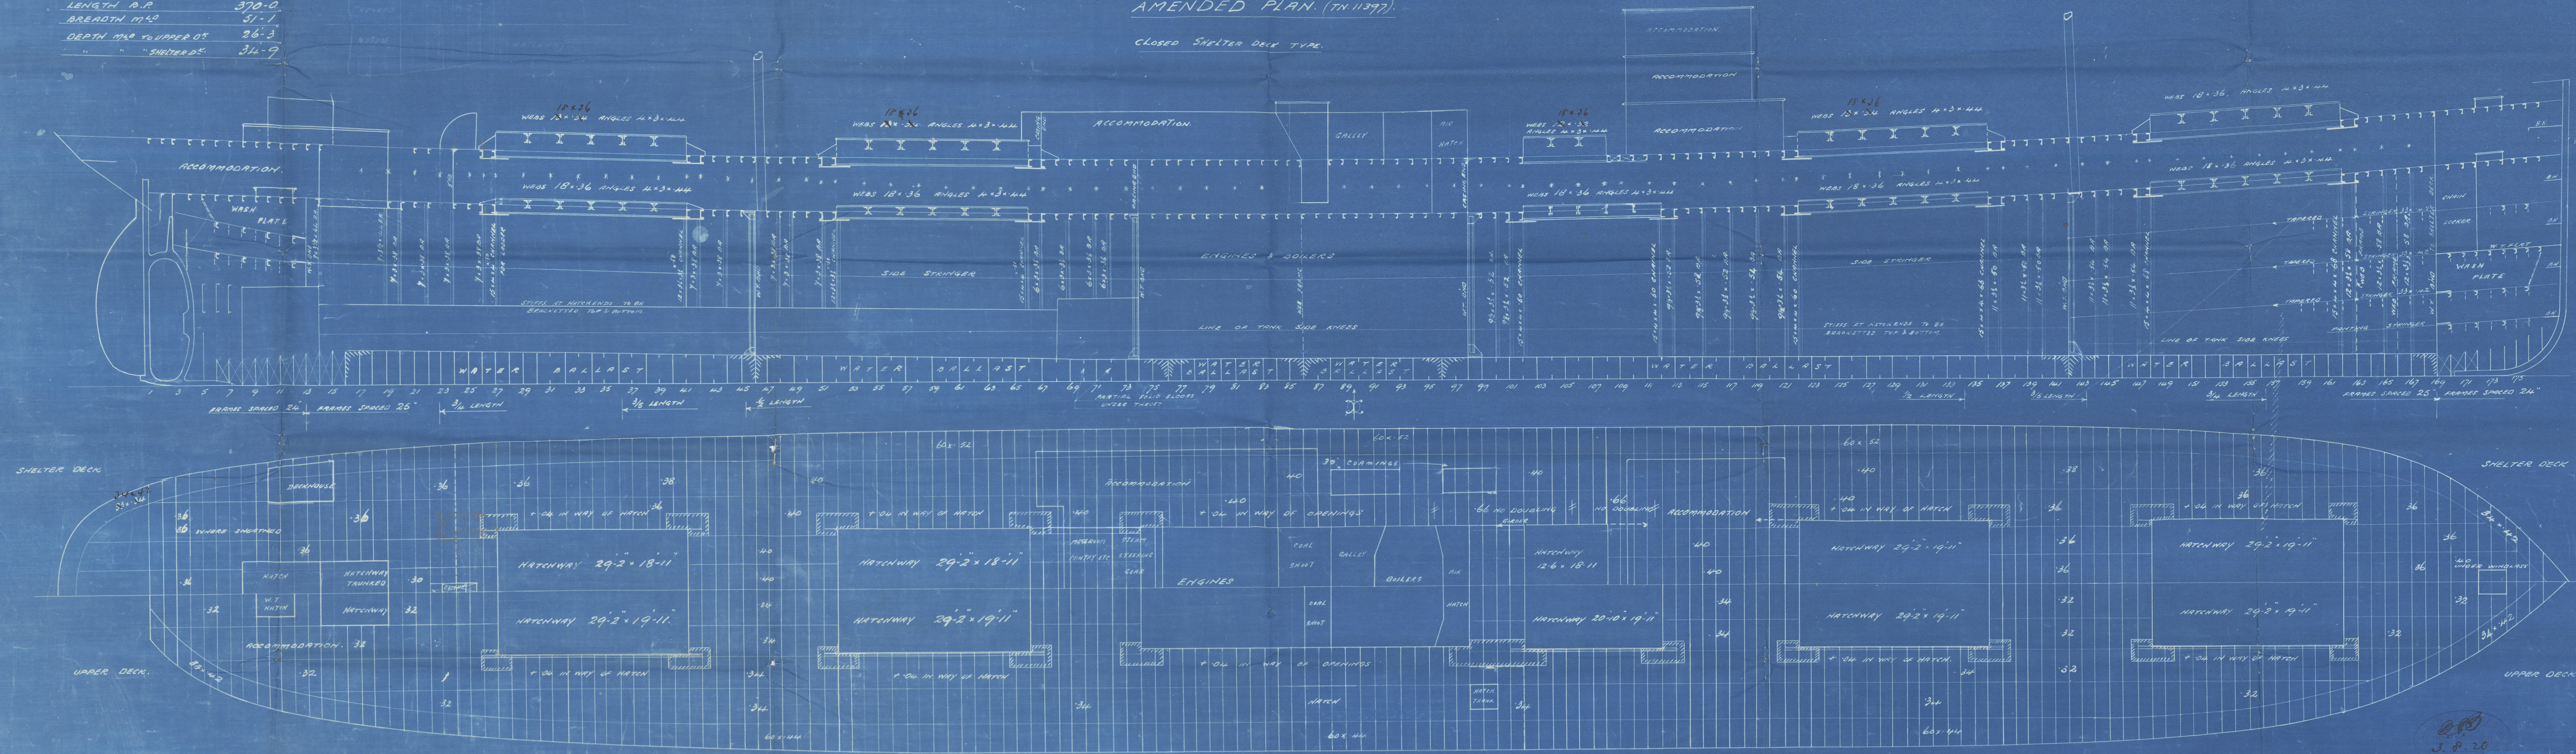



Pres. to Craig Taylor Dec 1  
no 194

Profile & Deck  
as built

Ind report no 10727

sp. Evros.

n. n. " Zannis L.  
Cambanis

W134-0172




© 2020

Lloyd's Register  
Foundation

Profile 194



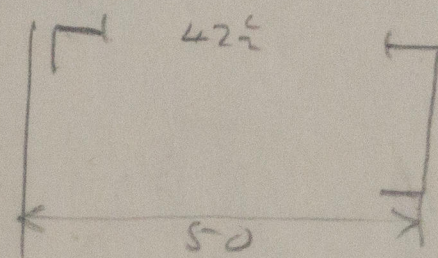

© 2020

Lloyd's Register  
Foundation