


S. S. No 350-1

# MIDSHIP SECTION

LENGTH ON L.W.L. 312' 0" x 46' 11" x 23' 4 3/4" MLD

To CLASS 100 A.1. AT LLOYDS FULL SCANTLING VESSEL

SCALE 1/2" = 1 FOOT

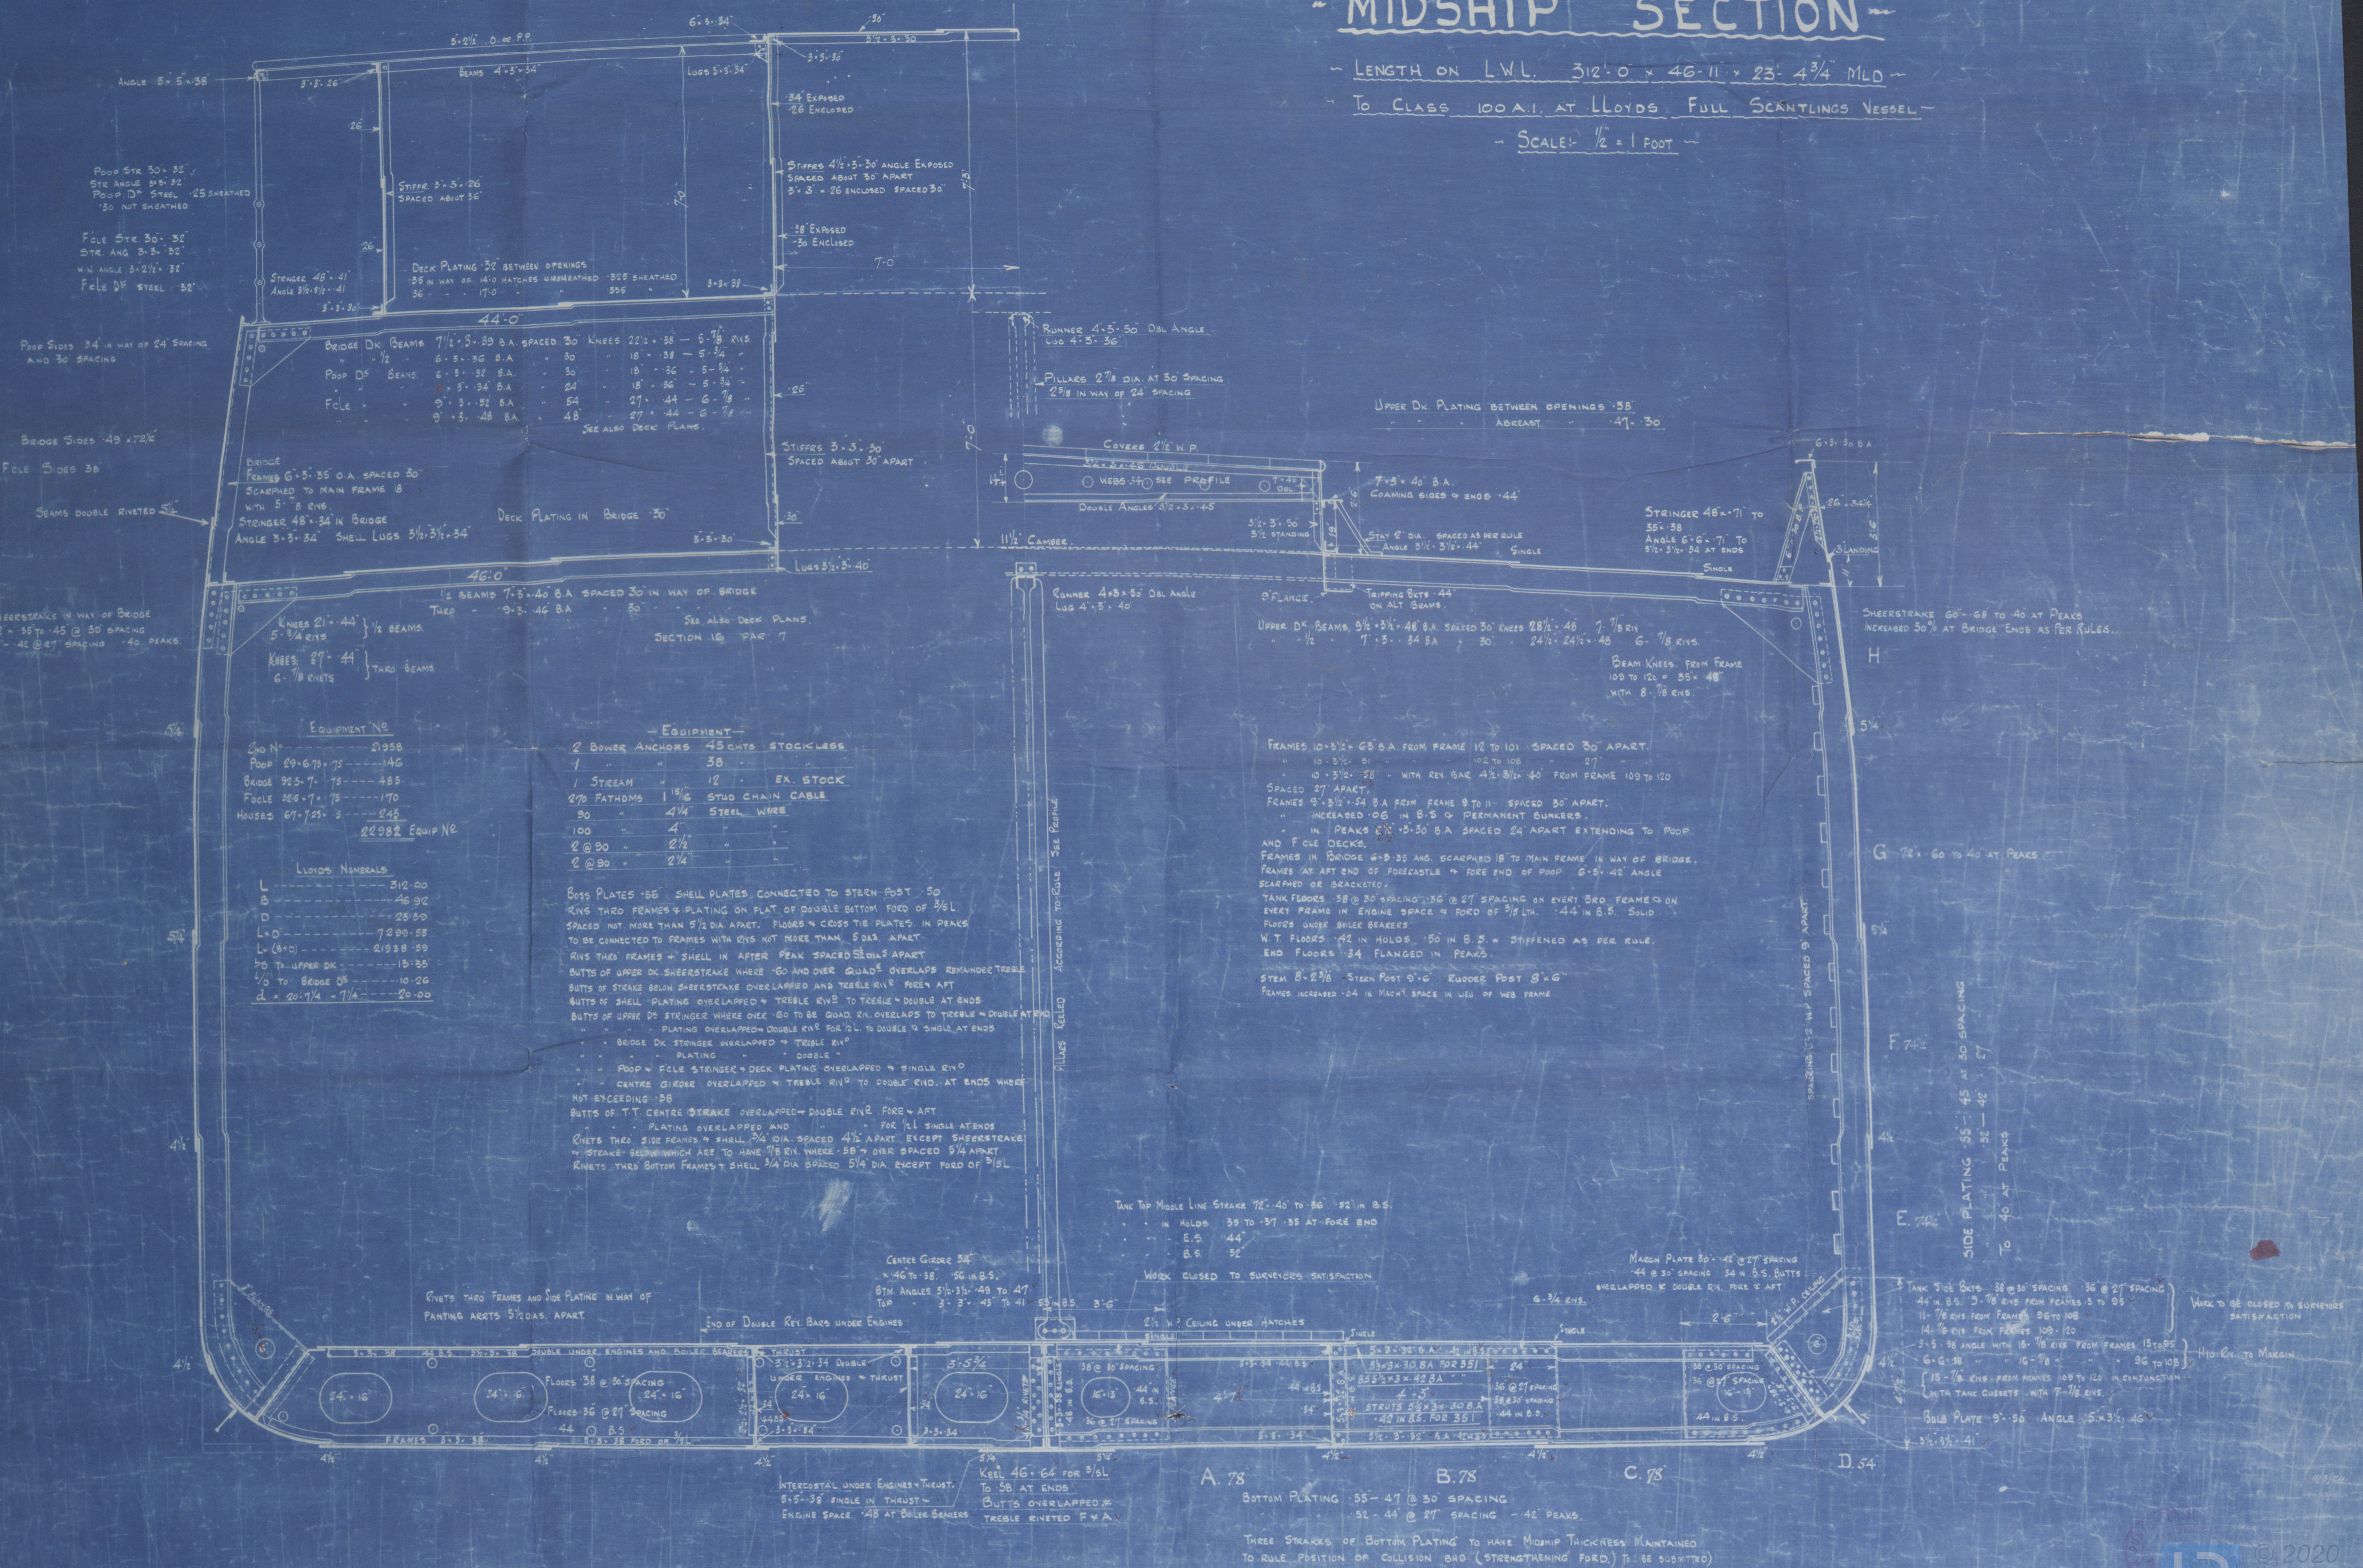



Dunlop Bremner & Co.

N<sup>o</sup> 350.

S. S "QUERCUS"

Midship Section  
(as built)

TWEED

Grk Rep <sup>h<sup>e</sup></sup> 18539.



W1139 - 0062

Lloyd's Register  
Foundation