


JAMES WATSON & CO. LTD.
 SHIPPERS
 19 MAR 1935
 GLEN SHIPBUILDING YARD
 PORT-GLASSGOW

DIMENSIONS: 390'-0" B.D. x 53'-0" EXT. x 35'-2 1/2" (MLD. TO SHELTER DECK.)

CLASS 100 A.1. WITH FREEBOARD CORRESPONDING TO
THAT OF A COMPLETE SUPERSTRUCTURE VESSEL
WITH TONNAGE OPENING,
LLOYD'S SURVEY.

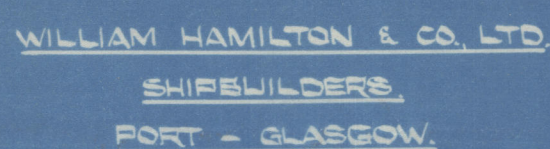

S. S. DARCOLM

WM HAMILTON & Co

Nº 409

MIDSHIP SECTION

As BUILT.

GREENOCK 1ST ENTRY

REPORT Nº 19930

Medaklon

W1146-0049



© 2020

Lloyd's Register
Foundation