

S.S. N^o 61. 1907

MIDSHIP SECTION.

DIMENSIONS:- LENGTH B.P. 245'-0". BREADTH MLD. 38'-6". DEPTH MLD. 17'-6" UPPER DK.
21'-9" R.Q. DK.

SCALE 1/2" = 1 FOOT.

TO CLASS 100.A. LLOYD'S.
EQUIPMENT AS PER RULES.

LLOYD'S NUMERALS.

D = 17.50

FIRST LONGITUDINAL N^o

L x D = 4288.

SECOND LONGITUDINAL N^o

L x (B+D) = 13720.


L/D (UPPER DK) = 14.00

" (RAISED QR DK) = 11.26


" (UPPER DK) = 14.3

" (RAISED QR DK) = 18.55.

RUDDER POST 6" x 5 1/4"
PROPELLER POST 6 3/4" x 5 1/4"
STEM BAR 7" x 1 7/8"

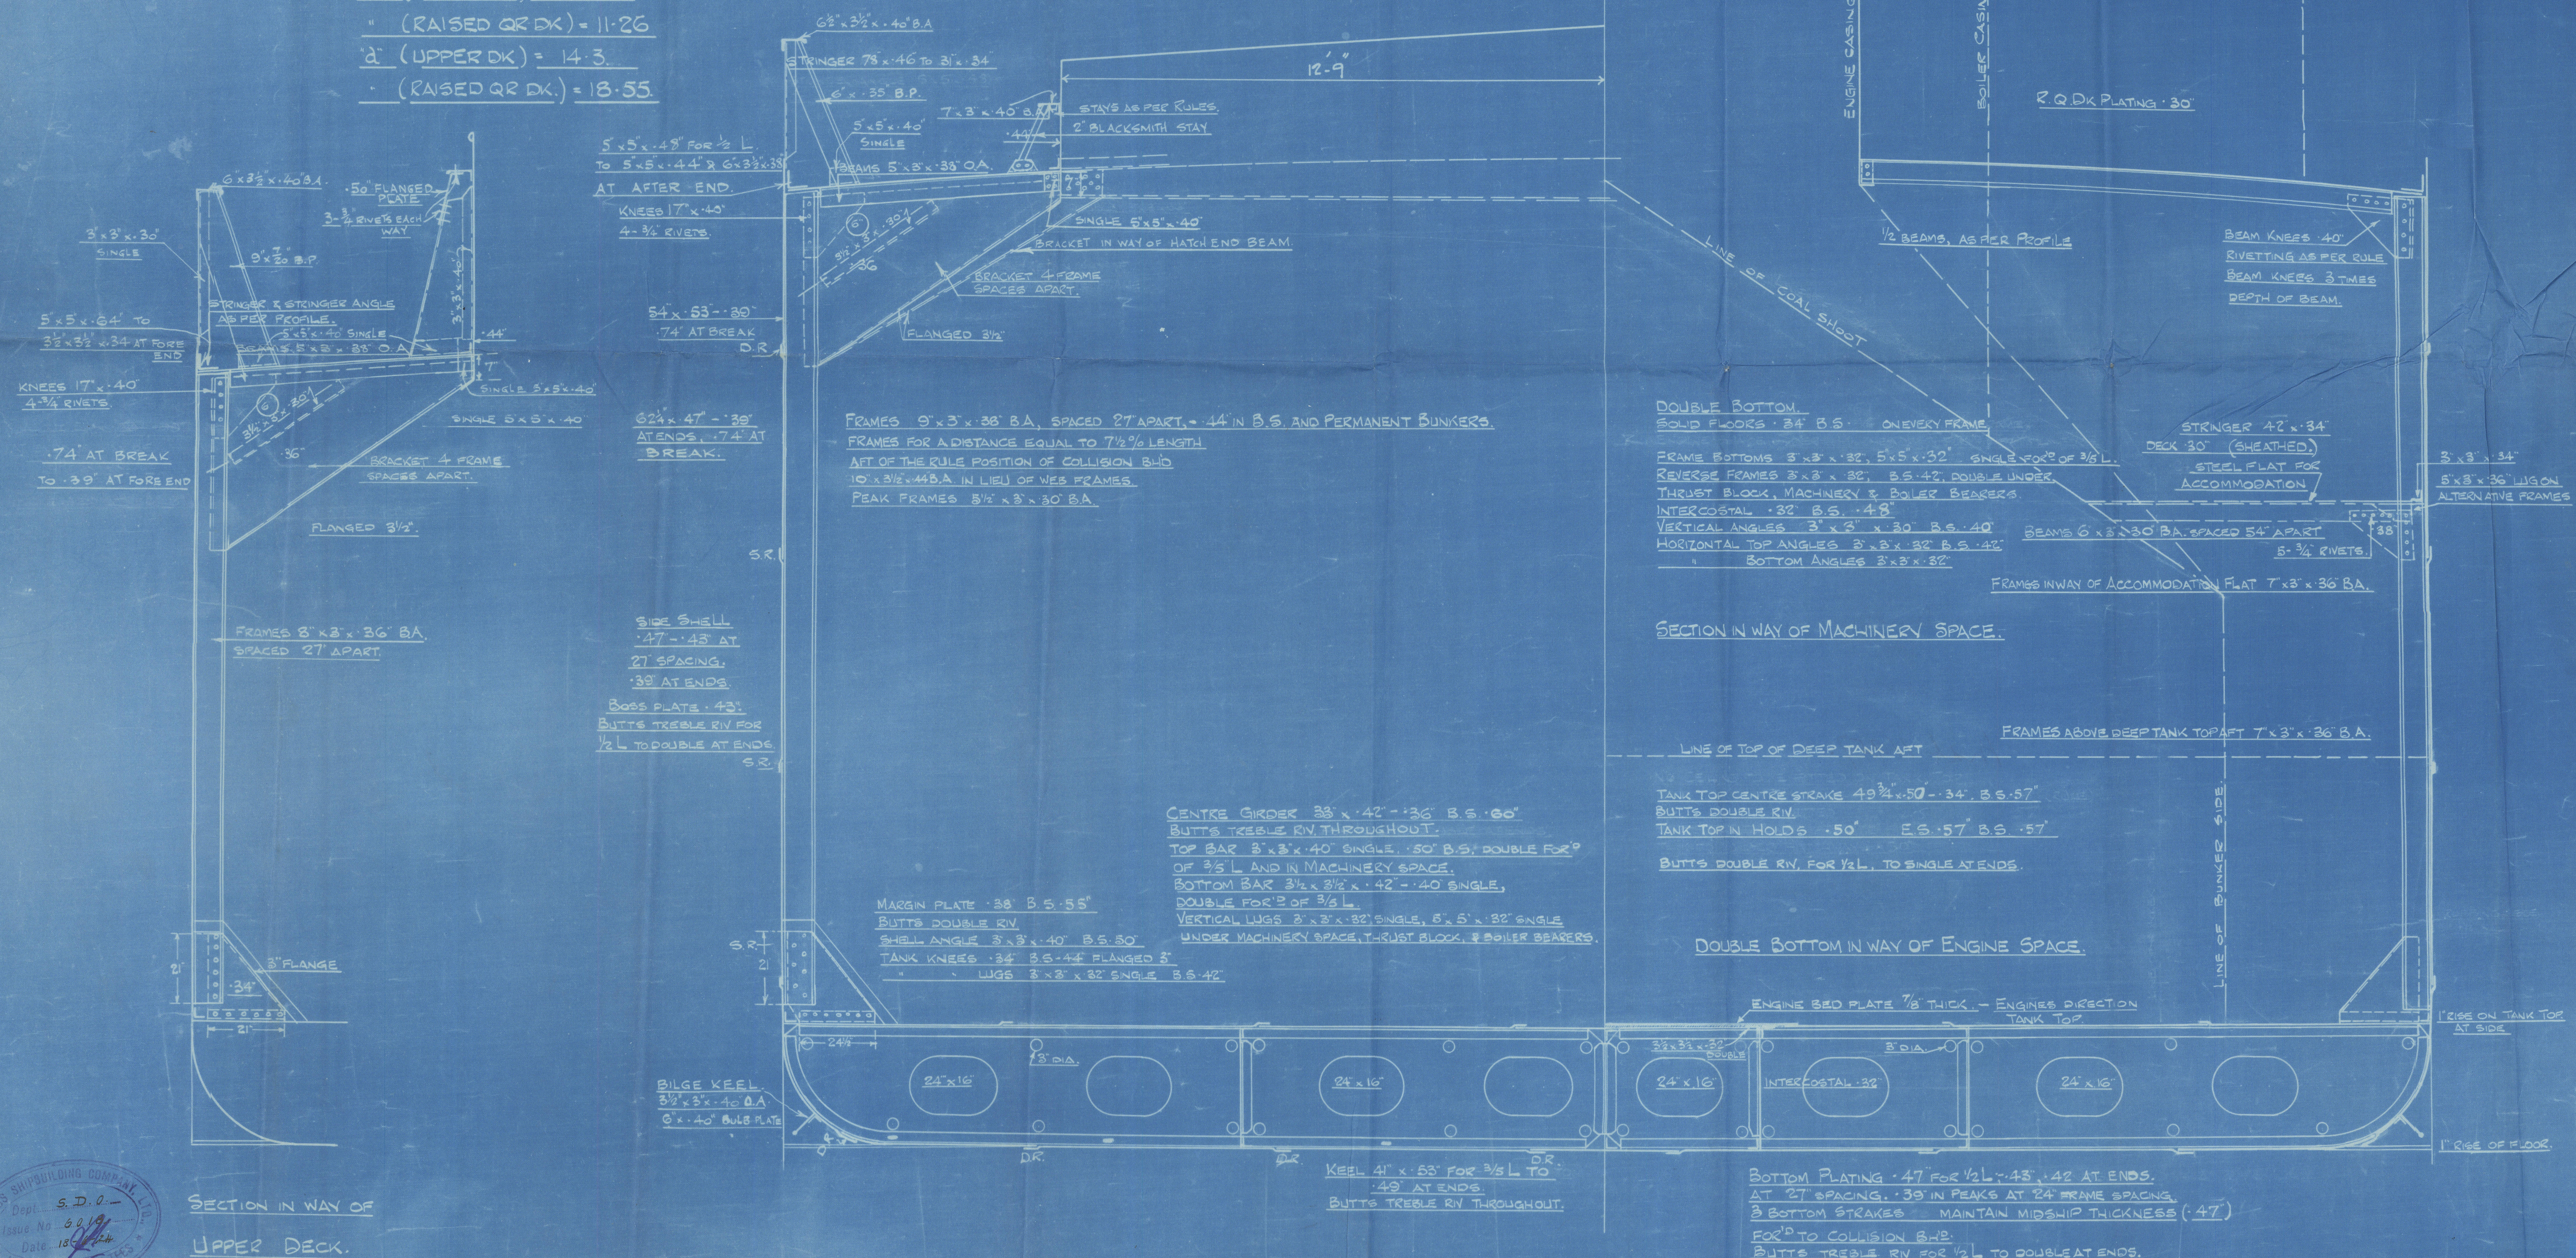

EQUIPMENT			
NUMERAL			
RAISED QUARTER DECK 195' x 4 1/2'	13720		
FORECASTLE 25 1/4' x 7 1/2' x 3 1/4'	133		
DECKHOUSE 45' x 7' x 1/2'	157		
	14807		
1 BOWER ANCHOR (Stockless)	30	1. 20	50
" " " " "	"	"	"
" " " " "	"	"	"
" " " " "	"	"	"
1 STREAM " (EX. STOCK)	26	1. 21	30
240 FATHOMS 1 1/2" STUD CHAIN CABLE	320	3. 22	319 1/2
75 " 3/4" STEEL WIRE (STREAM)	"	"	"
20 " 3/4" " " (TOWLINE)	"	"	"
2 @ 20 " 2 1/2" " " (CHAMBER)	"	"	"
2 @ 20 " 2 1/2" " " (WARP)	"	"	"

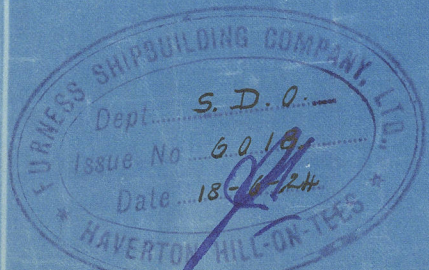

Jurmen Ship 6th No 1

Midship Section

as Built

S.S. Doystron.

Draw 11957.

REMA



© 2021

Lloyd's Register
Foundation