


S.S. N° 61. PROFILE & DECK PLANS.

DIMENSIONS. LENGTH B.P. 245'-0". BREADTH MLD 38'-6". DEPTH MLD 17'-6" UPPER DK.
 21'-9" R.O. DK.

SCALE $\frac{1}{8}" = 1 \text{ FOOT}$

TO CLASS 100 A 1 LLOYDS.

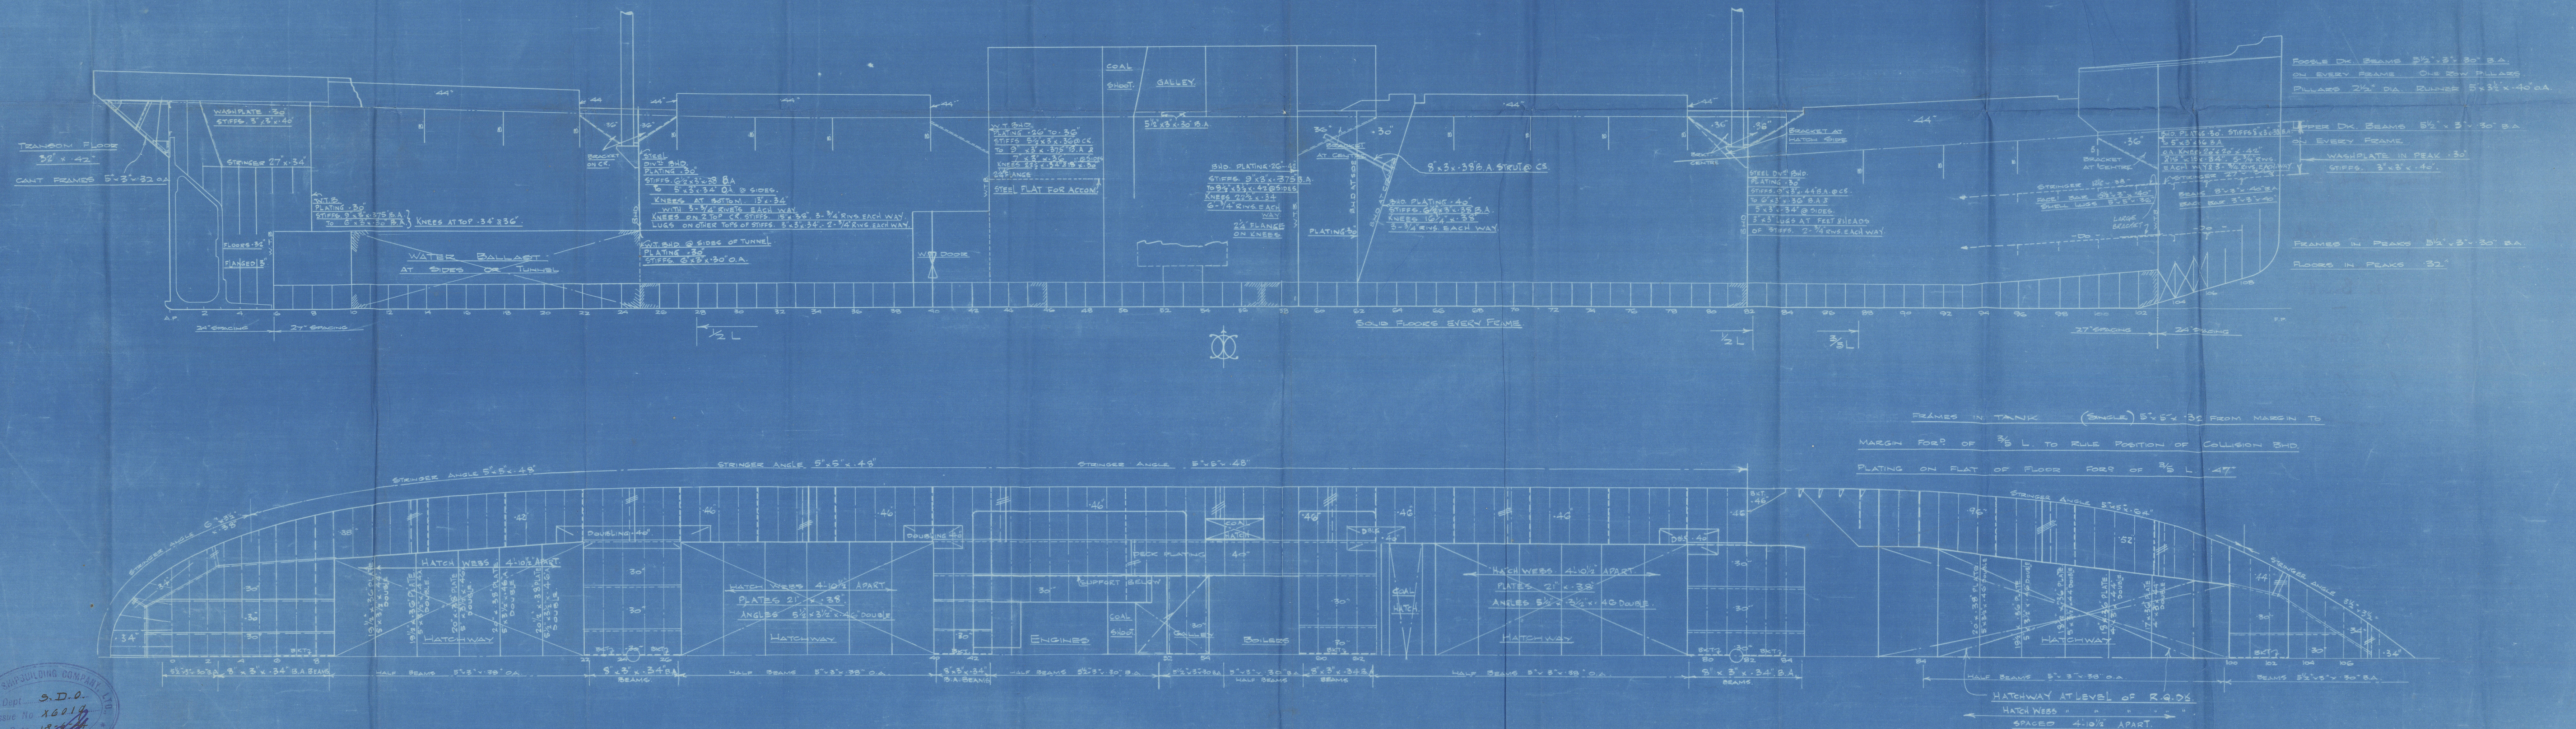

SHIPPING COMPANY LTD.
 Dept. S.D.O.
 Issue No. 10019
 Date 10/1/1919
 HAVERTON

W1150-0271


Inness Ship Bay No. 61

Profile & Deck plans

as Built

S.S. Dogston.

Knab 11957.

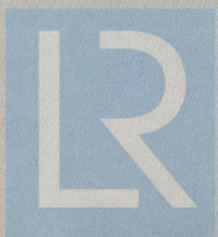

© 2021

Lloyd's Register
Foundation