




BITS AT NO 7 HATCH END

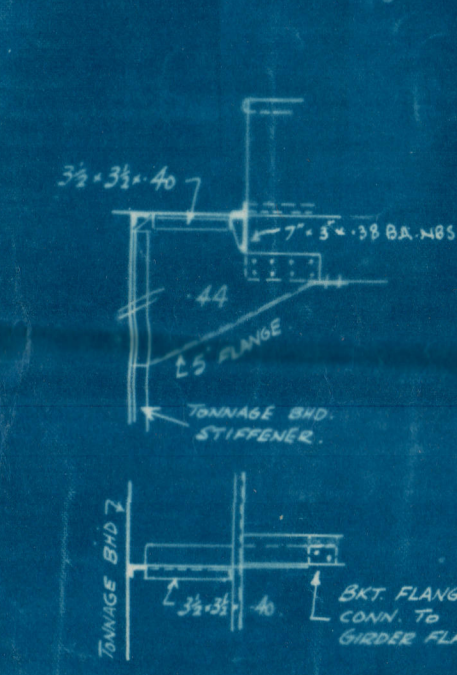



HATCH CORNER DIAMONDS  
UPPER DECK

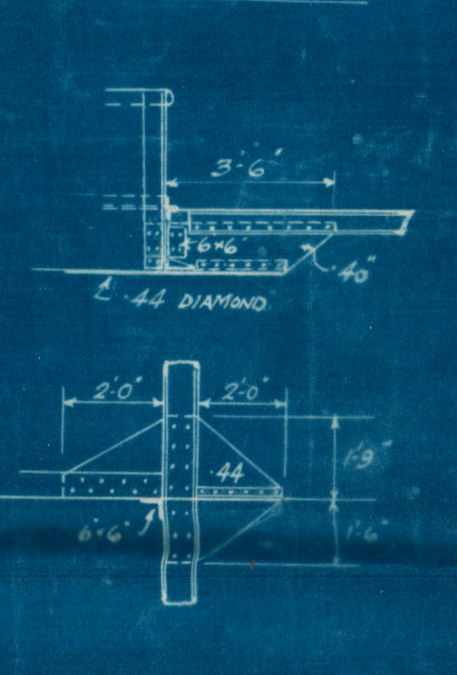

SECTION SHOWING CONV. OF E BND  
STIFFS TO TUNNEL TOP & HATCH END

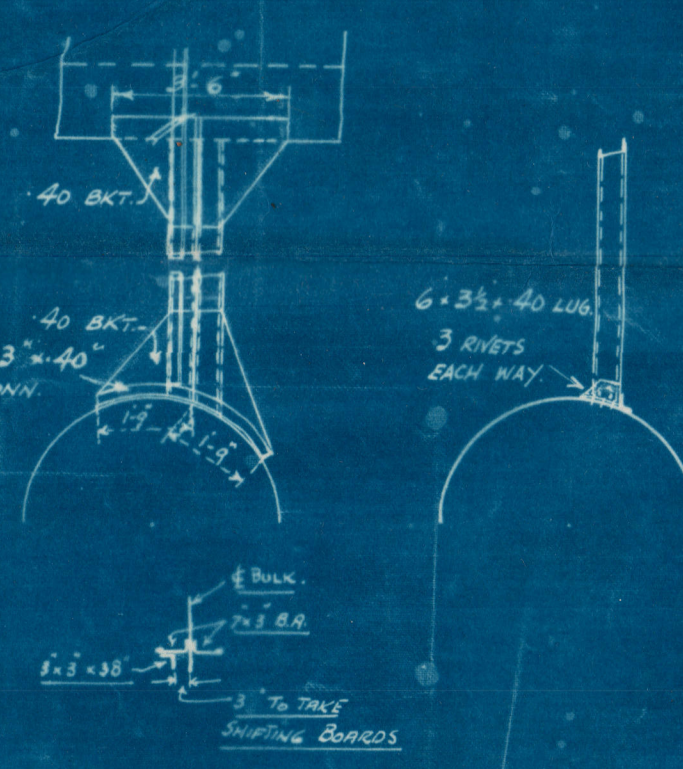



HATCH CORNER DIAMOND PLATES  
FRAMES 49-52, 96-99 & 101-12  
UPPER DECK

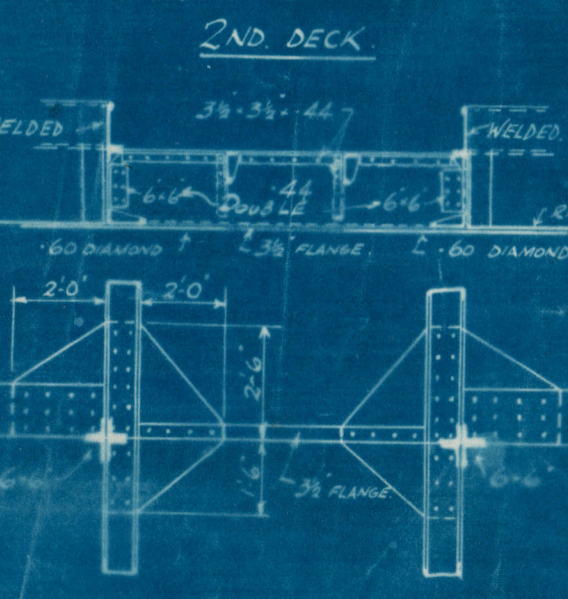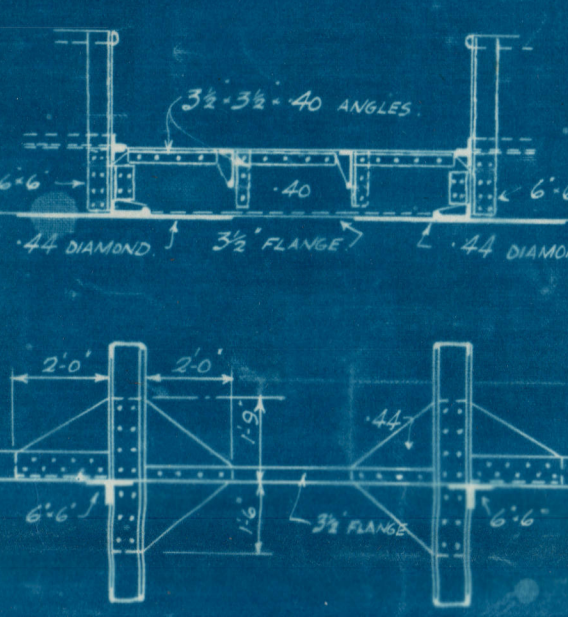


# SS. NO 573 PROFILE

389'-0" BP - 55'-8 1/2" BPD MID - 25'-4" DTD MID 2ND DK  
COMPLETE SUPERSTRUCTURE TYPE  
CLASS 100A1 LLOYDS  
SCALE 3/8" = 1' FOOT


SECTION AT NO 96 HATCH END ON 2ND DK  
IN WAY OF WT BND

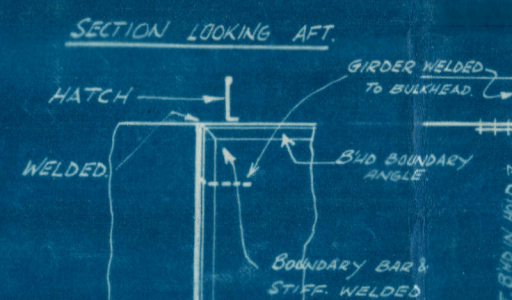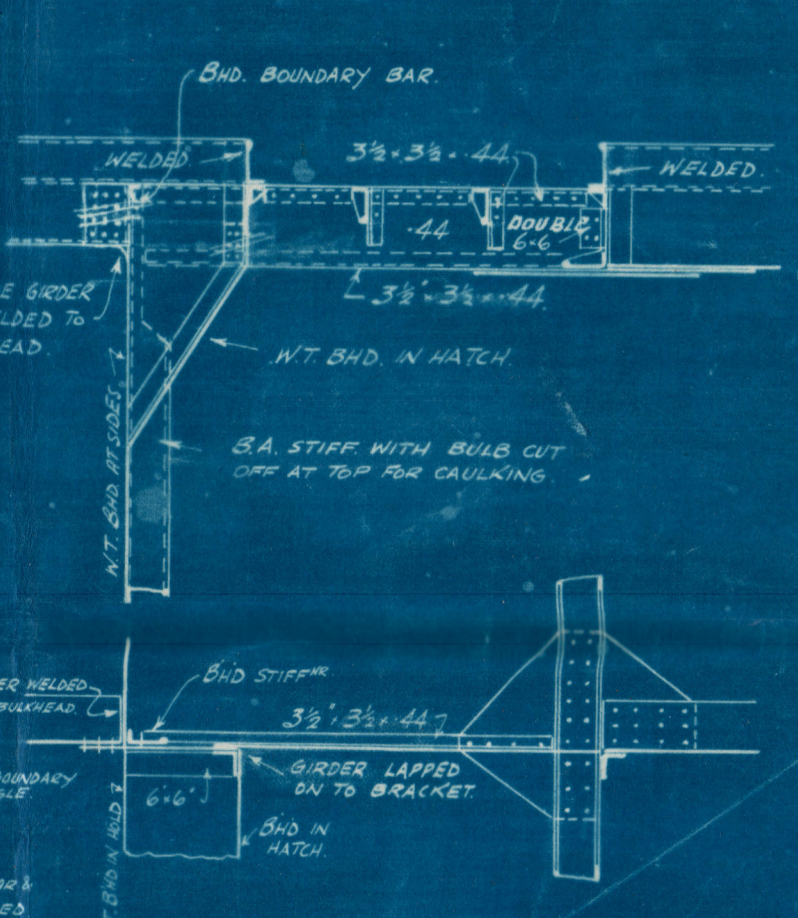


SECTION SHOWING 2 BND  
STIFFS AT HATCH ENDS  
IN HOLDS

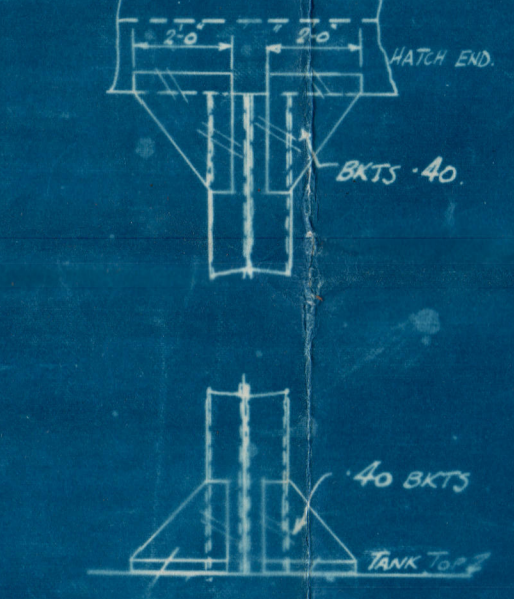


SECTION SHOWING 2 BND  
STIFFS AT HATCH ENDS  
IN TWEEN DECK

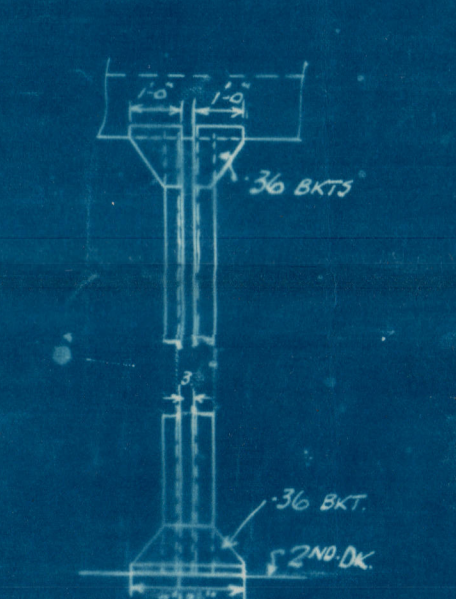


NO 7 HATCH SIDES ON UPPER DECK

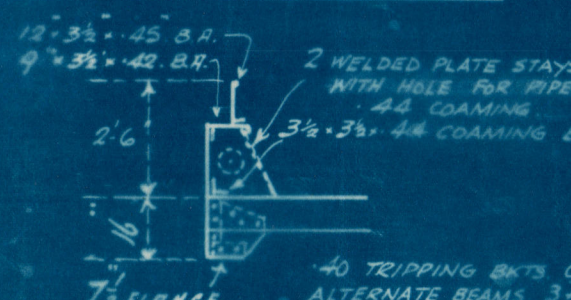


NO 2 & 3 HATCH SIDES ON UPPER DECK

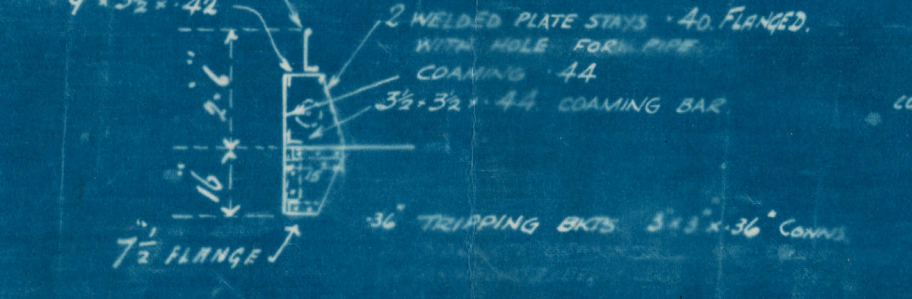


HATCH ENDS UPPER DECK

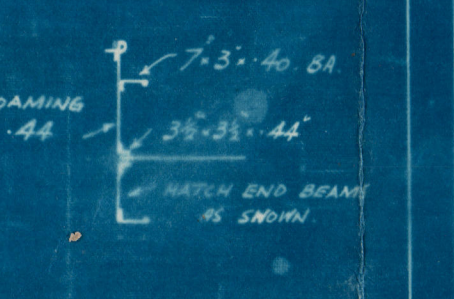

NO 4 HATCH SIDE UPPER DECK

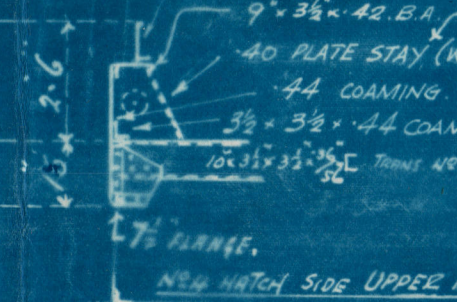

NO 5 HATCH SIDE UPPER DECK

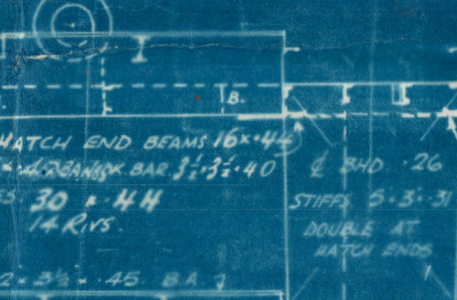

NOTE: NO CEMENT IN DOUBLE BOTTOM TANKS

THIRD DECK FRAMES IN  
IN TANK 61-35-45-50-55-10880-10885



W1153-0067

SUNDERLAND.

Messrs. J. L. Thompson & Son Ltd

No 573.  
+ "St. Helena" +  
SLD. 31859.

Profile.  
(as built)



RETAIN



© 2020

Lloyd's Register  
Foundation