

SUNDERLAND

Messrs Osbourne Graham & Co


PROFILE AND DECK PLAN  
(AS BUILT)

No 245

S.S. S.N.A.7

SUNDERLAND NO. 28362

REMAIN

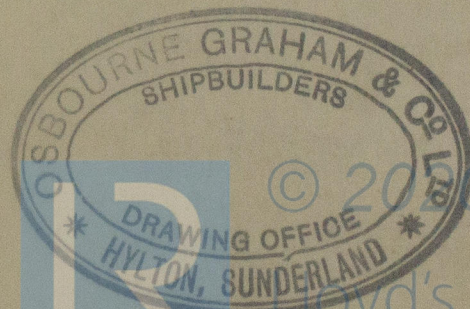

Lloyd's Register  
Foundation

W155-0049