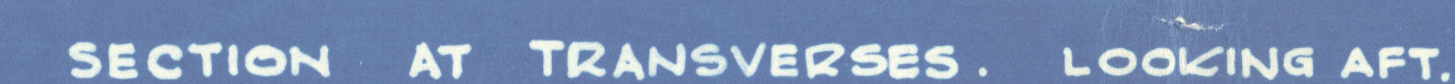


SCALE :- 1/2" = ONE FOOT.

OIL TANKS TO BE SPECIALLY CONSIDERED.

$$\frac{L/D}{460/34.} = 13.52$$


3 BOWER ANCHORS 73.16 CWT'S EACH STOCKLESS.
1 STEAM ANCHOR 22 CWT'S. (EX. STOCK)
300 FATHOMS 2 7/16" STUD LINK CHAIN CABLE.
TWO SPARE ANCHOR AND TWO CABLE SHACKLES.
ONE BOX PINS AND PUNCHES AND ONE SHACKLE PUNCH.
120 FATHOMS 5" (9/16) CIRC WIRE STEAM. } + 1/2" (OWNERS' SPECIFICATION.)
120 " 5 1/4" (9/16) " " TON LNS.
2 @ 100 FATHOMS 2 3/4" (9/16) " " HAWSEYS
2 @ 100 " 2 3/4" (9/16) " " WARPS
ALL WIRES TO BE ON REELS. ALL REELS TO TAKE WIRES 1/2" ABOVE
SIZES SUPPLIED. REELS FOR LARGE WIRES DOUBLE PURCHASE.

HARLAND & WOLFF LTD.
BELFAST

No. 1014 CAIRNDALE

TITLE. Midship Section
(as Built)

DATE APPROVED. ✓

RETAIN



© 2020

Lloyd's Register
Foundation

W1161-0192