

MIDSHIP SECTION

DIMENSIONS: 460'-0" B.P. x 61'-0" MLD. x 33'-3" MLD. TO UPPER D.K.

SCALE: 1/2" = 1 FOOT

LLOYD'S NUMERALS


1st Longitudinal Nº L x D 460'-0" x 33'-25" = 15295.00
 2nd " " L x (B+D) 460'-0" x (61'-0" + 33'-25") = 43355.00
 1/2 to Upper Deck = 460'-0" ÷ 33'-25" = 13.83
 D = 33.25

2nd Long' Nº L (B+D) = 43355.00
 Poop 108' 33" x 7.5' 3/4" = 592.59
 Bridge 43' 16" x 7.5' 3/4" = 248.70
 Forecastle 38' 5" x 7.5' 3/4" = 216.51
 House on Poop Deck 82' 5" x 7.5' 3/4" = 509
 House " Bridge " 120' x 7.5' 3/4" = 450
 Equipment Nº 43165.77

To Class 100A.1 at Lloyds carrying Petroleum in Bulk.
 "Longitudinal Framing at Bottom and at Deck."

2 Bower Anchors 73/4 Cwts Each Stockless.
 1 Stream " 22 " Ex Stock
 240 Fathoms 2/8 Stud Chain Cable (Tayco)
 120 " 5 Flexible Steel Wire 6x12
 150 " 5/8 Special Flexible Steel Wire 6x24
 2 Hawsers 100 Fathoms 2 1/4 Steel Wire 6x12
 2 Warps 100 " 2 1/4 " " 6x12

Long' Bnd N°1 After Tank	Shear at Cr. of Tank Plating	Stiffers
Nº2 to 6	1-1" as on Plan	+ .01"
" 7 "	1-2 1/8	+ .01"
" 8 "	2-9"	+ .01"
" 9 "	4-2"	+ .02"

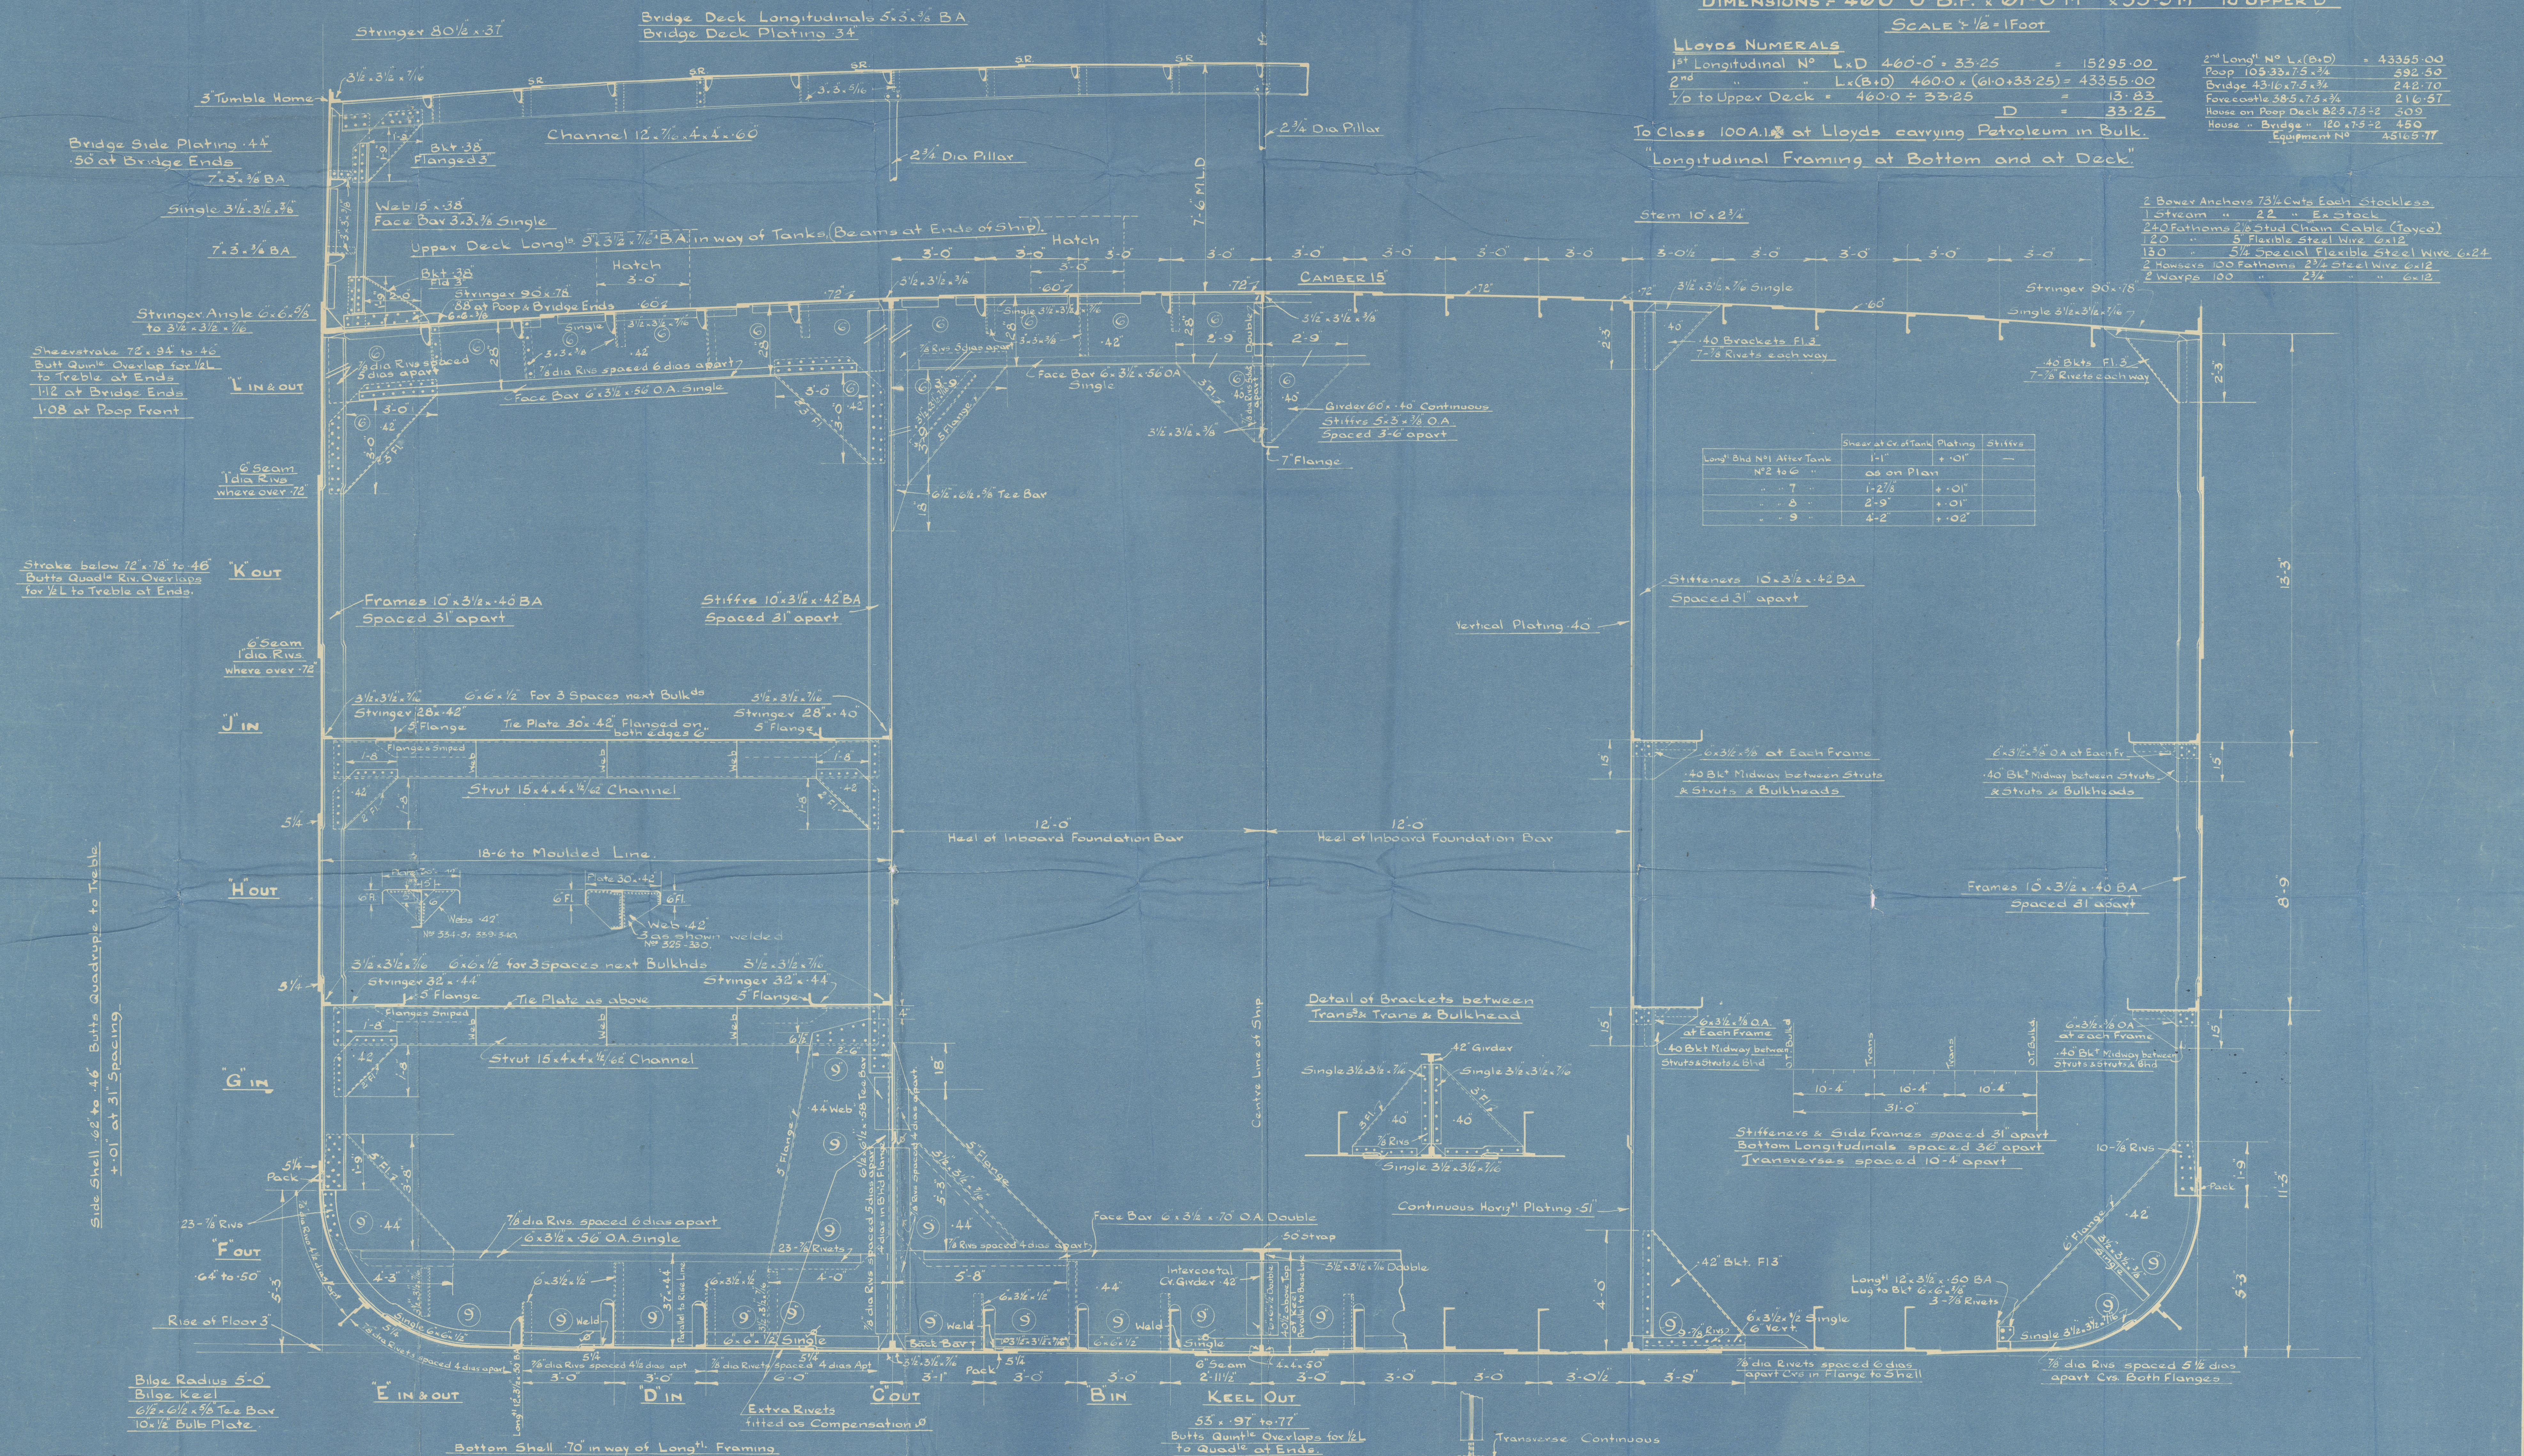

S/S. EMPIRE CELT.

FURNESS. S.B.C. L.

Nº 335

MIDSHIP SECTION

AS BUILT.

REMAIN
REMAIN
REMAIN



© 2020

Lloyd's Register
Foundation

W1161-0063