

N^o 183

MIDSHIP SECTION

DIMNS. - 135'-0" x 24'-6" x 10'-0" MID.

SCALE 1/2" = 1'

TO CLASS 100-A1 AT LLOYDS

L x D - 1350

L x (B+D) - 4660

L/D - 13.5

L/D AT DR DX - 10.

EQUIPMENT

L x (B+D) - 4660

DR. DECK 81'-3.5" - 284

FORECASTLE 18'-7 x 75 94

BRIDGE 10'-7 x 75 53

ATT. HOUSE 26'-7 x 5 91

5182

2 BOWER ANCHORS 8 1/4 CWT EA. STOCKLESS

1 STEAM ANCHOR 23 1/2 CWT. E x STOCK

165 FMS. 15/16" STUD LINK CABLE

AS - 2 1/4" STEEL WIRE ROPE

75 - 2 1/2" " " "

90 - 1 3/4" " " "

RIVETING

SHELL BUTTS & SEAMS DR THROUGHOUT



STRINGER BUTTS DR THROUGHOUT

CENTRE GIRDER BUTTS DR

HEEL BUTTS TR. TO DR AT ENDS

SHEERSTAKE AT BREAK TR. TO DR

RIVETS 3/4" DIA.

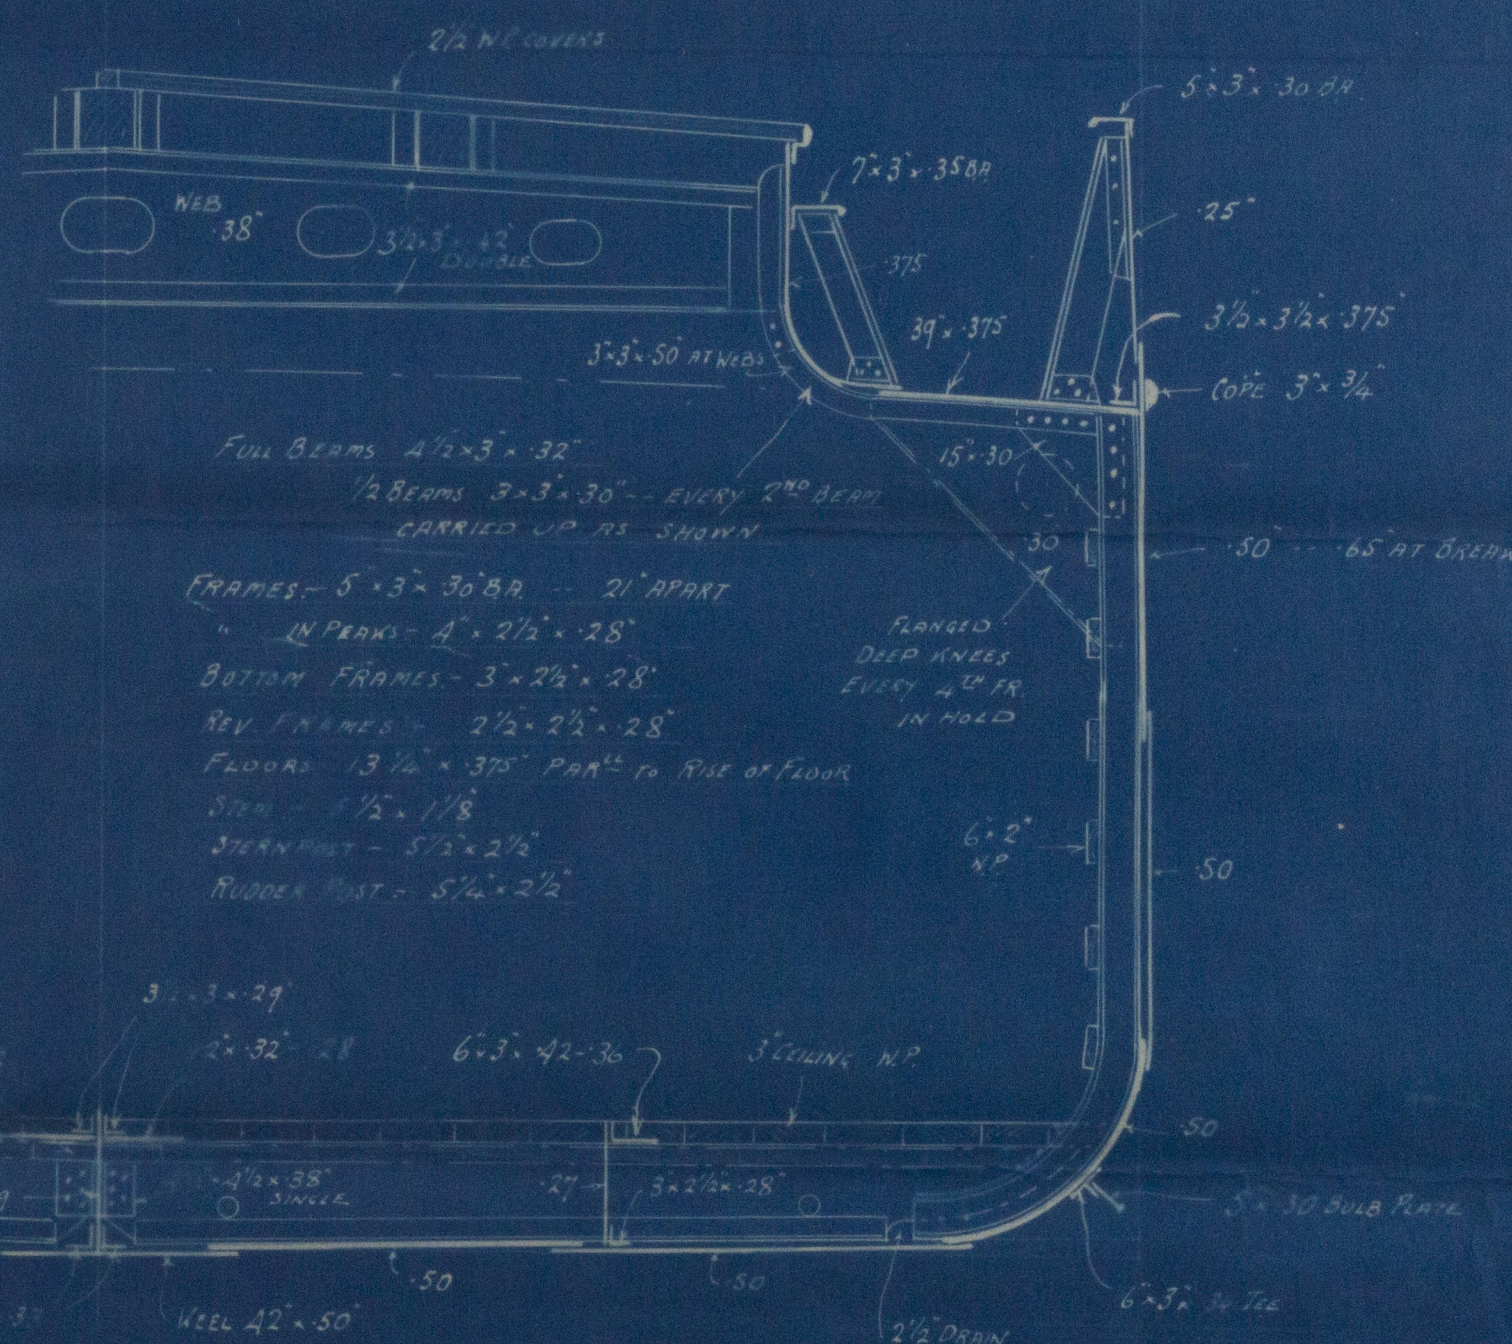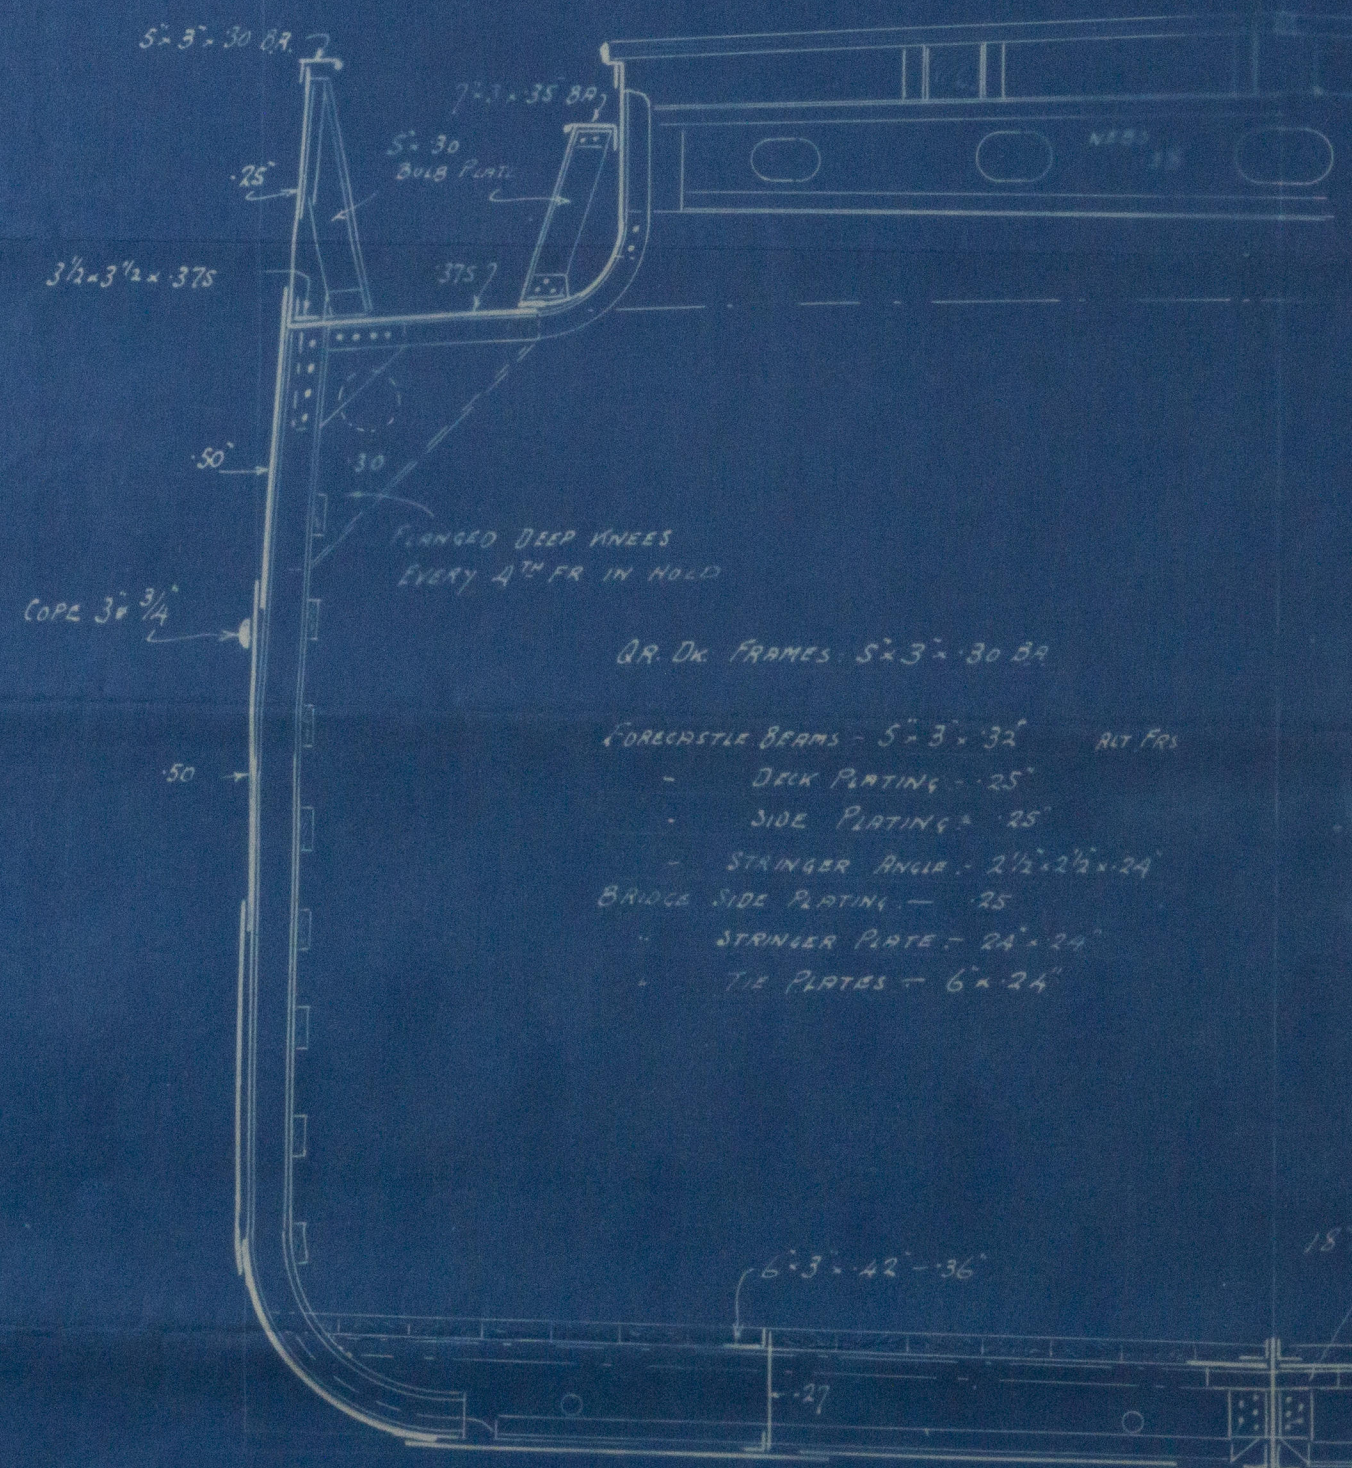

1176
3/3/38

W1180-6012

MIDSHIP SECTION

(AS BUILT).

GEORGE BROWN & Co's

Nº 183.

M.V. "ACTUOSITY"

GRK. FIRST ENTRY REPORT Nº 19516.

RETAIN

© 2020

Lloyd's Register

Foundation
W1180-0022