

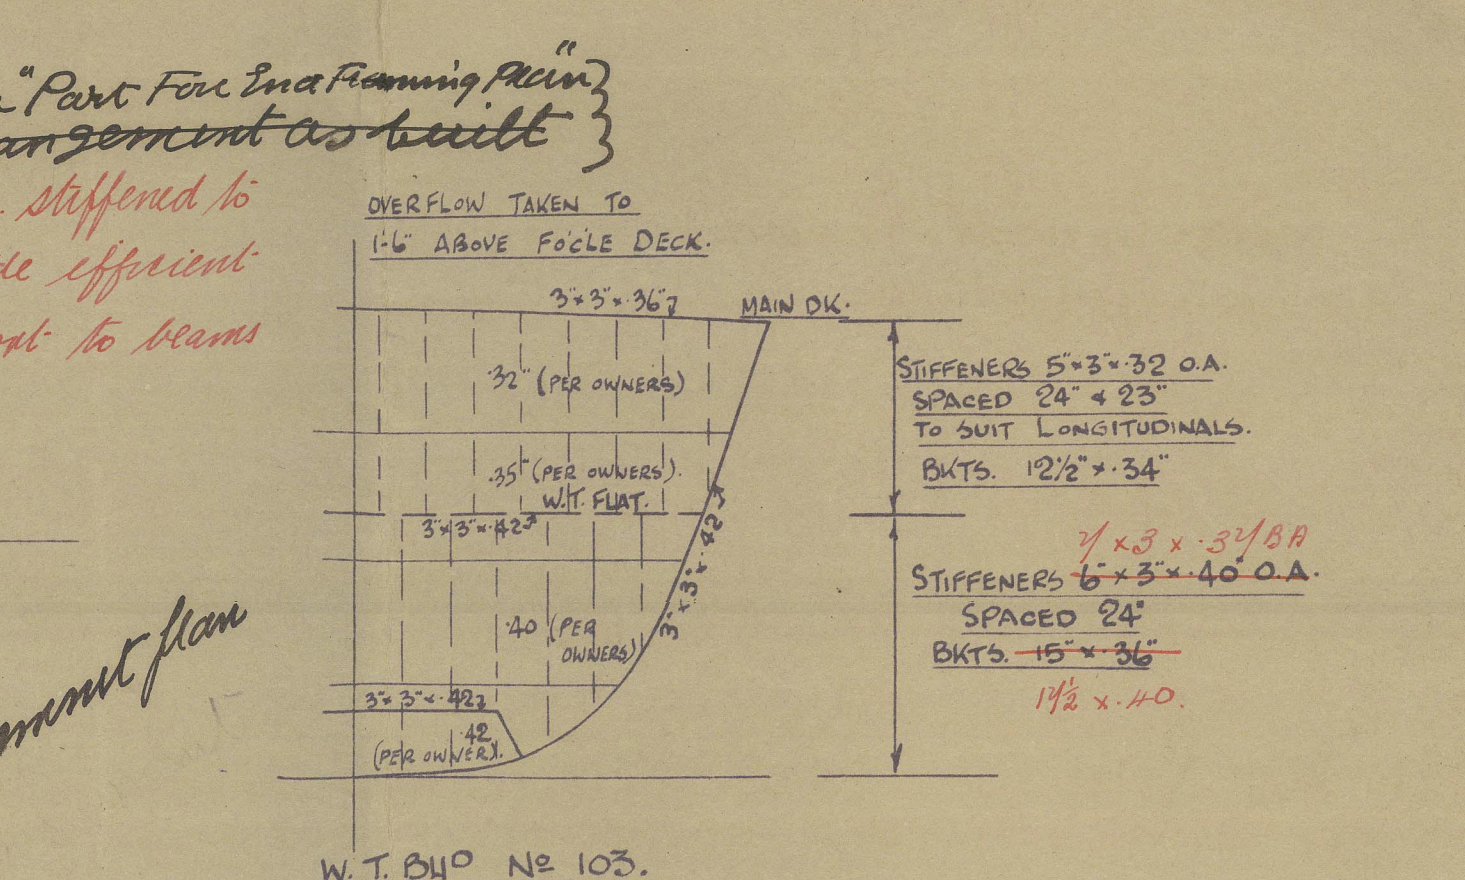


No 245.
PROFILE, DECKS & BULKHEADS (See Framing Profile as built)
DIMS: ~ 235'-0" x 45'-0" x 15'-6" MOULDED.
SCALE 1/8" = 1 FOOT.
TO CLASS LLOYD'S 100. A.I. WITH FREEBOARD
CORRESPONDING TO SUMMER MLD DRAFT OF 12'-0"

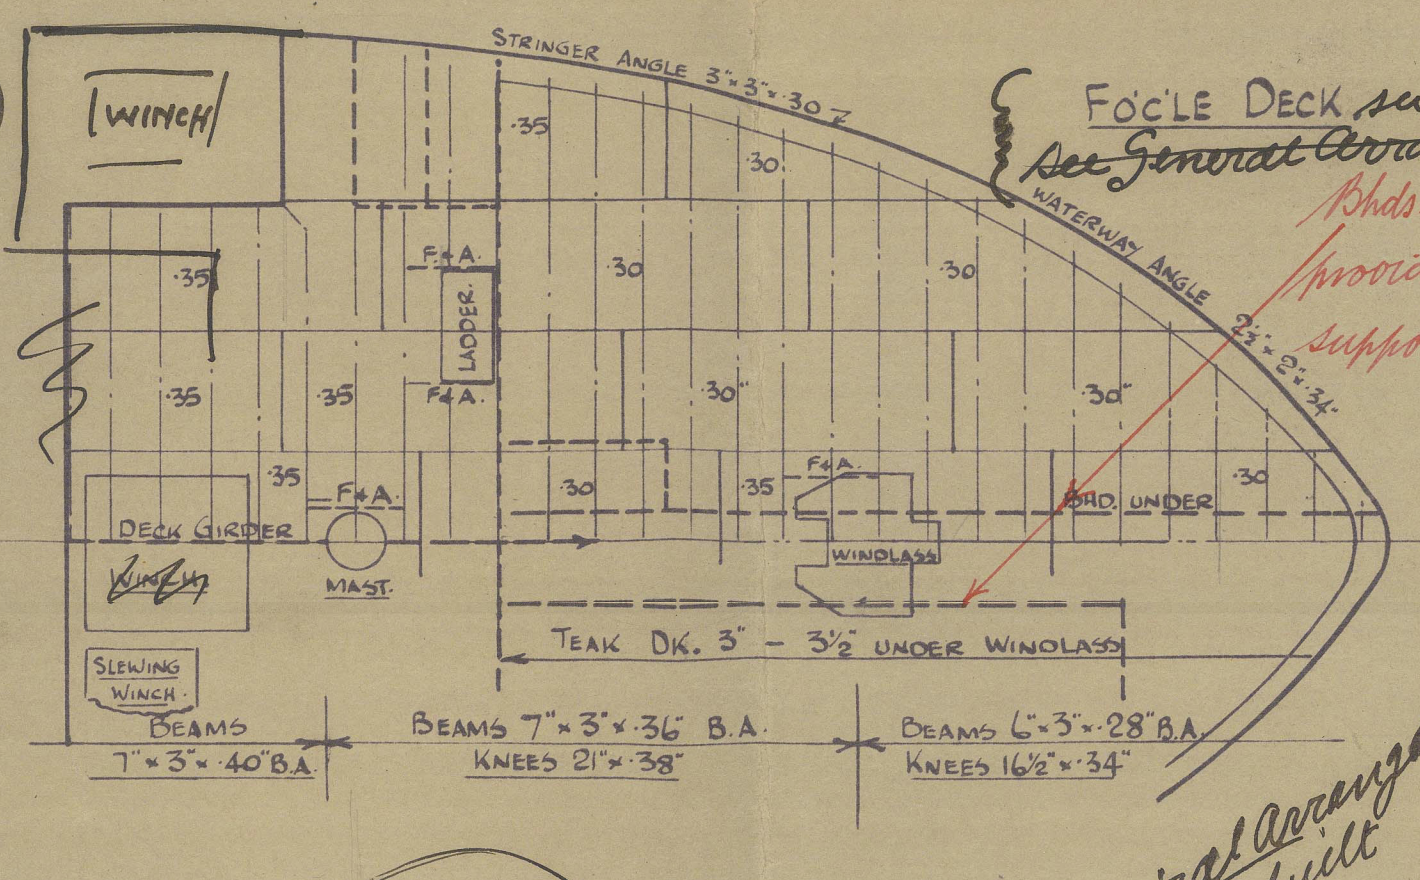

DRAWING No 245.

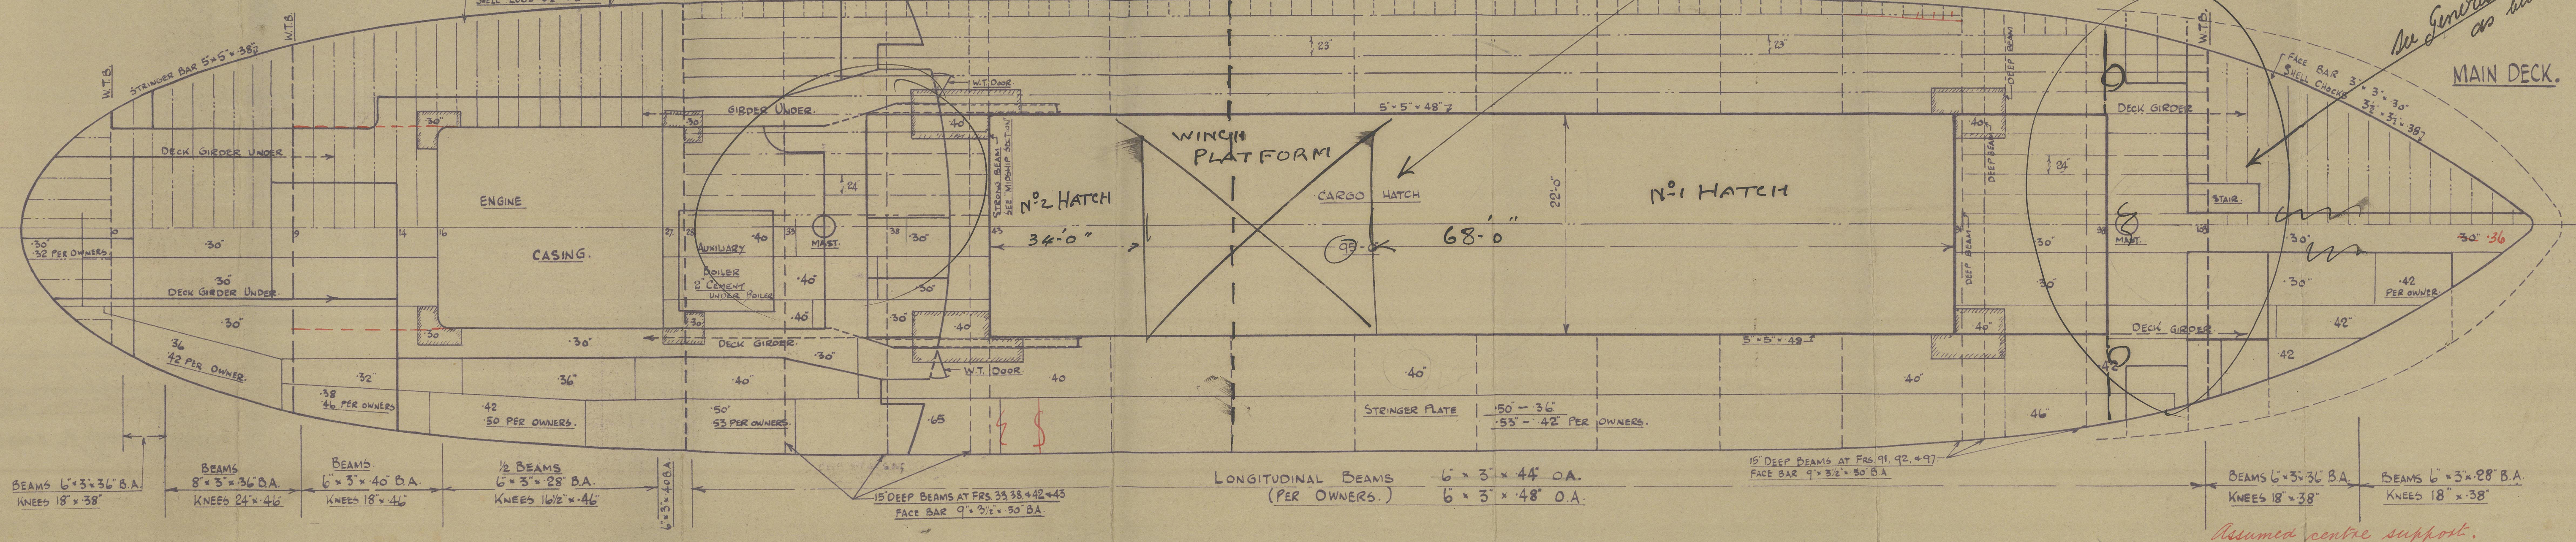

APPROVED
LLOYD'S REGISTER OF SHIPPING
3-3-37
DATE

Henry Robt & Co
No 245

Profile, Decks & Bulkheads

(For Vessel as built see Hatch Plan
and plan of General Arrangement)
& For & Lifting Plans

M. N. "Kahika"

Lith. Rpt. No. 19509



© 2021

Lloyd's Register
Foundation