


S.S. "NIOBÉ".

SCALE $\frac{1}{8}'' = 1 \text{ FT}$

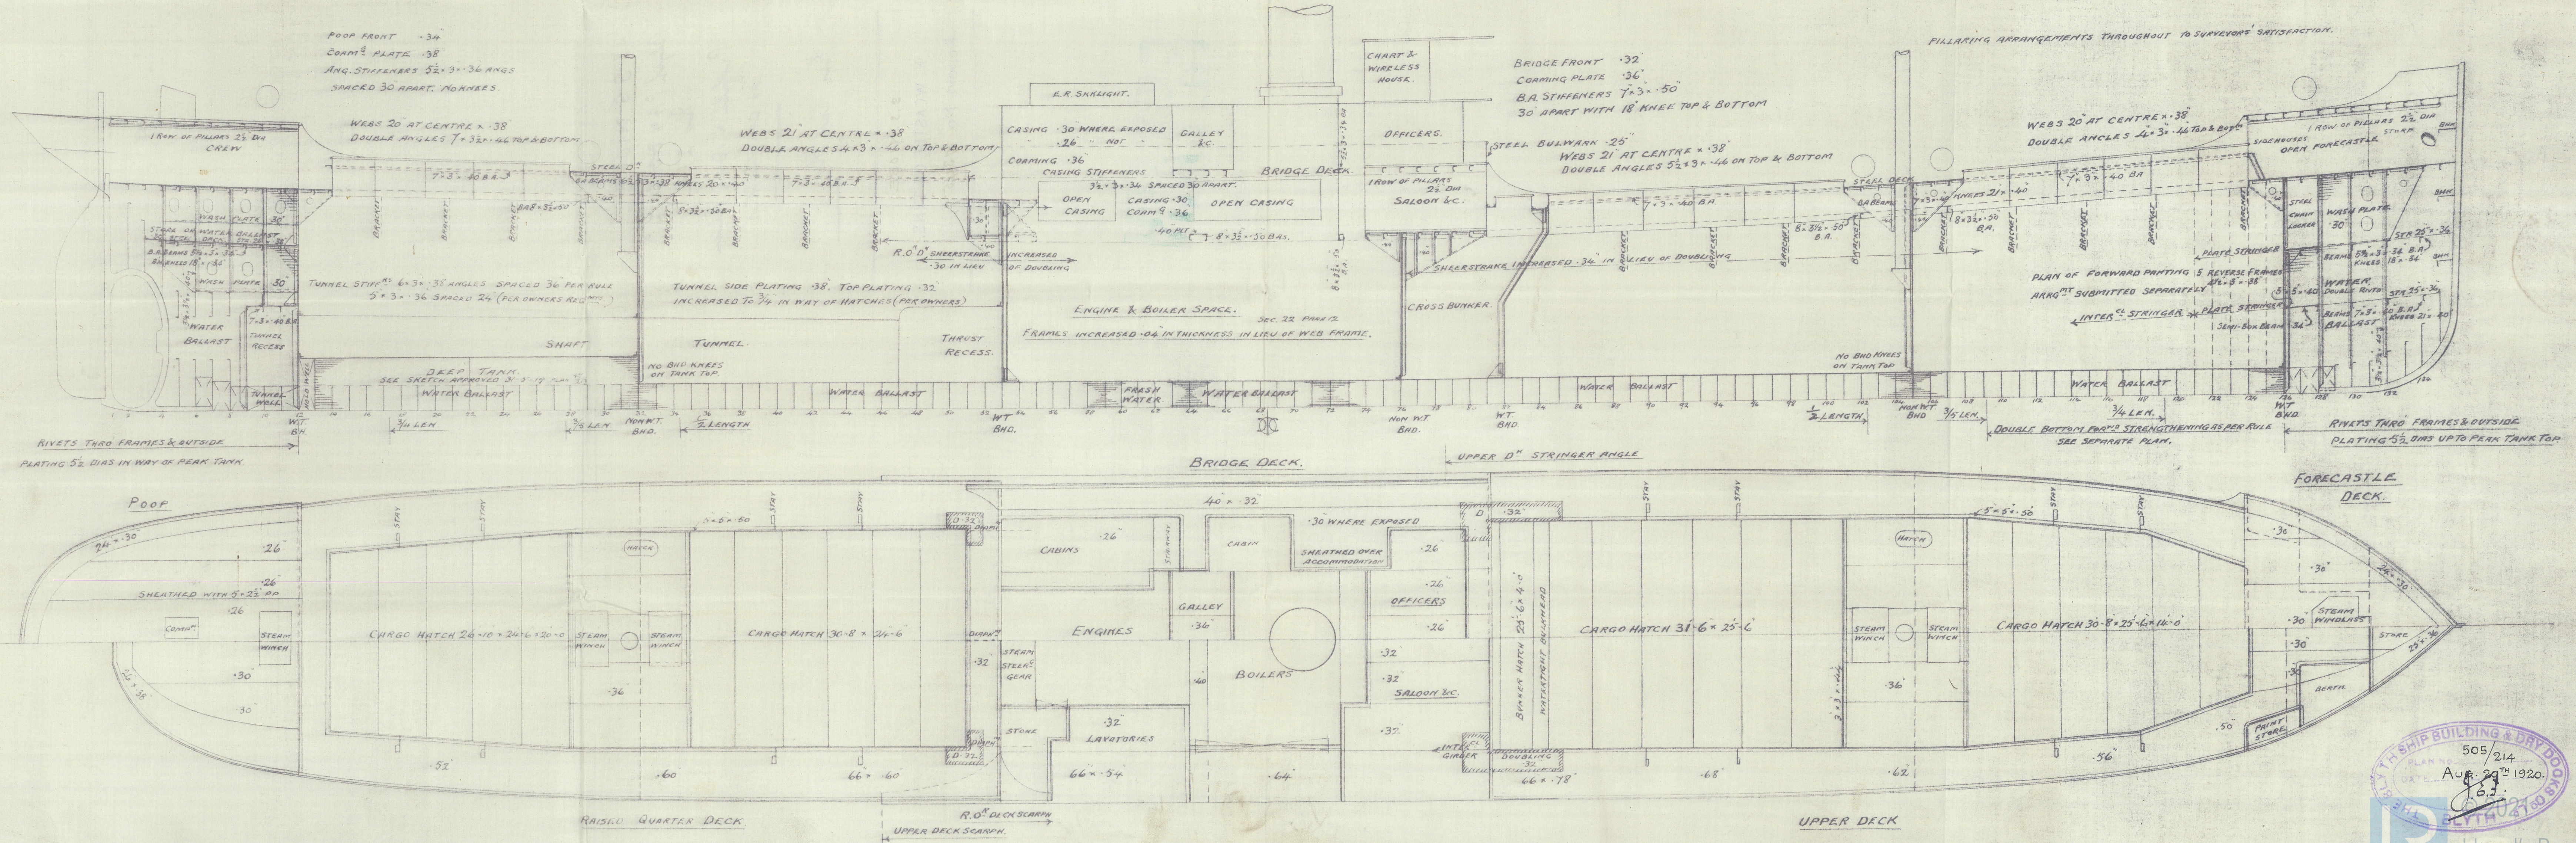

S S NIOBE

Blyth PB 4 88 Co 29

No 214

Profile & Deck Plan
as constructed

Am Apt No

S.S. NIOBE.

NEWCASTLE ON TYNE.

Report No. 73457.

