


# MIDSHIP SECTION

## SECTION IN WAY OF BOILERS

MARGIN PLATE . . .  
IN BOILER SPACE

№ 941

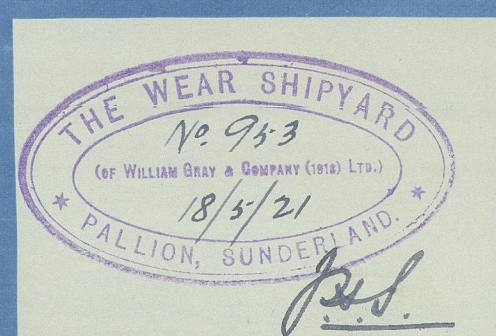

№ 941



SUNDERLAND  
THE WEAR SHIPYARD

MIDSHIP SECTION  
(AS BUILT)

No 941

S.S. "NAGINA"

SUNDERLAND RPT. NO. 28161.

RETAIN



© 2021

Lloyd's Register

W1200-0194