


S.S. N<sup>o</sup> 48.

LONGITUDINAL SECTION W.T. BULKHEADS PANTING ARRANGEMENT  
DEEP TANKS STRENGTHENING OF BOTTOM FORWARD

BULKHEAD N<sup>o</sup> 55

DIMENSIONS: 306.0 B.P. x 45.0 M.P. x 24.3 M.P. TO UPPER DECK  
TO CLASH AT LLOYDS 100 A.I. WITH FREEBOARD  
SCALE 1/8" = 1 FOOT

NO SHEER ON FREEBOARD DECK EXCEPT THAT DUE TO 11 CAMBER  
MINIMUM SCANTLING REQUIRED  
MAXIMUM DEPTH = 19'-8"

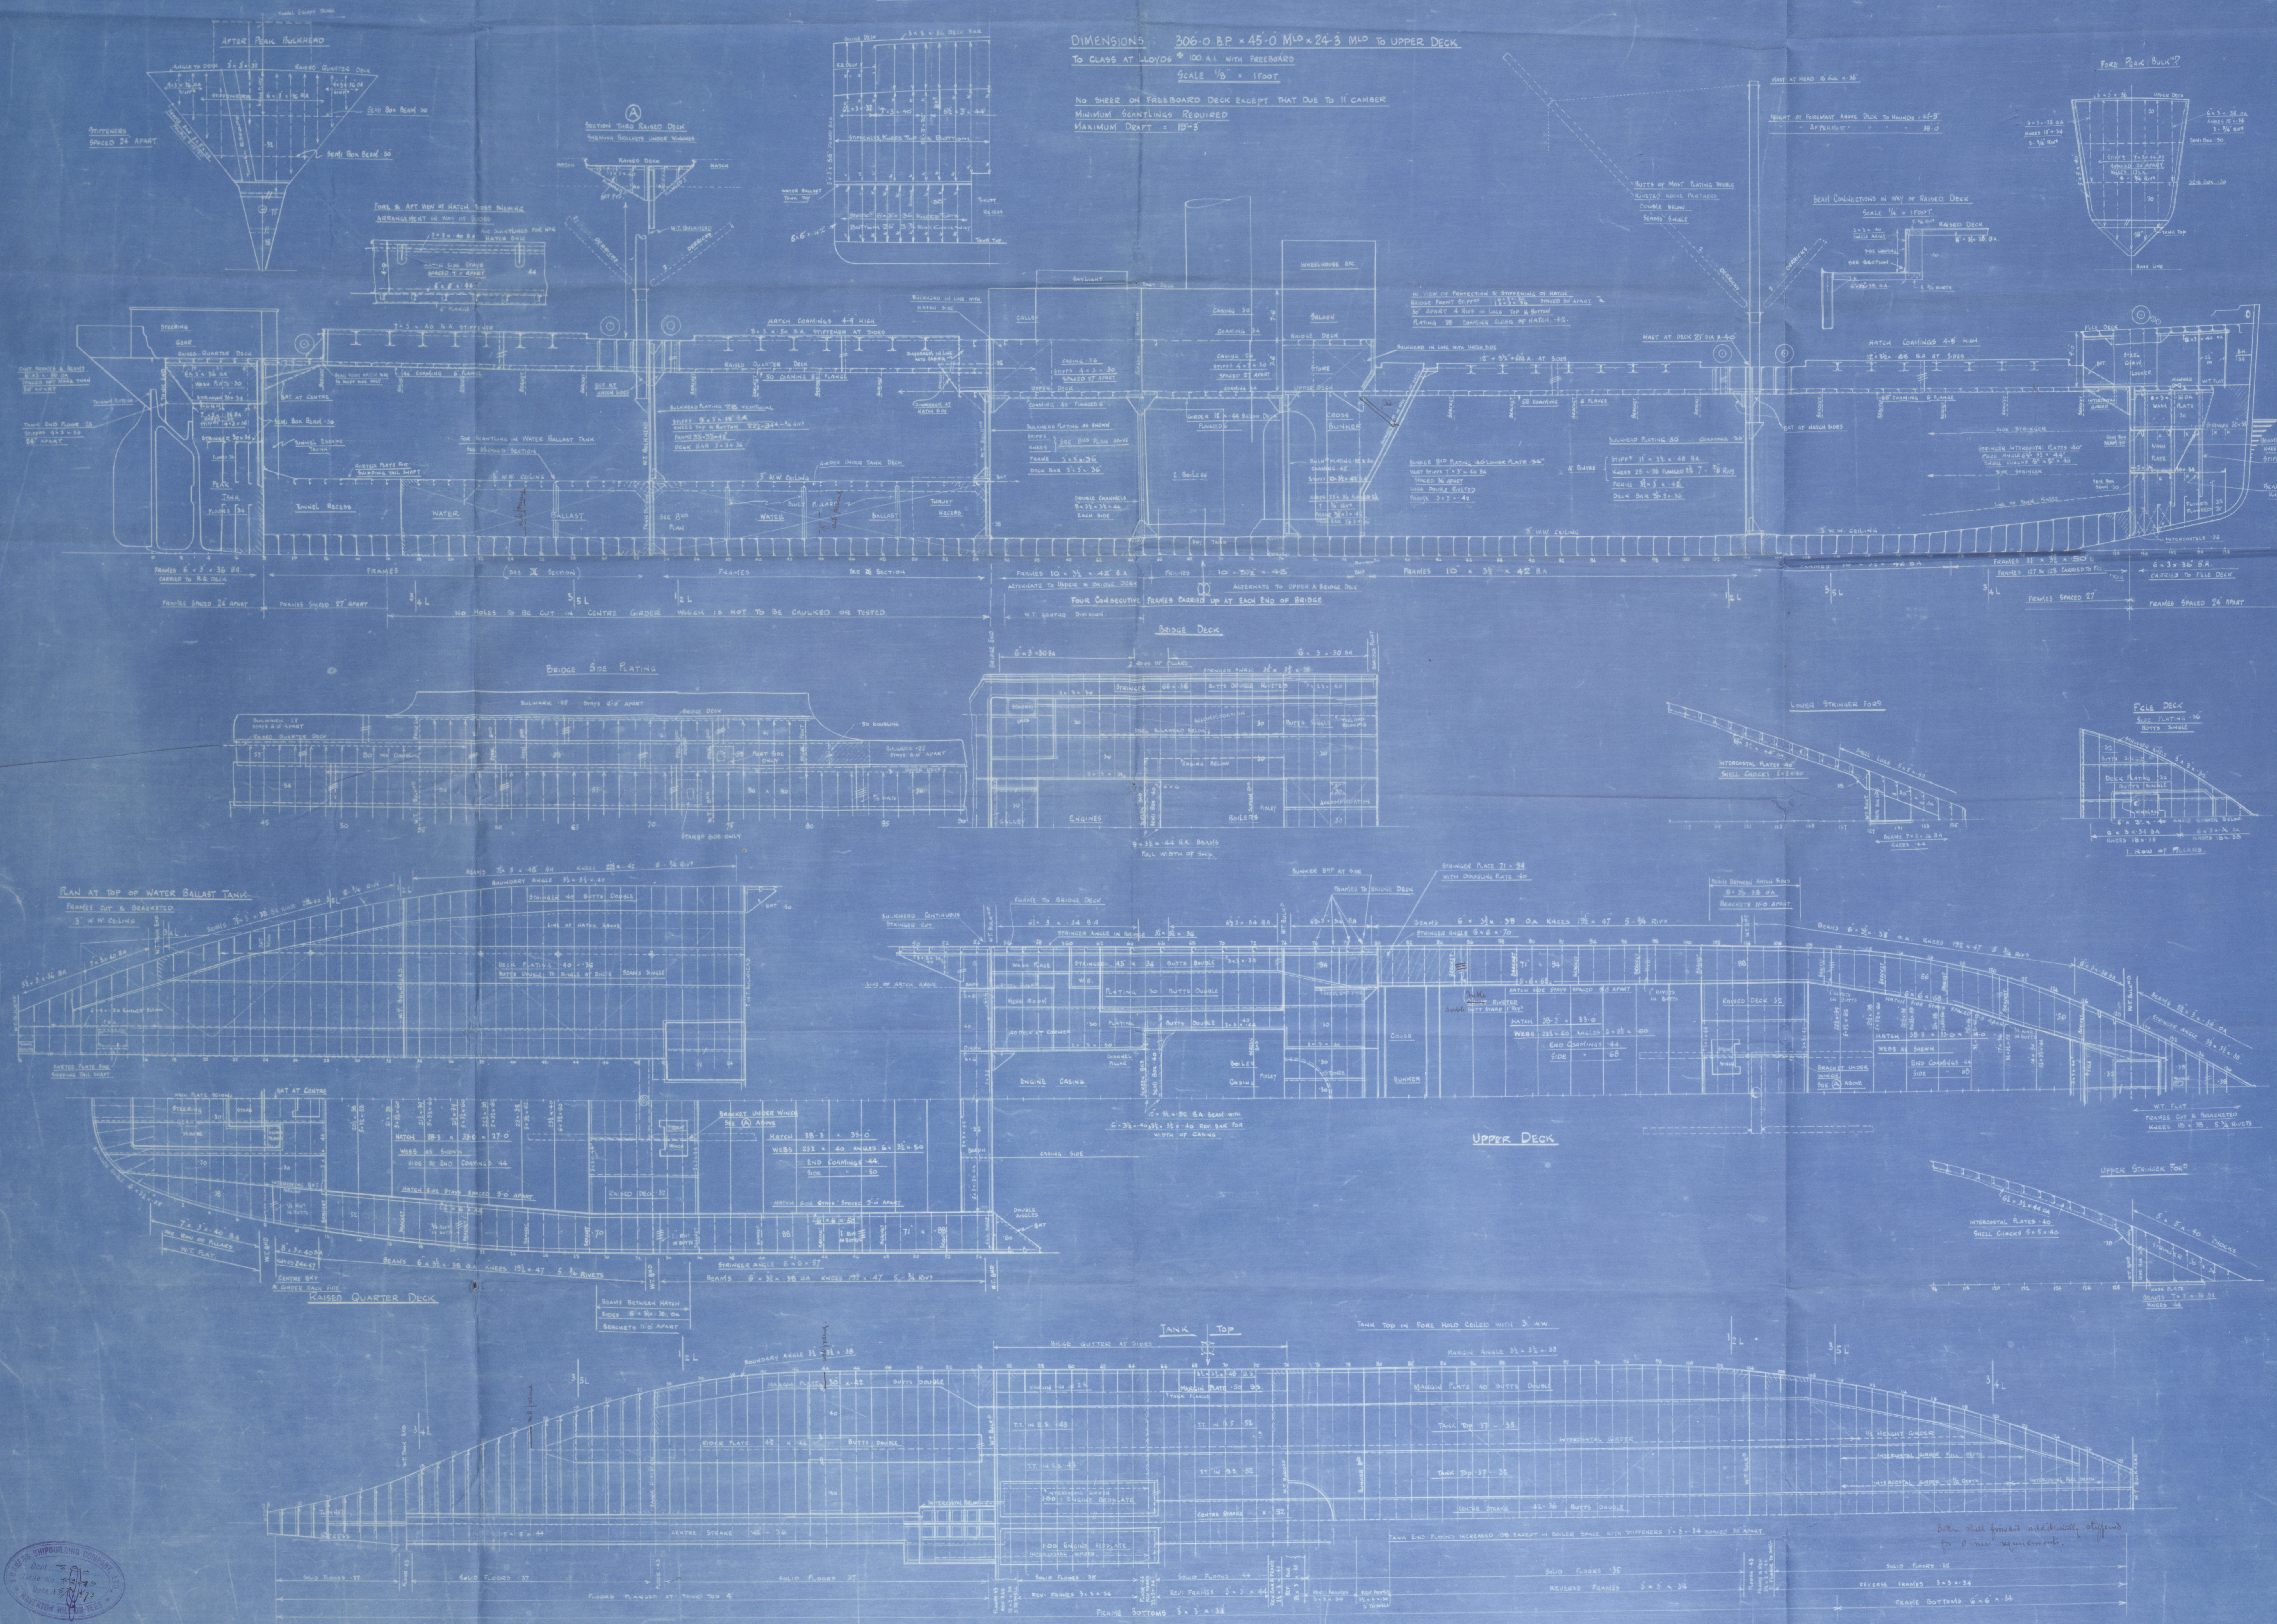



W1217-0276

Furness Ship Co. No. 48

Profile and Decks.

as Built

S.S. "ELDON" "AMUR"  
Ex

MIDDLESBROUGH

Report No. 11751.

D 106.B.

D.106.B