

No. 155

中央横截面圖

MIDSHIP SECTION

(FINISHED)

KOBEL WORKS
SUBSIDIARY ZOSSEN KAISHA, LTD.
SHIP DRAWING OFFICE

CHECKED BY

DRAWN BY

TRACED BY


ISSUE NO. 402353

DATE FEB 26 1920

C 2

SCALE 1/25

ALL AS PER PROFILE &
DECK PLAN

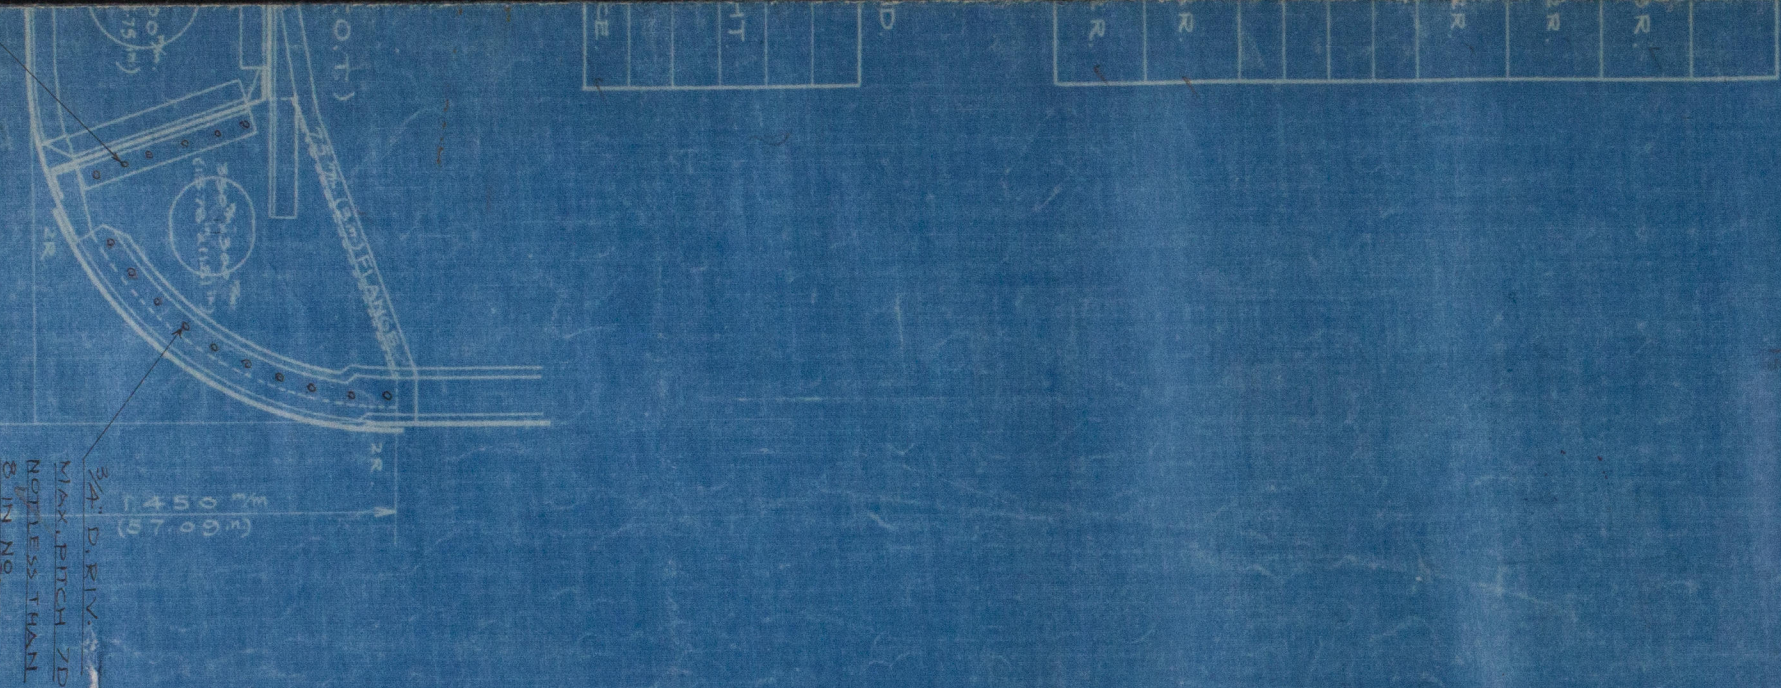

M.S. HINO MARU

Midship Section - as built

Kobe Report 6621.

W1220-0069



© 2020

Lloyd's Register
Foundation