

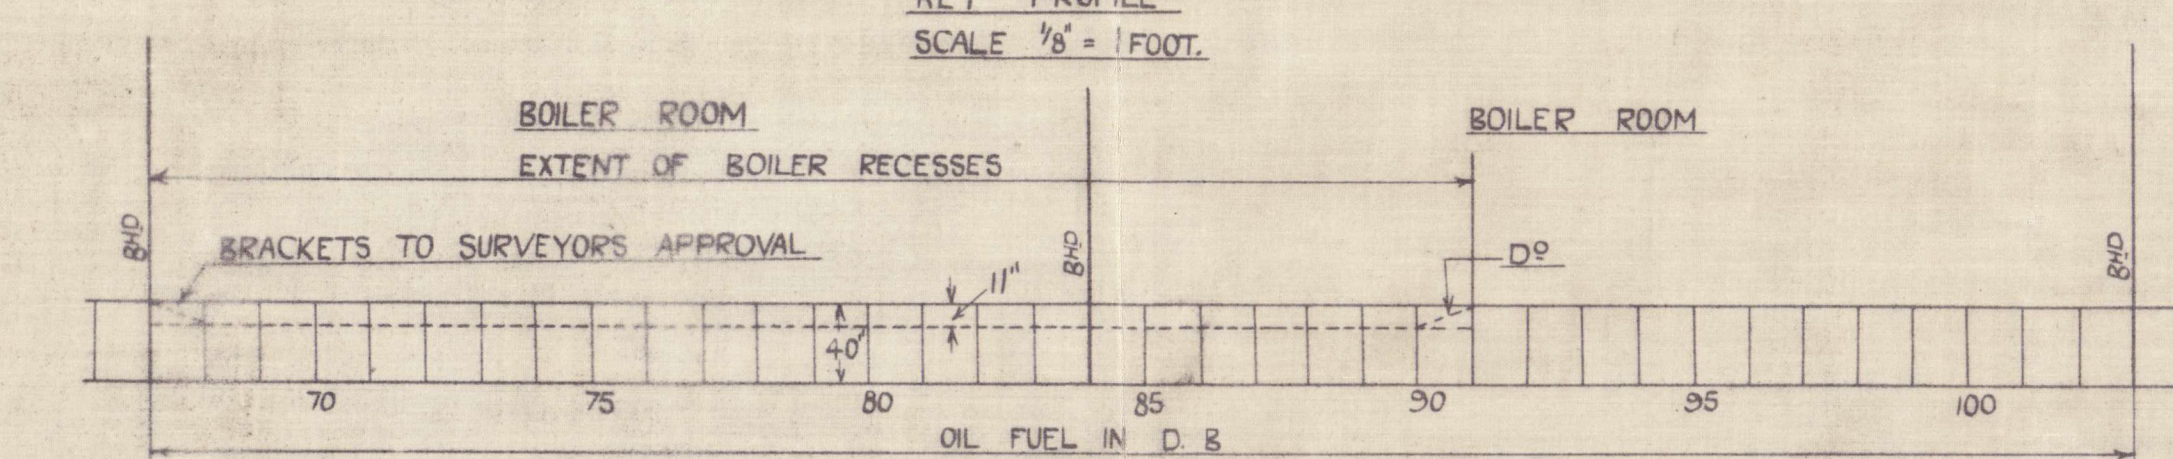
JOHN BROWN & COMPANY LIMITED  
SHIPBUILDING DEPARTMENT  
No 25670  
EXD BY  
DATE 10 MAR 1925  
GLYDE

TO LLOYDS CLASS 100 A1, WITH FREEBOARD.  
FOR CHANNEL AND SOUND SERVICE- SEATTLE AND SKAGWAY.

EQUIPMENT

RIVETING AS PER RULE.

KEY PROFILE  
SCALE 1/8" = 1 FOOT.

[illegible]



W1224-0254

*Midship Section  
as built*

*T. S. S. Princess Marguerite  
No 505-*

*& Kathleen*

GLASGOW REPORT No. 44501



© 2021

Lloyd's Register  
Foundation